


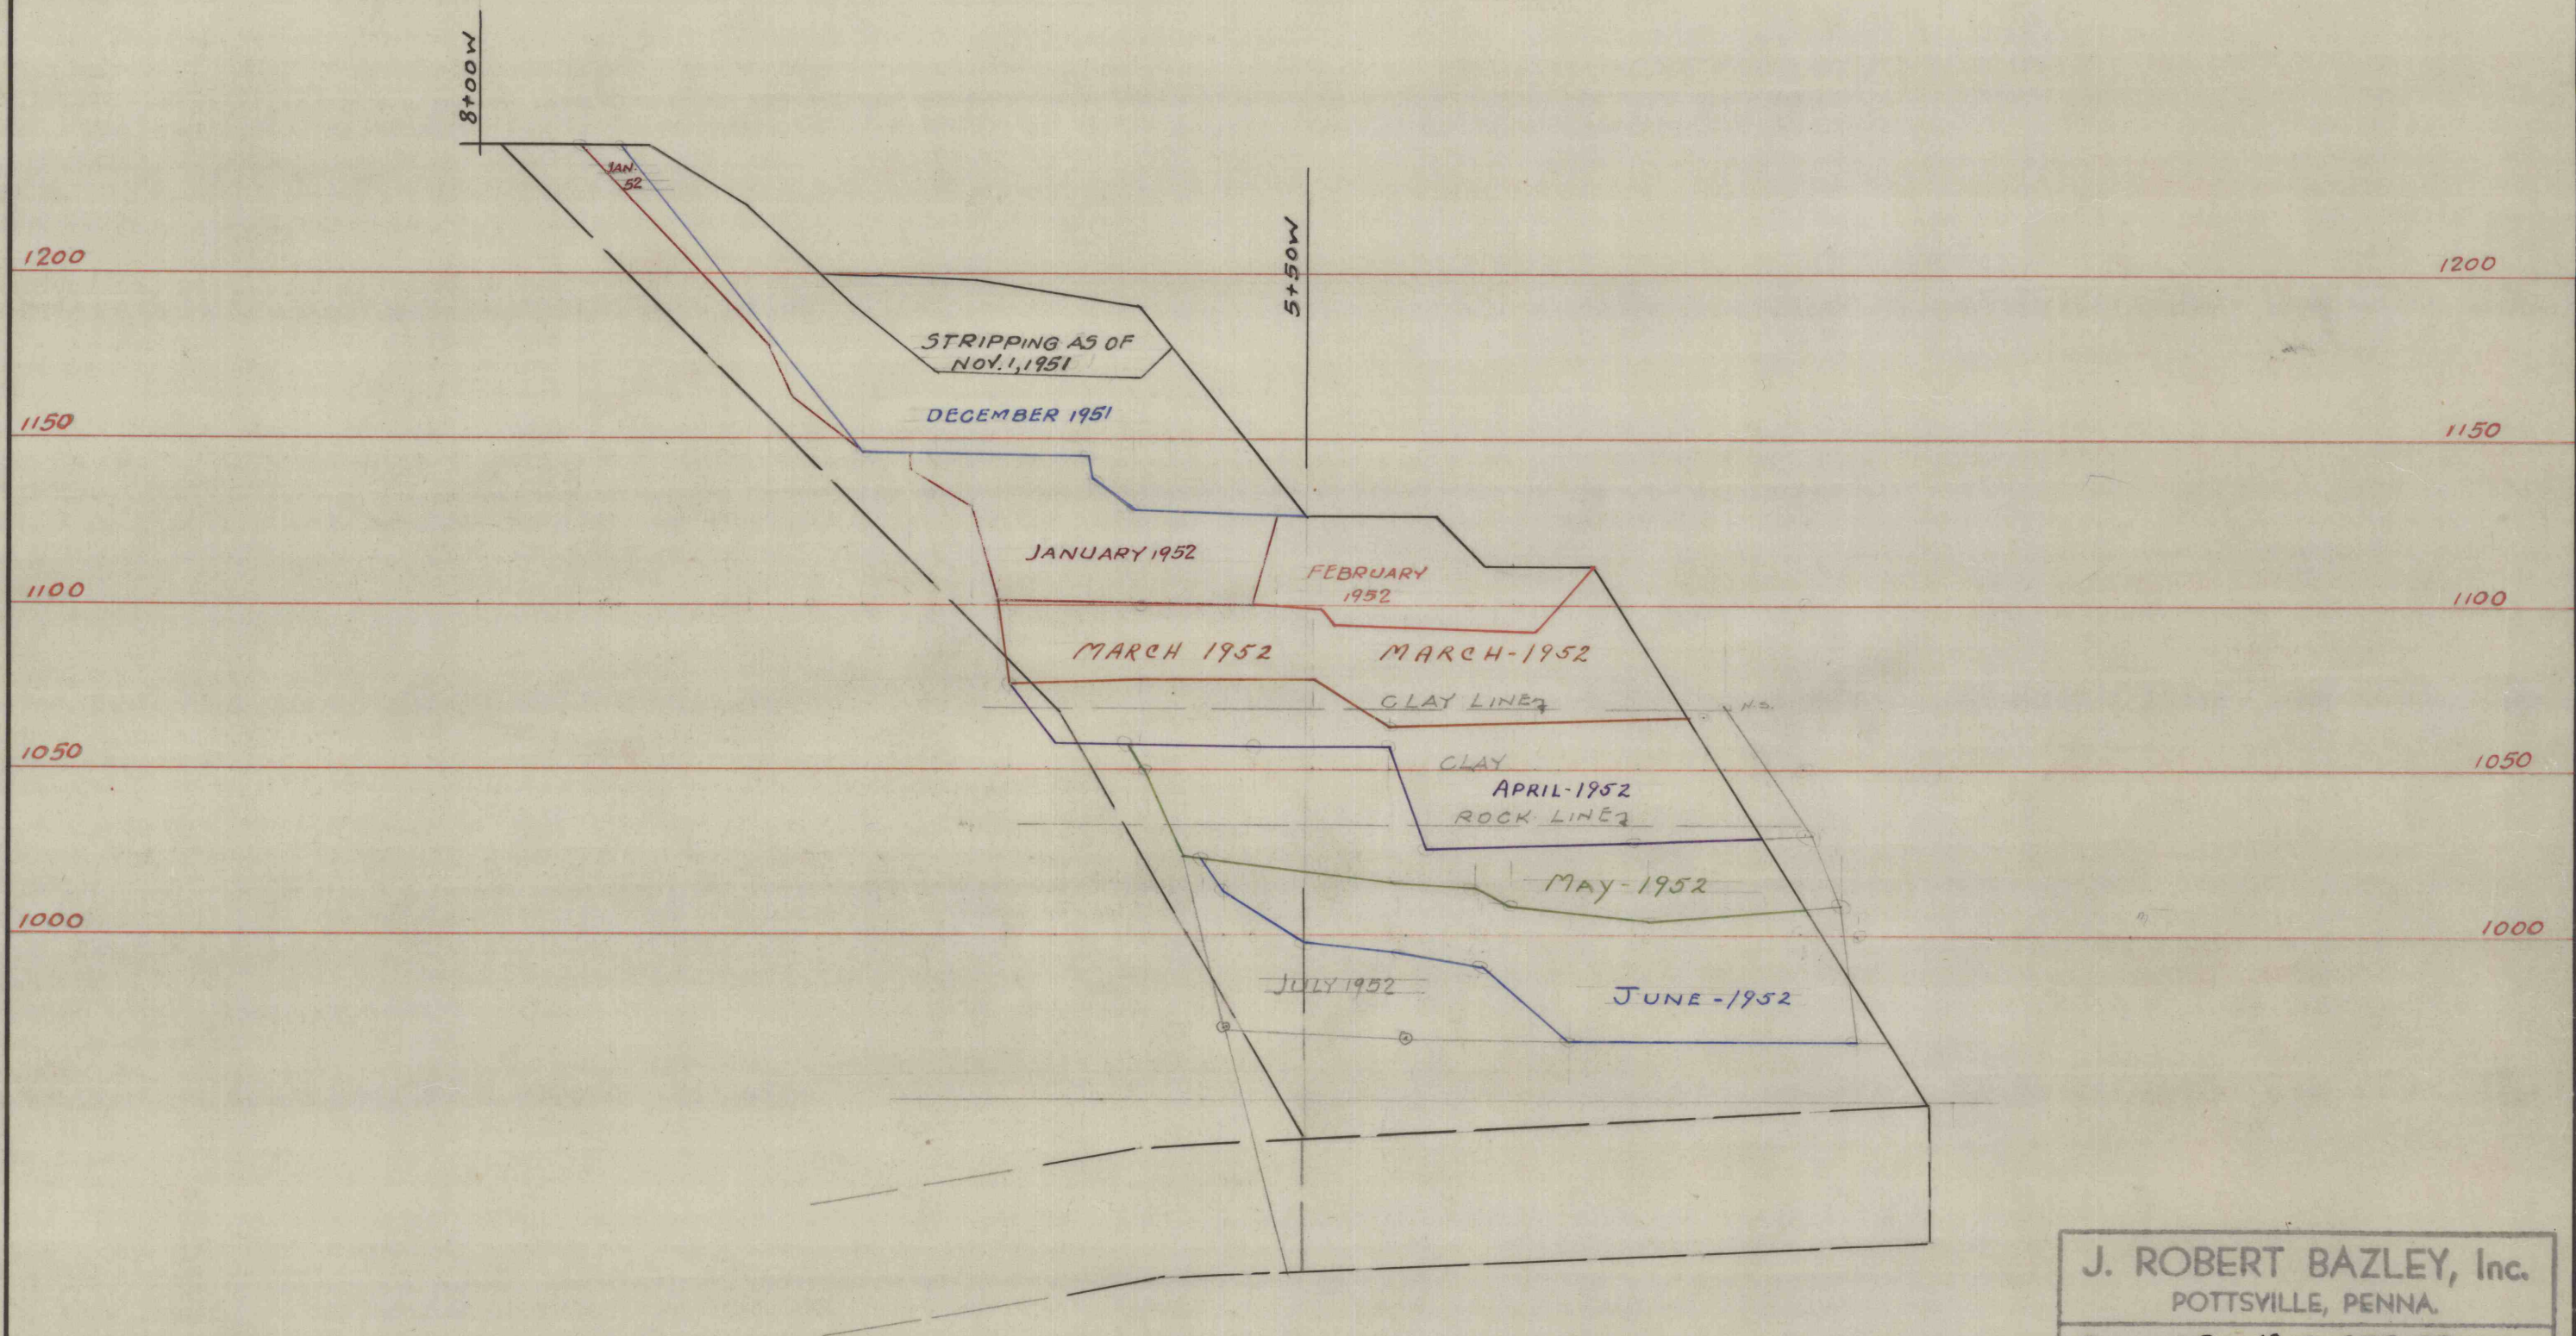

J. ROBERT BAZLEY, Inc.			
POTTSVILLE, PENNA.			
PACKER NO 10 STRIPPING			
WEST EXTENSION			
SECTION 3+00 SOUTH			
DATE	SCALE	BY	PROJECT
12-51	1"=50'		

1310-MT-JAT