


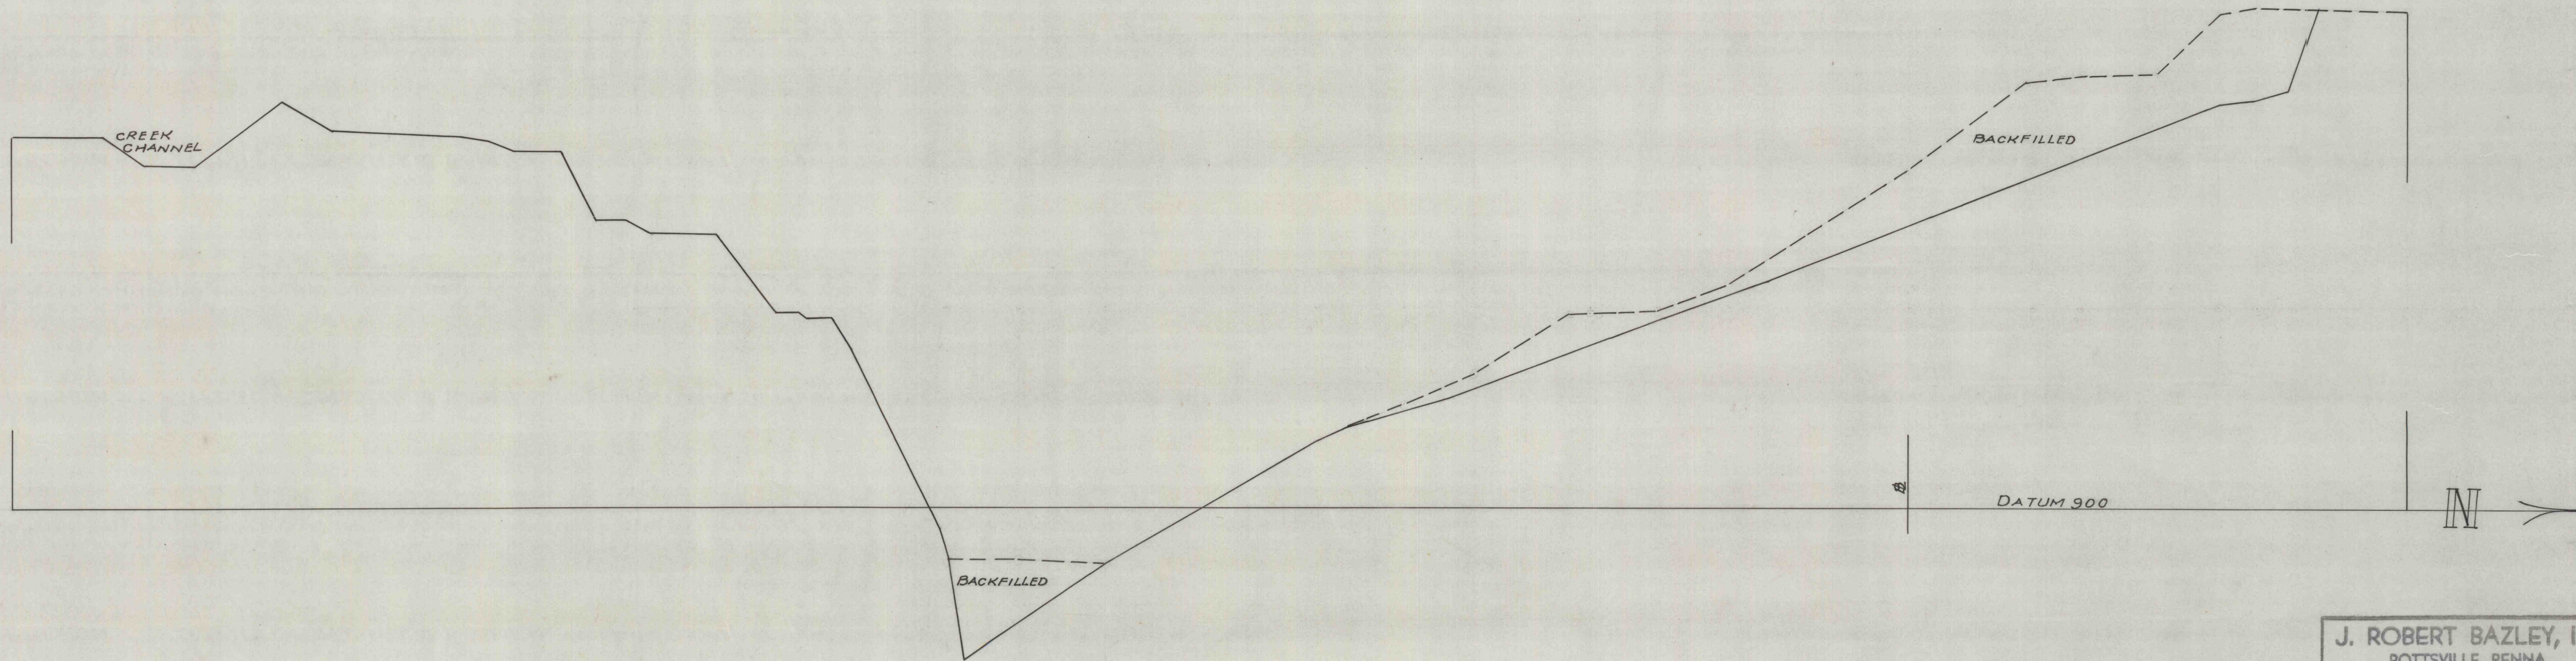

SECTION 0+00

J. ROBERT BAZLEY, Inc.			
POTTSVILLE, PENNA.			
PACKER #10 STR-SOUTH EXTN.			
TYPICAL SECTION			
SHOWING BACKFILL			
DATE	SCALE	BY	PROJ. NO.
7-8-52	1"=50'		G-42

IVF-7W-1312