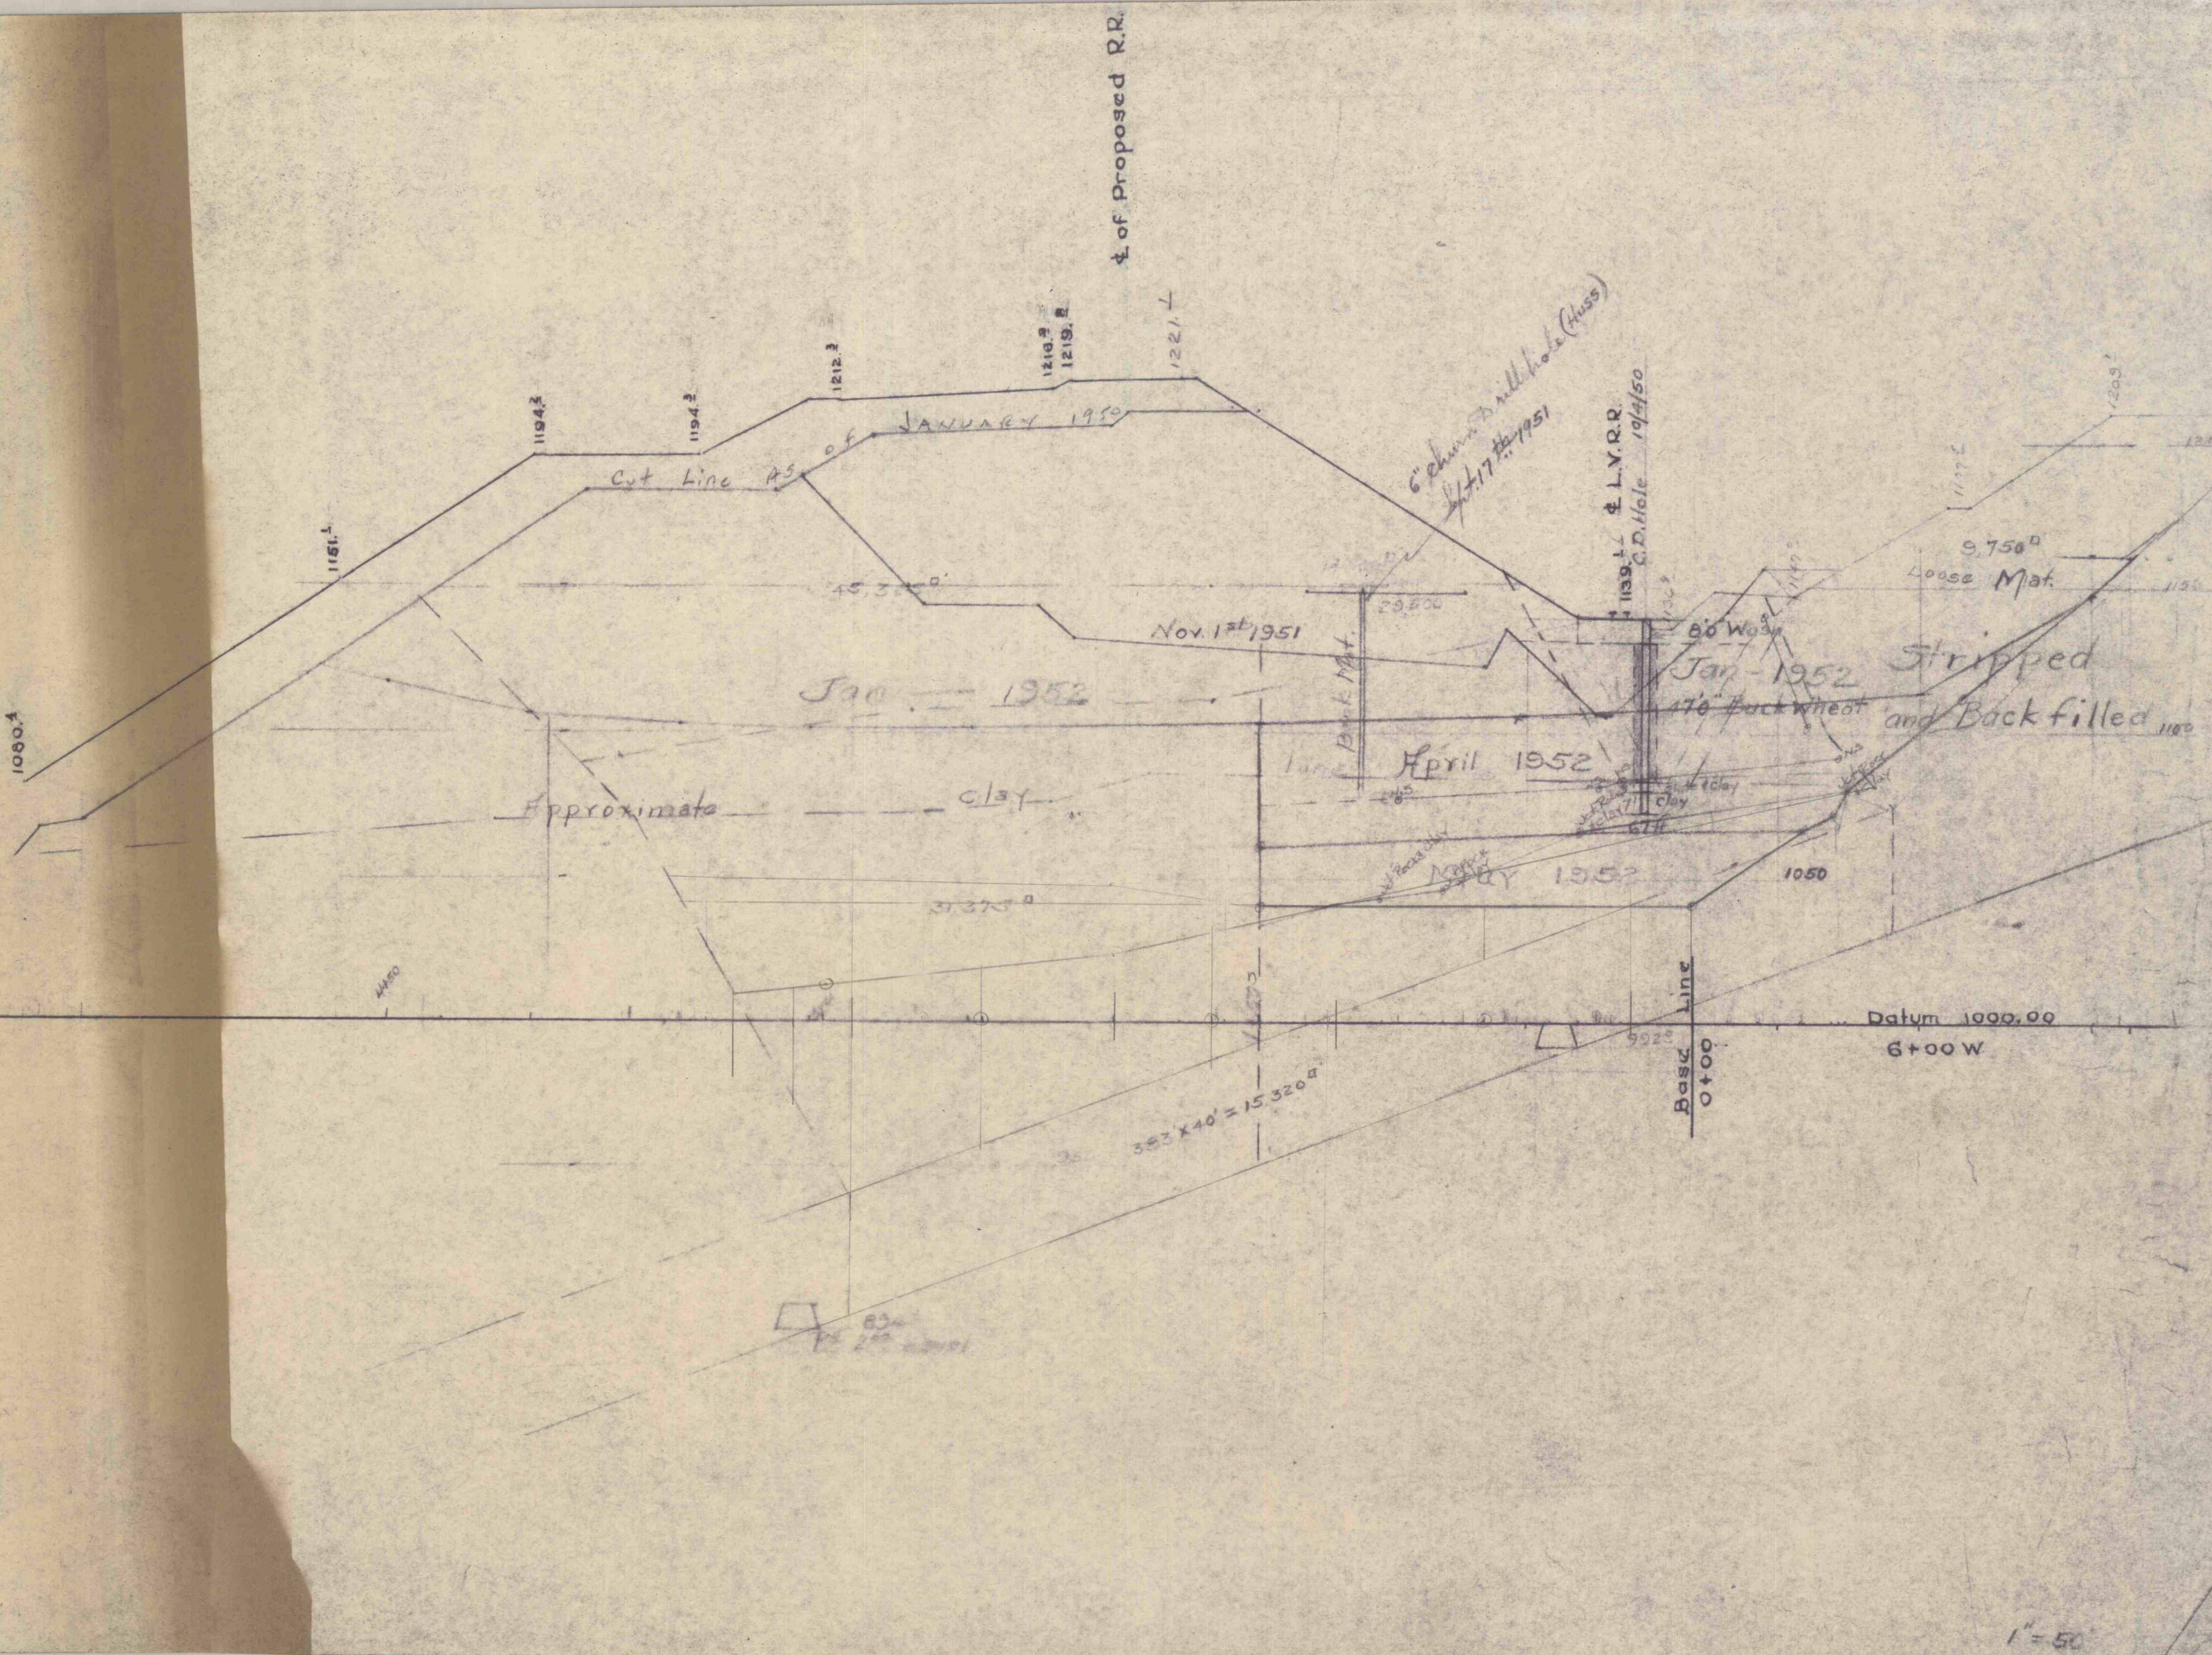

℄ of Proposed R.R.
1221.⊥
1219.9
1219.8
1212.3
1194.3
1194.3
1151.1
1080.4
Cut Line As of January 1950
6" Churn Drill Hole (Huss) Sept. 17th 1951
℄ L.V.R.R.
1139.1
C.D. Hole 10/4/50
9,750□
Loose Mat.
Nov. 1st 1951
Jan 1952
Back Mat.
Jan. 1952
Stripped
17'0" Buckwheat
and Backfilled
April 1952
Approximate clay
May 1952
31,375□
1050
Datum 1000.00
6+00 W
Base Line
0+00
383' x 40' = 15,320□
1" = 50'