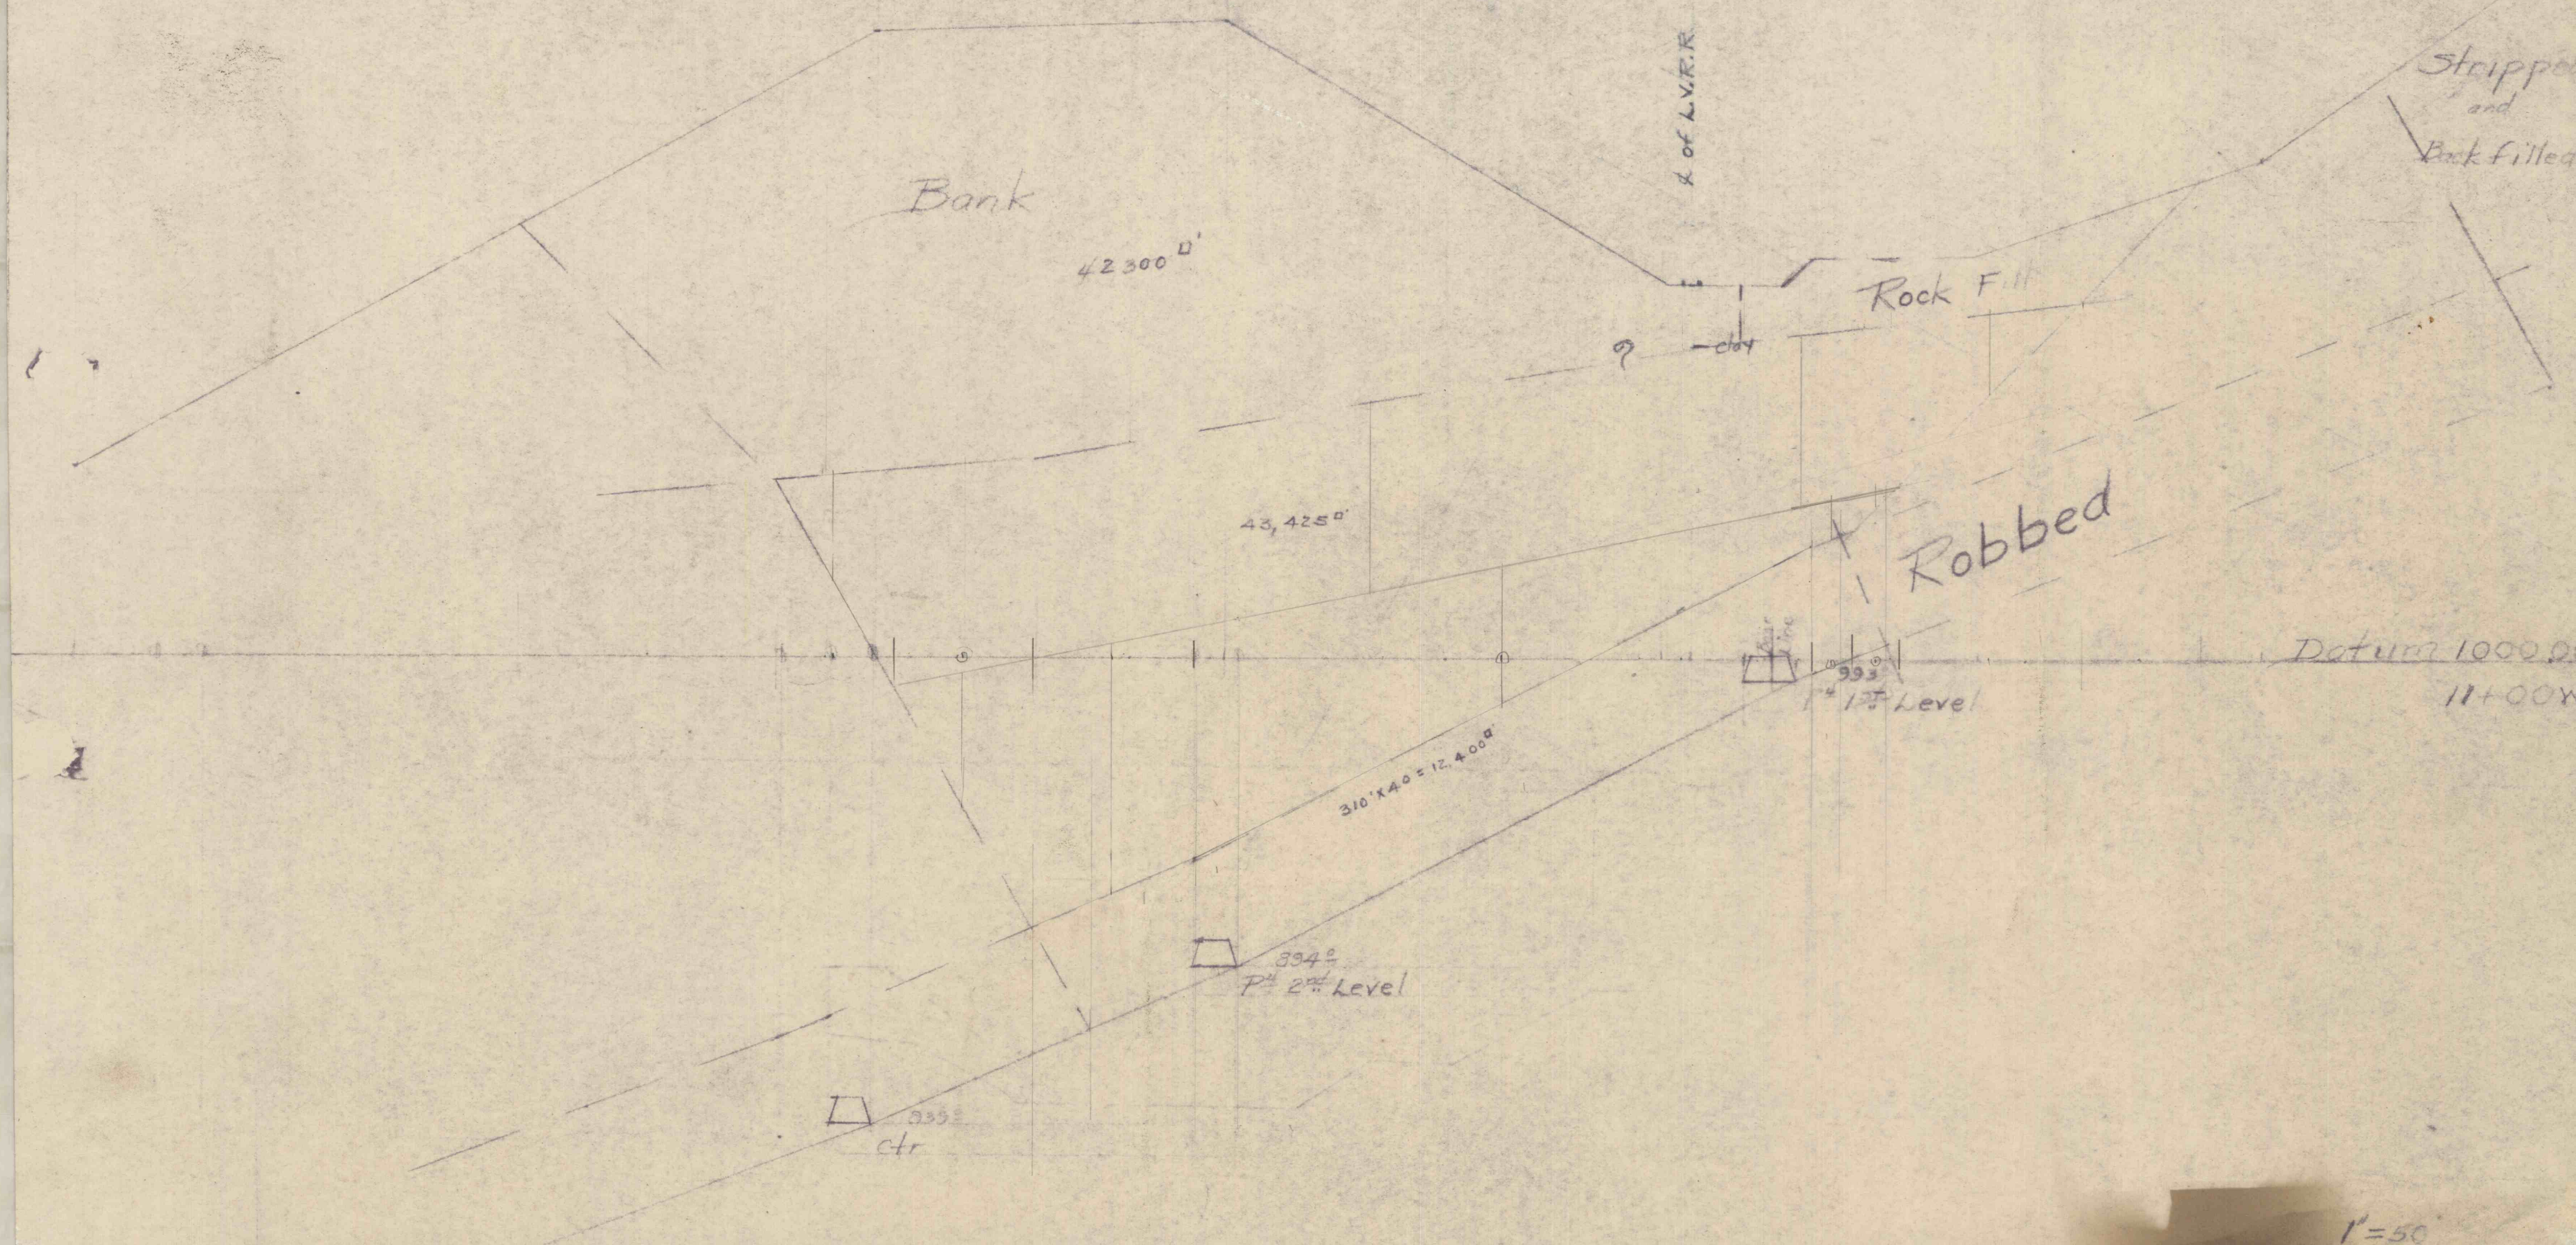
Bank
42300 □'
℄ of L.V.R.R
Rock Fill
clay
Stripped
and
Back filled
43,425 □'
Robbed
Datum 1000.0
11+00W
993
Pt 1st Level
310' X 4.0 = 12,400 □'
994
Pt 2nd Level
993
Ctr
1" = 50'