


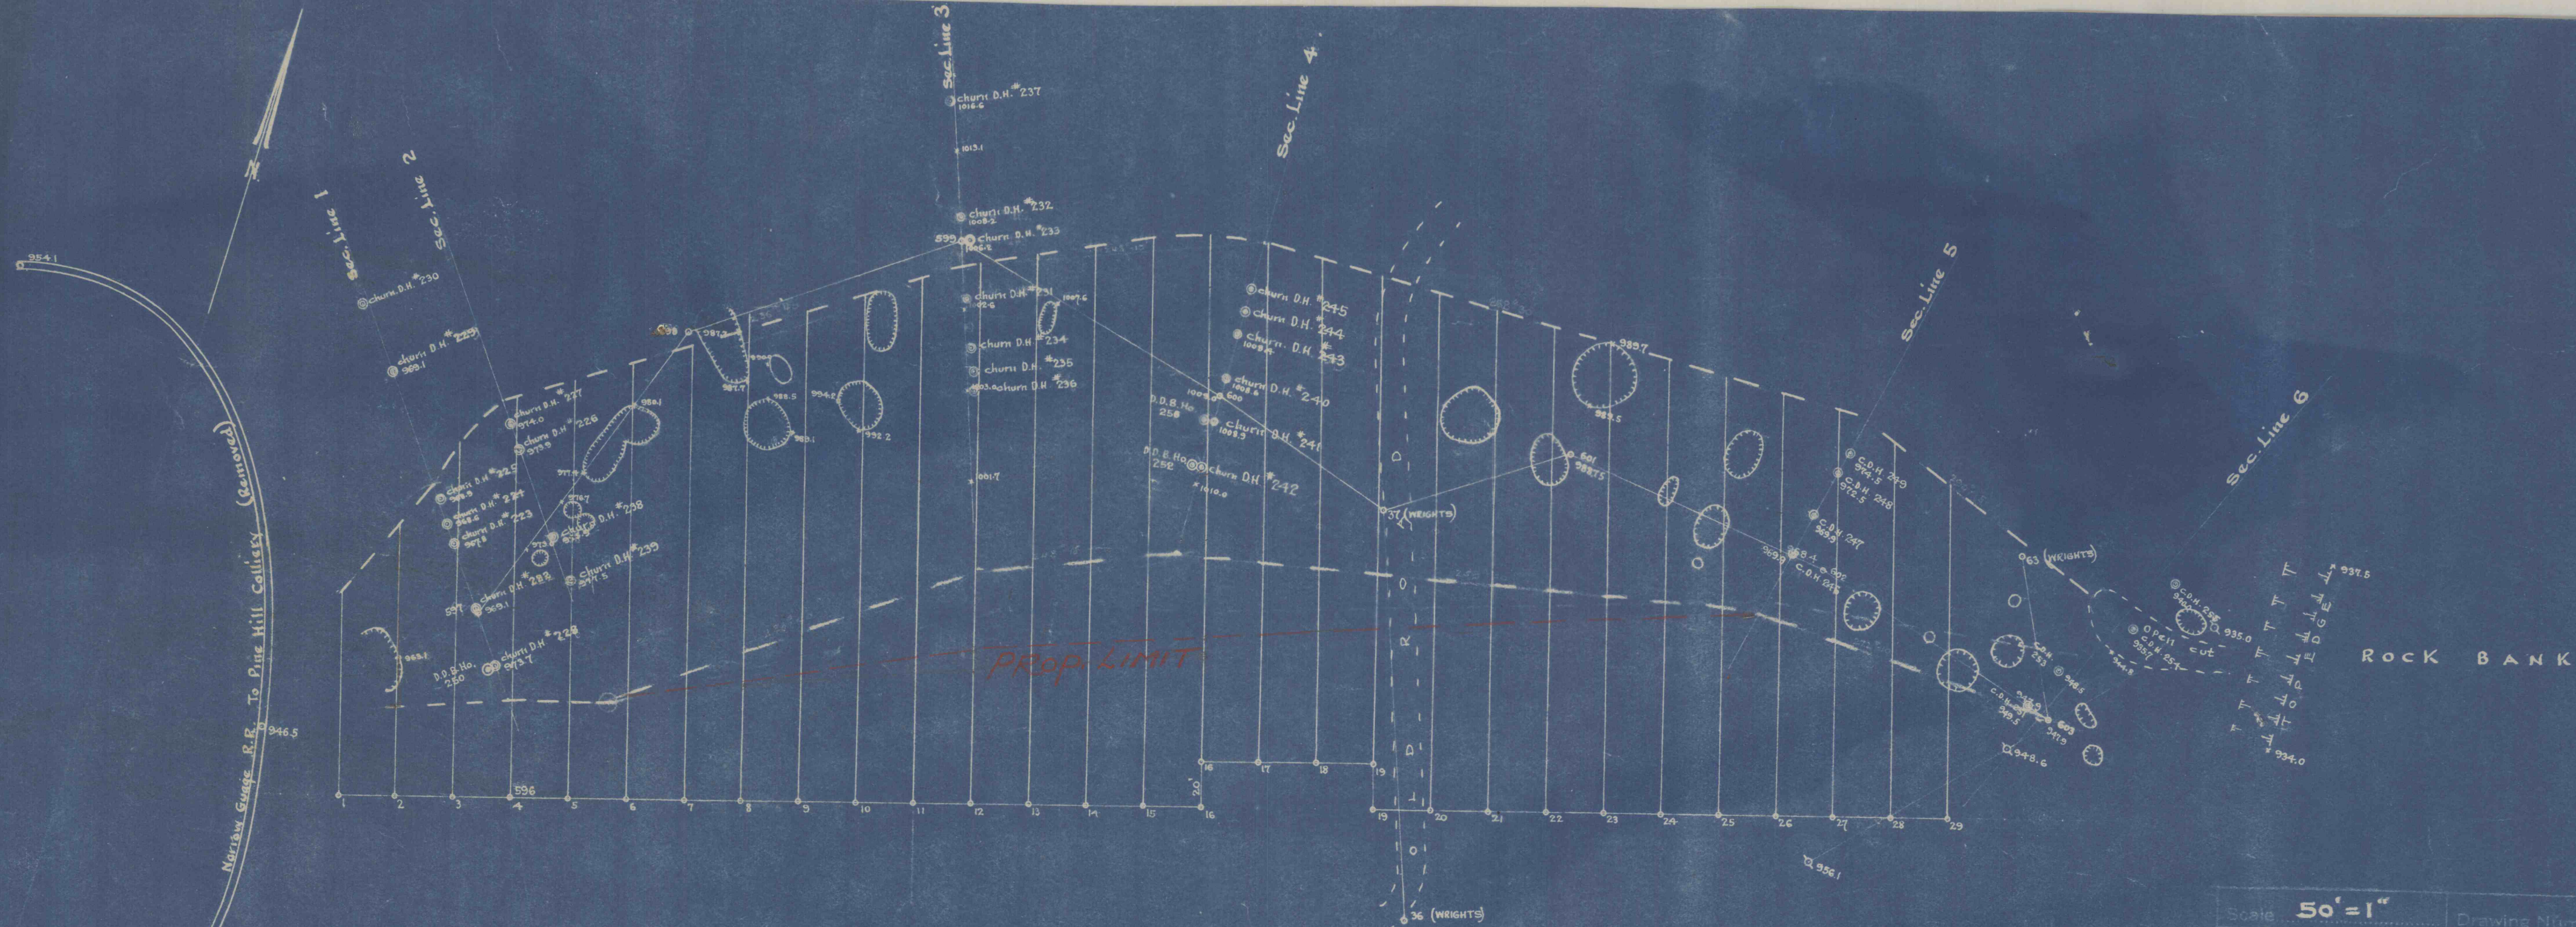

Scale	50' = 1"	Drawing Number	
PROPOSED WHITE ASH VEIN STRIPPING			
PINE HILL COAL CO. PINE HILL COLLIERY			
DRAWN	DATE	THRU	BY
	11.12.31		
REVISED			
APPROVED			
APPROVED			