


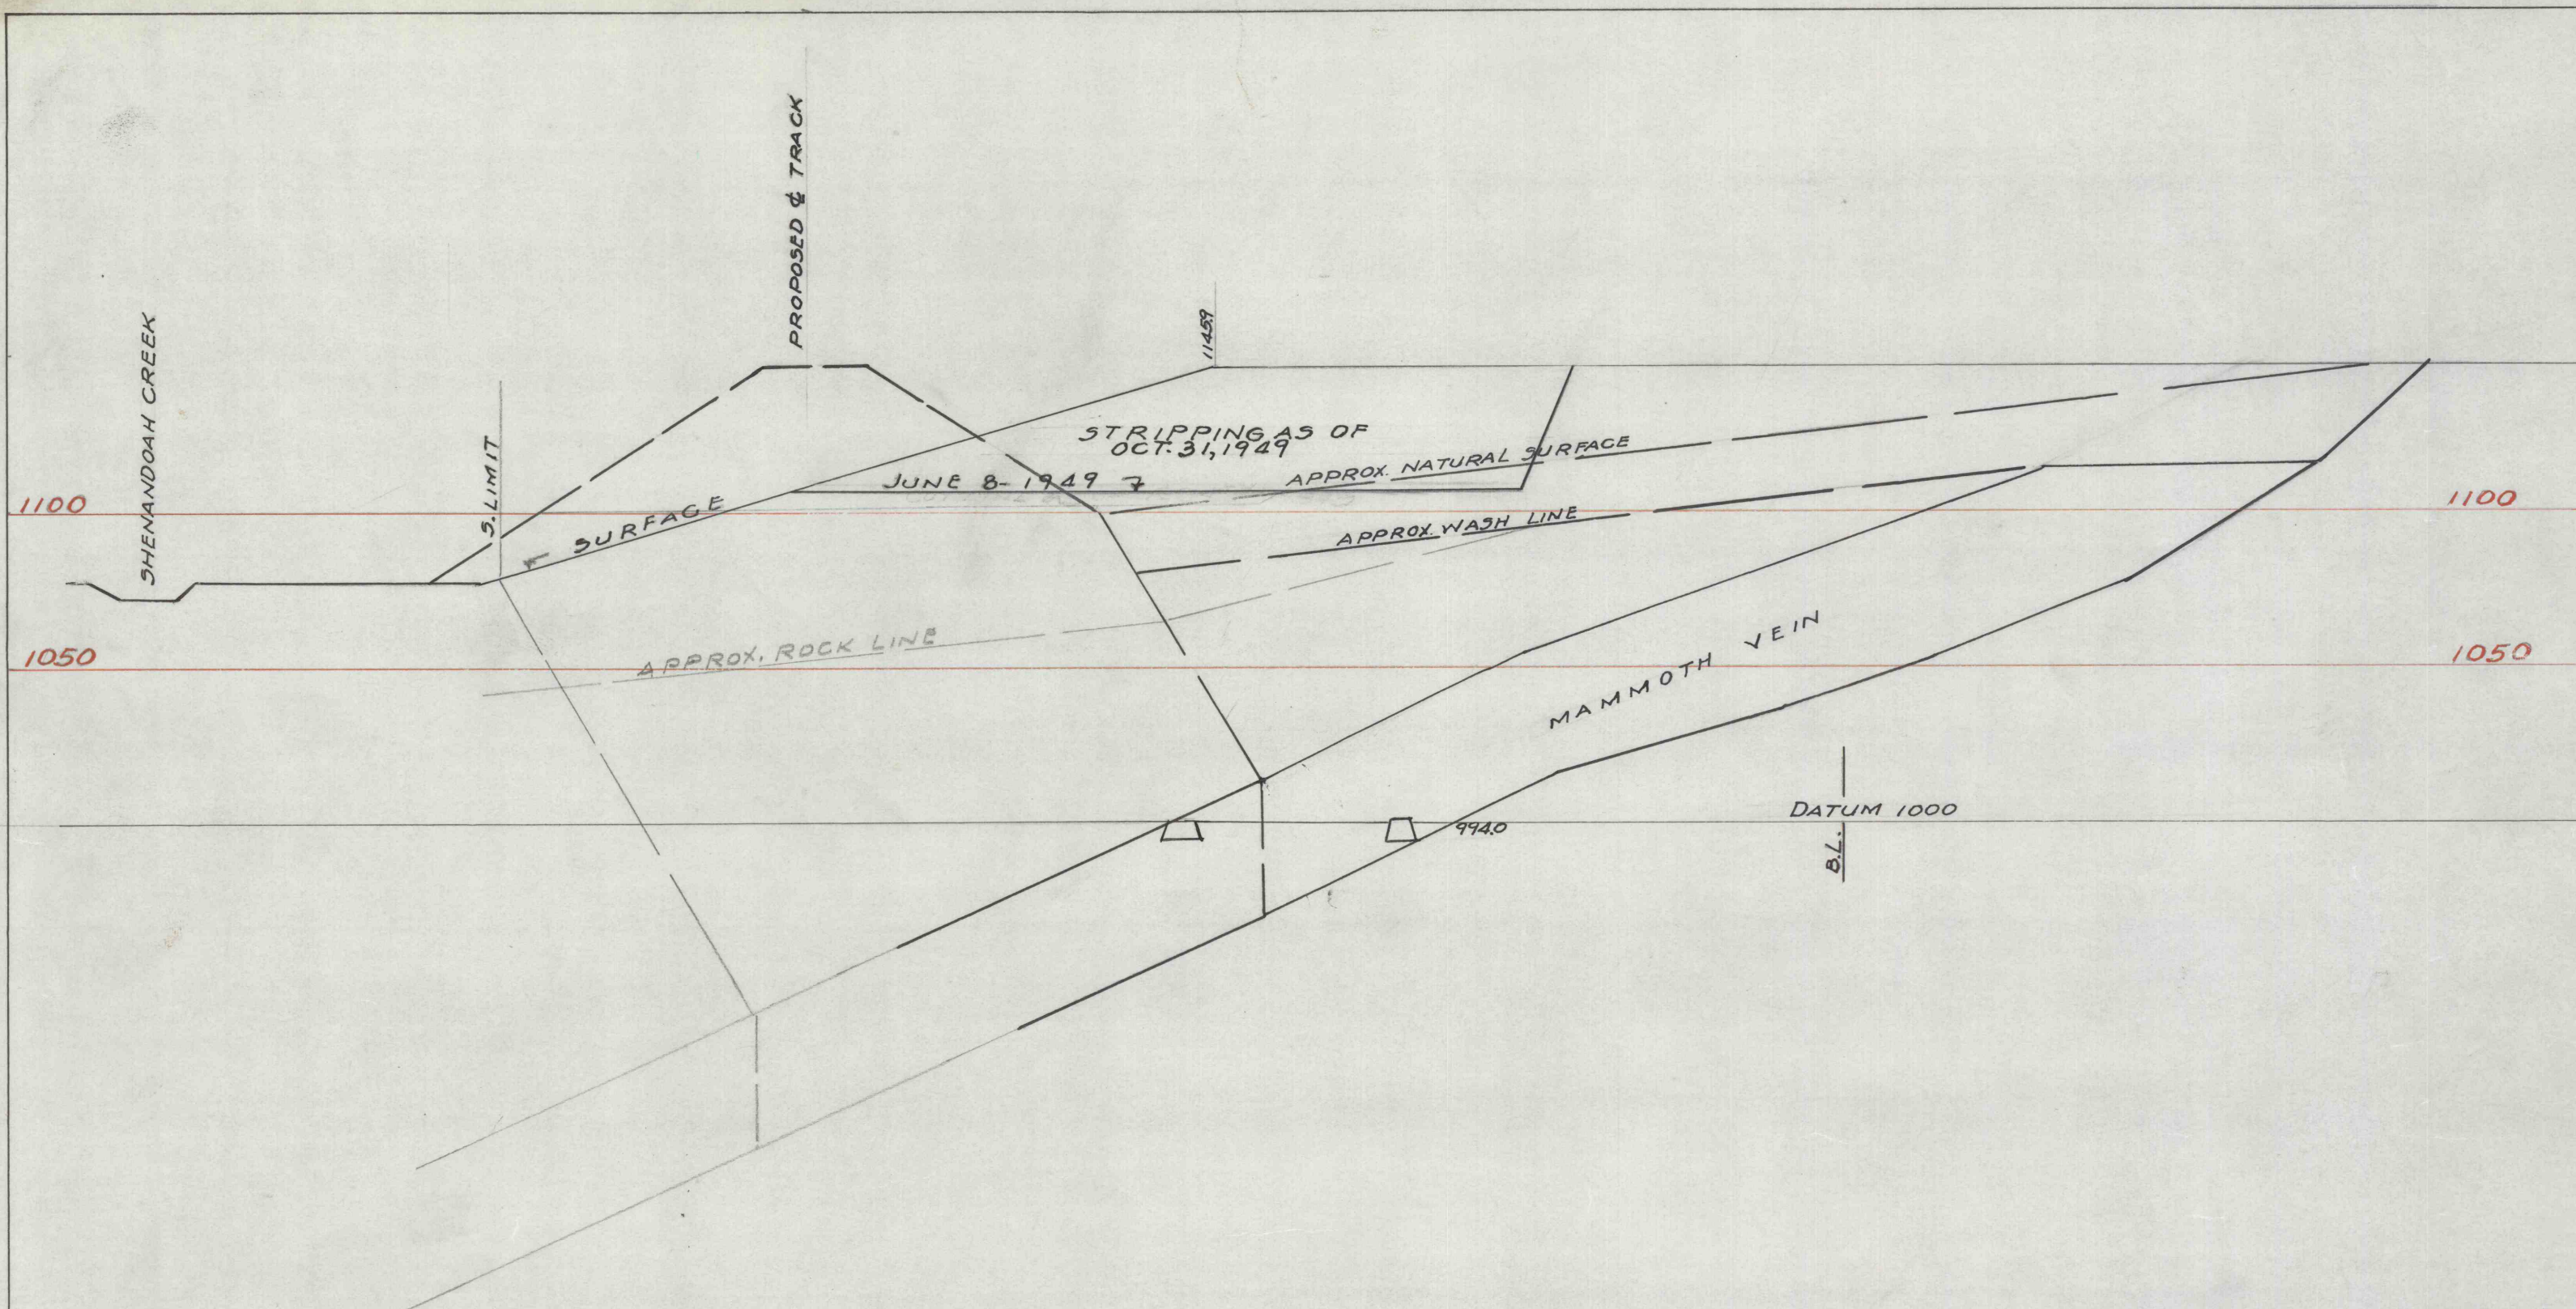

J. ROBERT BAZLEY, Inc.			
POTTSVILLE, PENNA.			
PACKER NO 4 STRIPPING			
SECTION 1730 WEST			
THROUGH GUNBOAT SLOPE			
DATE	SCALE	BY	BY
4-49	1"=50'		G-33