


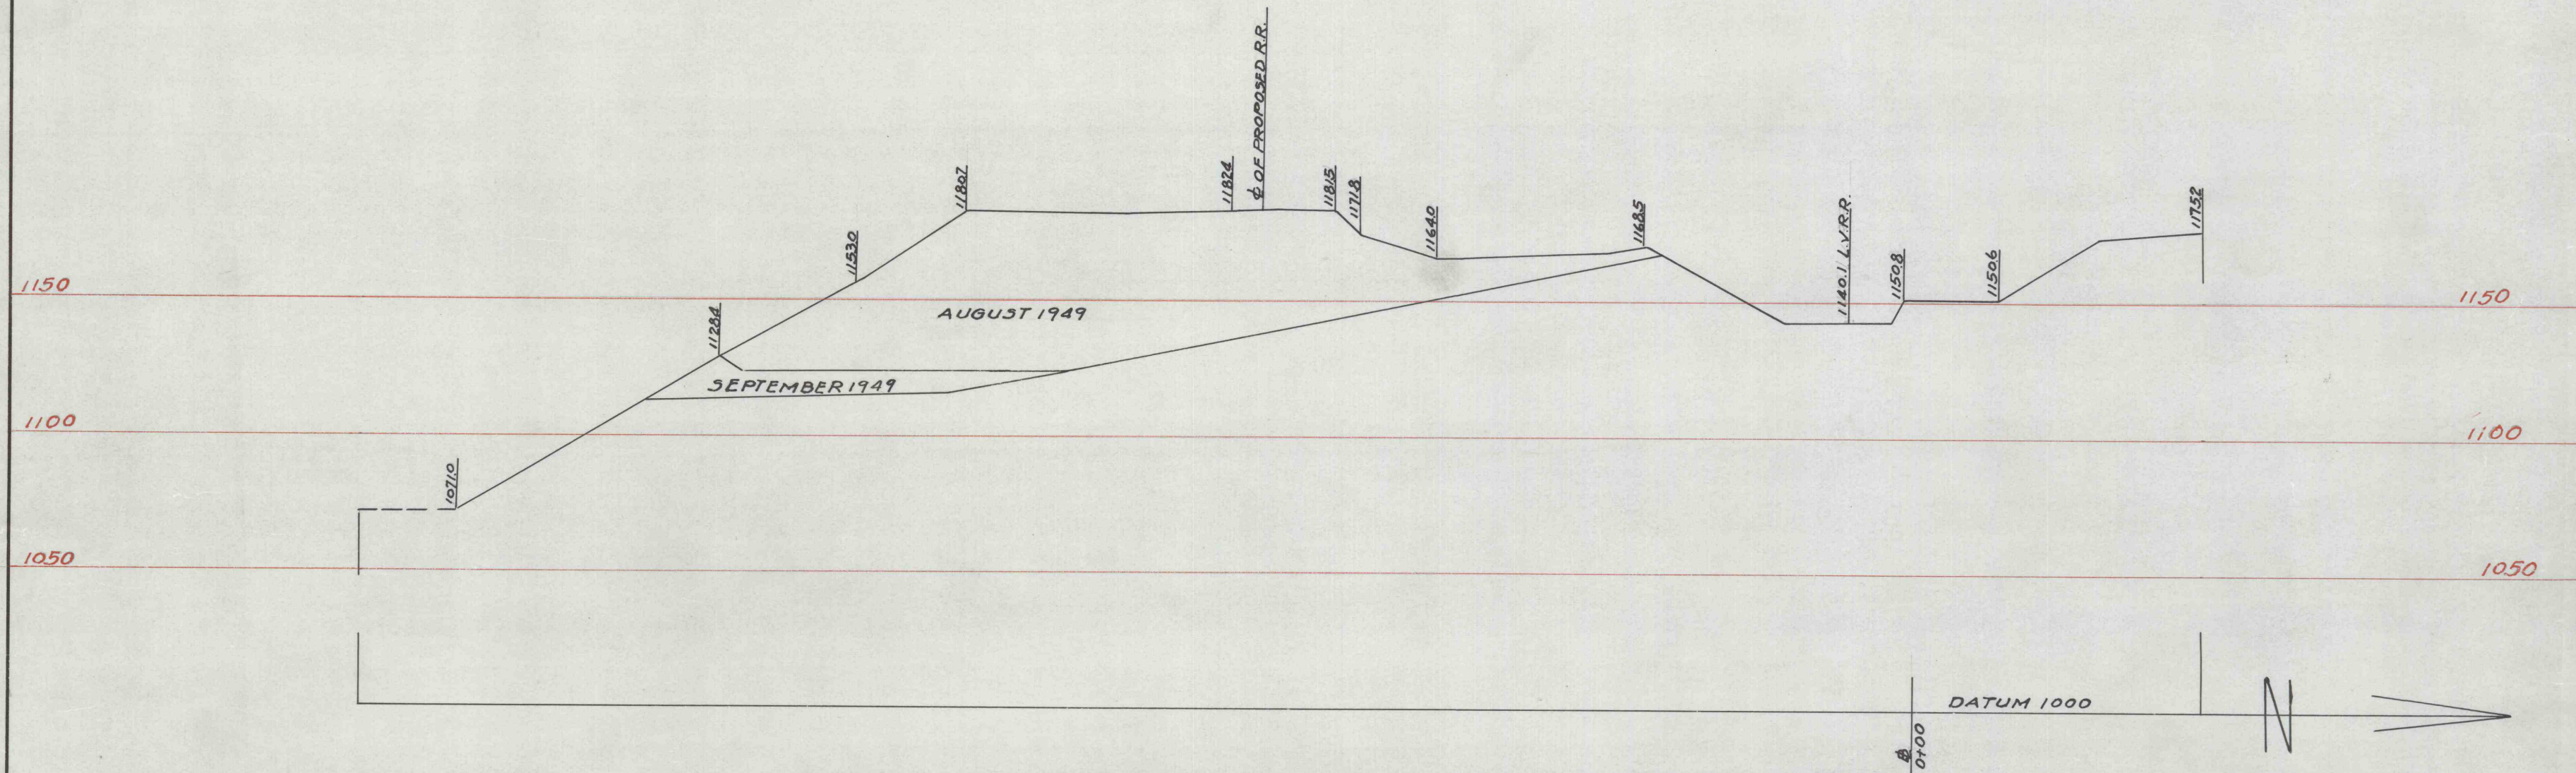

J. ROBERT BAZLEY, Inc.
POTTSVILLE, PENNA.
PACKER N^o 4-N^o 10 STRIPPING
SECTION 5+00 WEST

DATE	SCALE	BY	DRWING
1-50	1"=50'		6-33