


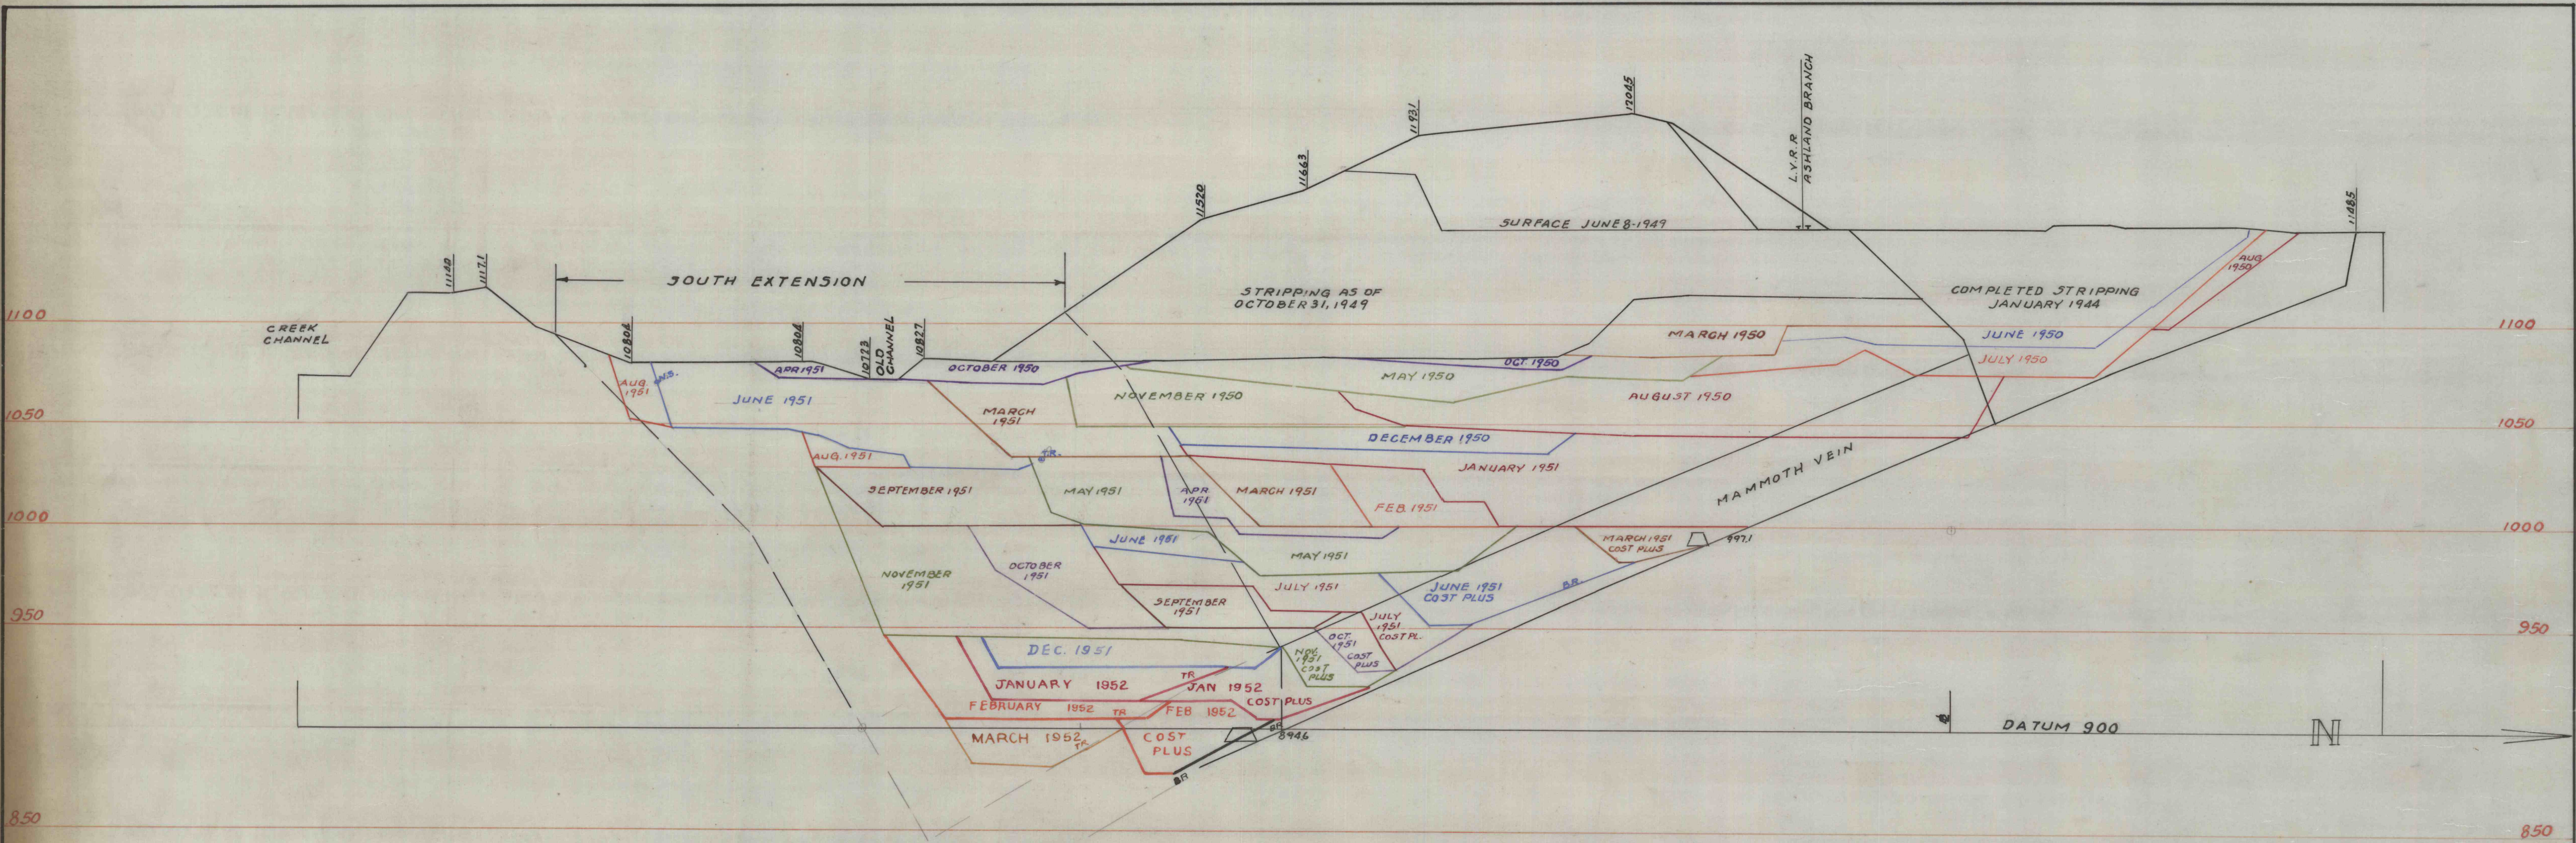

J. ROBERT BAZLEY, Inc.
POTTSVILLE, PENNA.
PACKER NO. 10 STRIPPING
SECTION 1400 EAST
250' EAST OF GUNBOAT SLOPE
DATE 5-51 SCALE 1"=50 BY G-33