


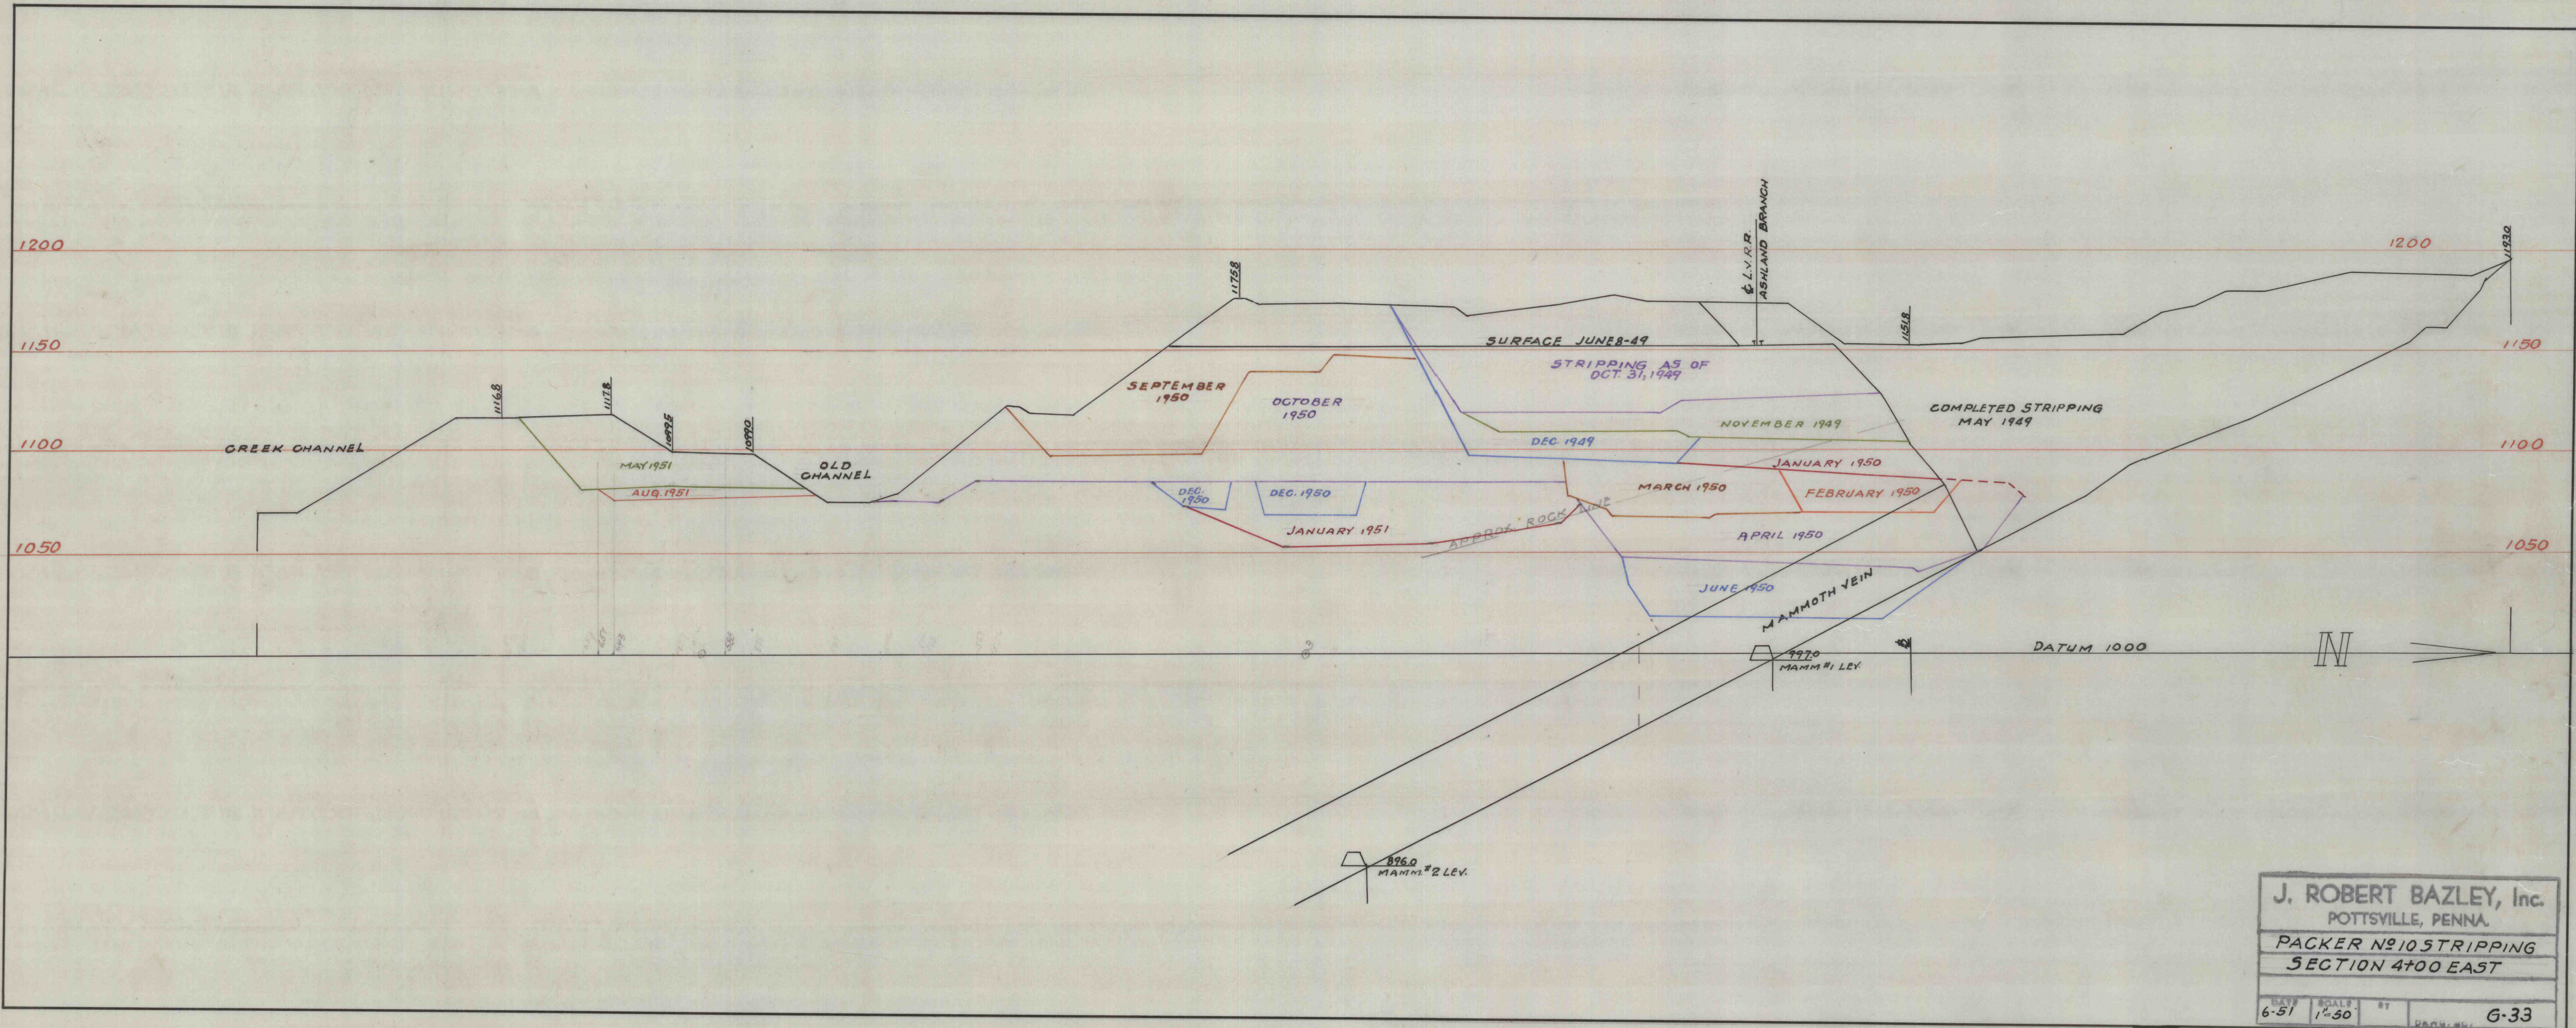

J. ROBERT BAZLEY, Inc.
POTTSVILLE, PENNA.
PACKER NO. 10 STRIPPING
SECTION 4+00 EAST
DATE 6-51 SCALE 1"=50' BY G-33

P331-MC-JAT