


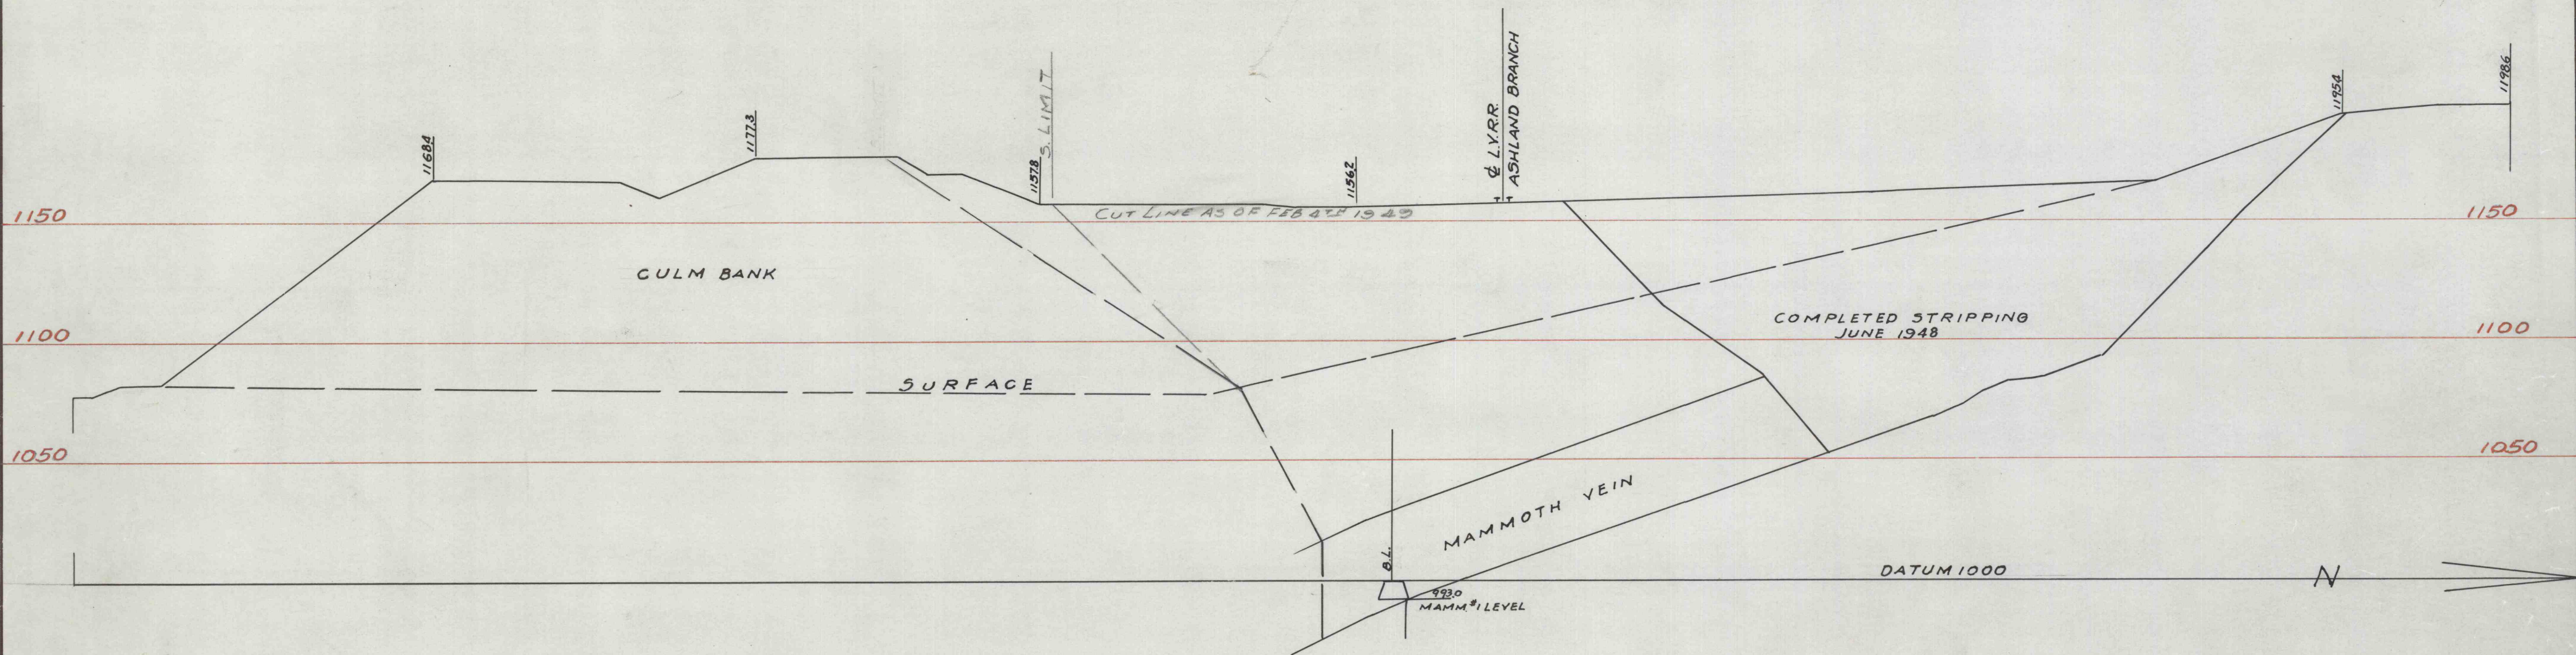

|                                |        |    |      |
|--------------------------------|--------|----|------|
| J. ROBERT BAZLEY, Inc.         |        |    |      |
| POTTSVILLE, PENNA.             |        |    |      |
| PACKER No 4 STRIPPING          |        |    |      |
| SECTION 12+00 EAST             |        |    |      |
| 1350' E. EAST OF GUNBOAT SLOPE |        |    |      |
| DATE                           | SCALE  | BY |      |
| 3-49                           | 1"=50' | BY | G-33 |