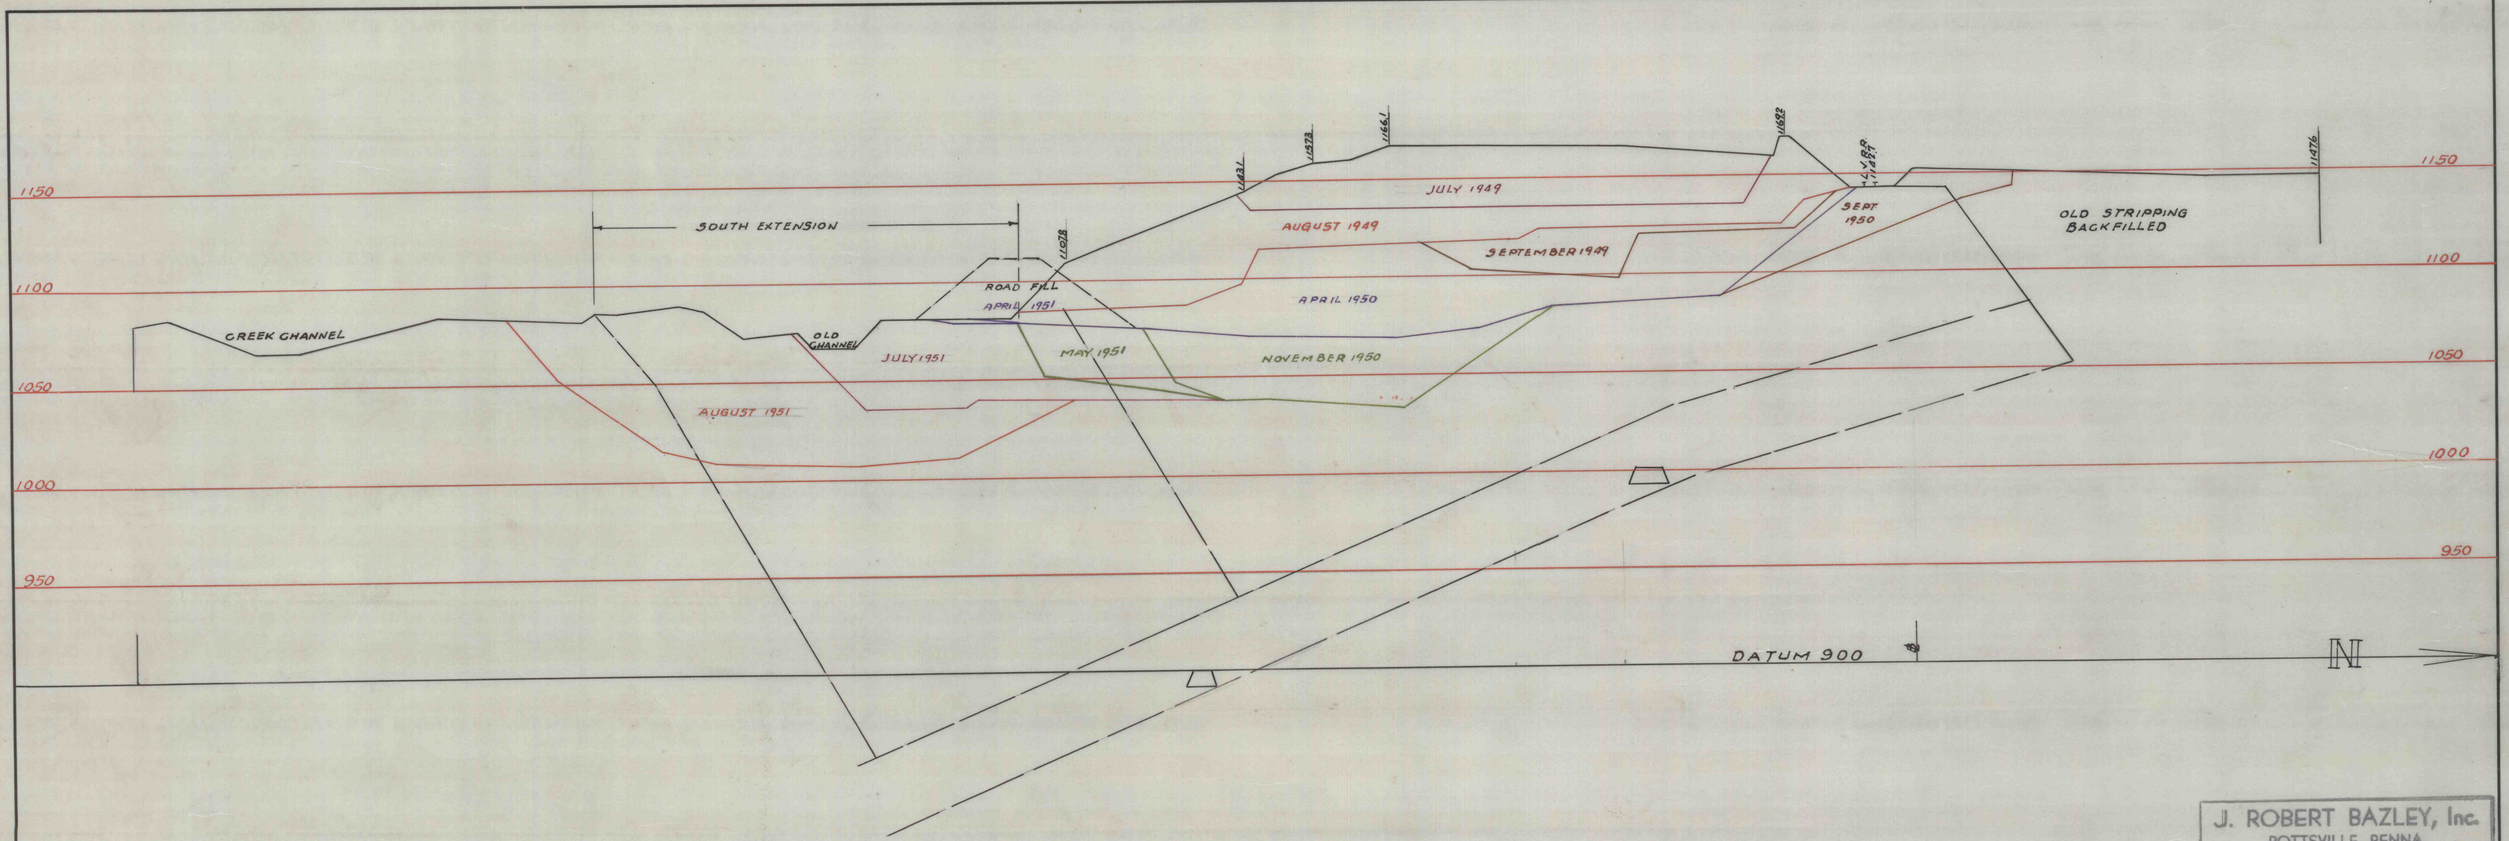

J. ROBERT BAZLEY, Inc.
POTTSVILLE, PENNA.

PACKER No 10 STRIPPING
SECTION 4+00 WEST

DATE 6-51 | SCALE 1"=50' | BY | 6-33

IA-C-2M-187