


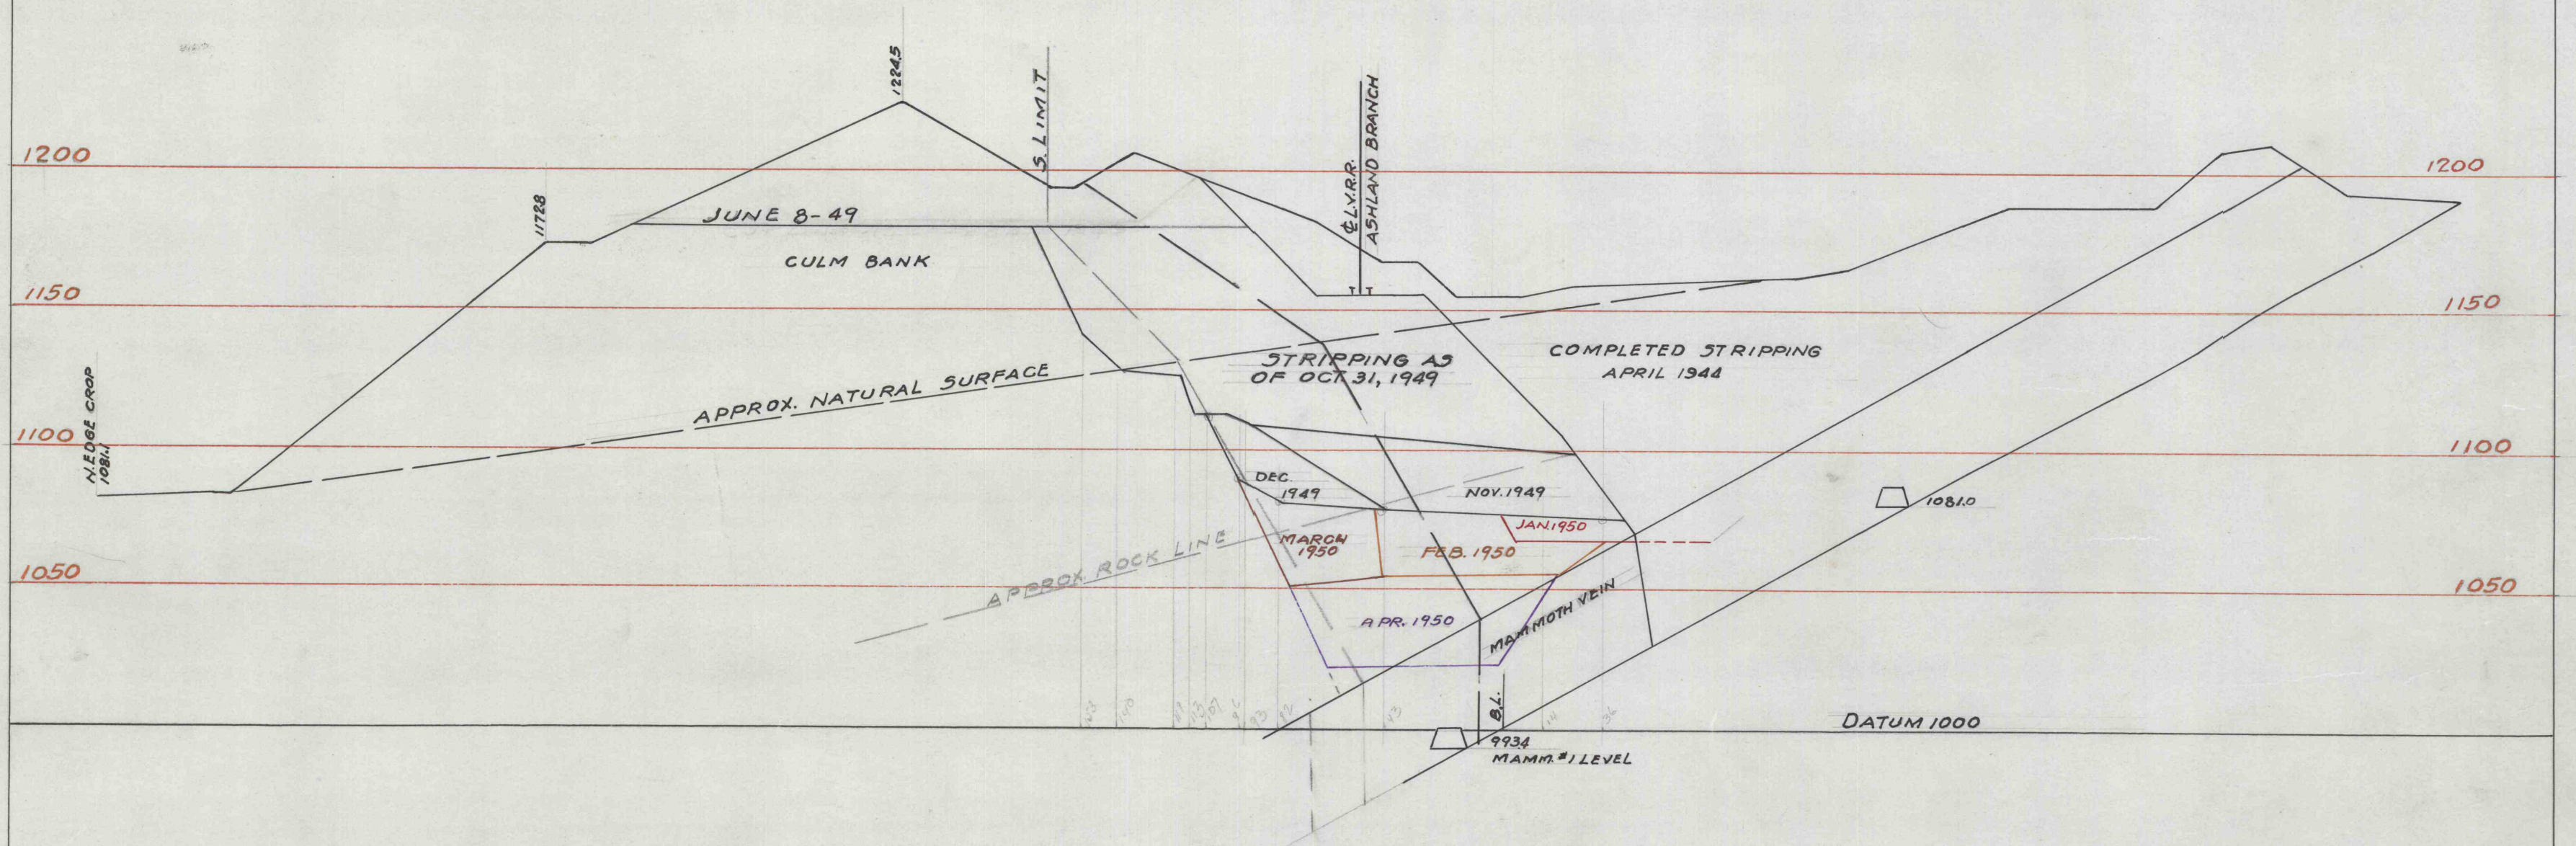

J. ROBERT BAZLEY, Inc.			
POTTSVILLE, PENNA.			
PACKER No 4 STRIPPING			
SECTION T+00 EAST			
850 F. EAST OF #4 GUNBOAT SLOPE			
DATE	SCALE	BY	PROJ. NO.
3-49	1"=50'		G-33