


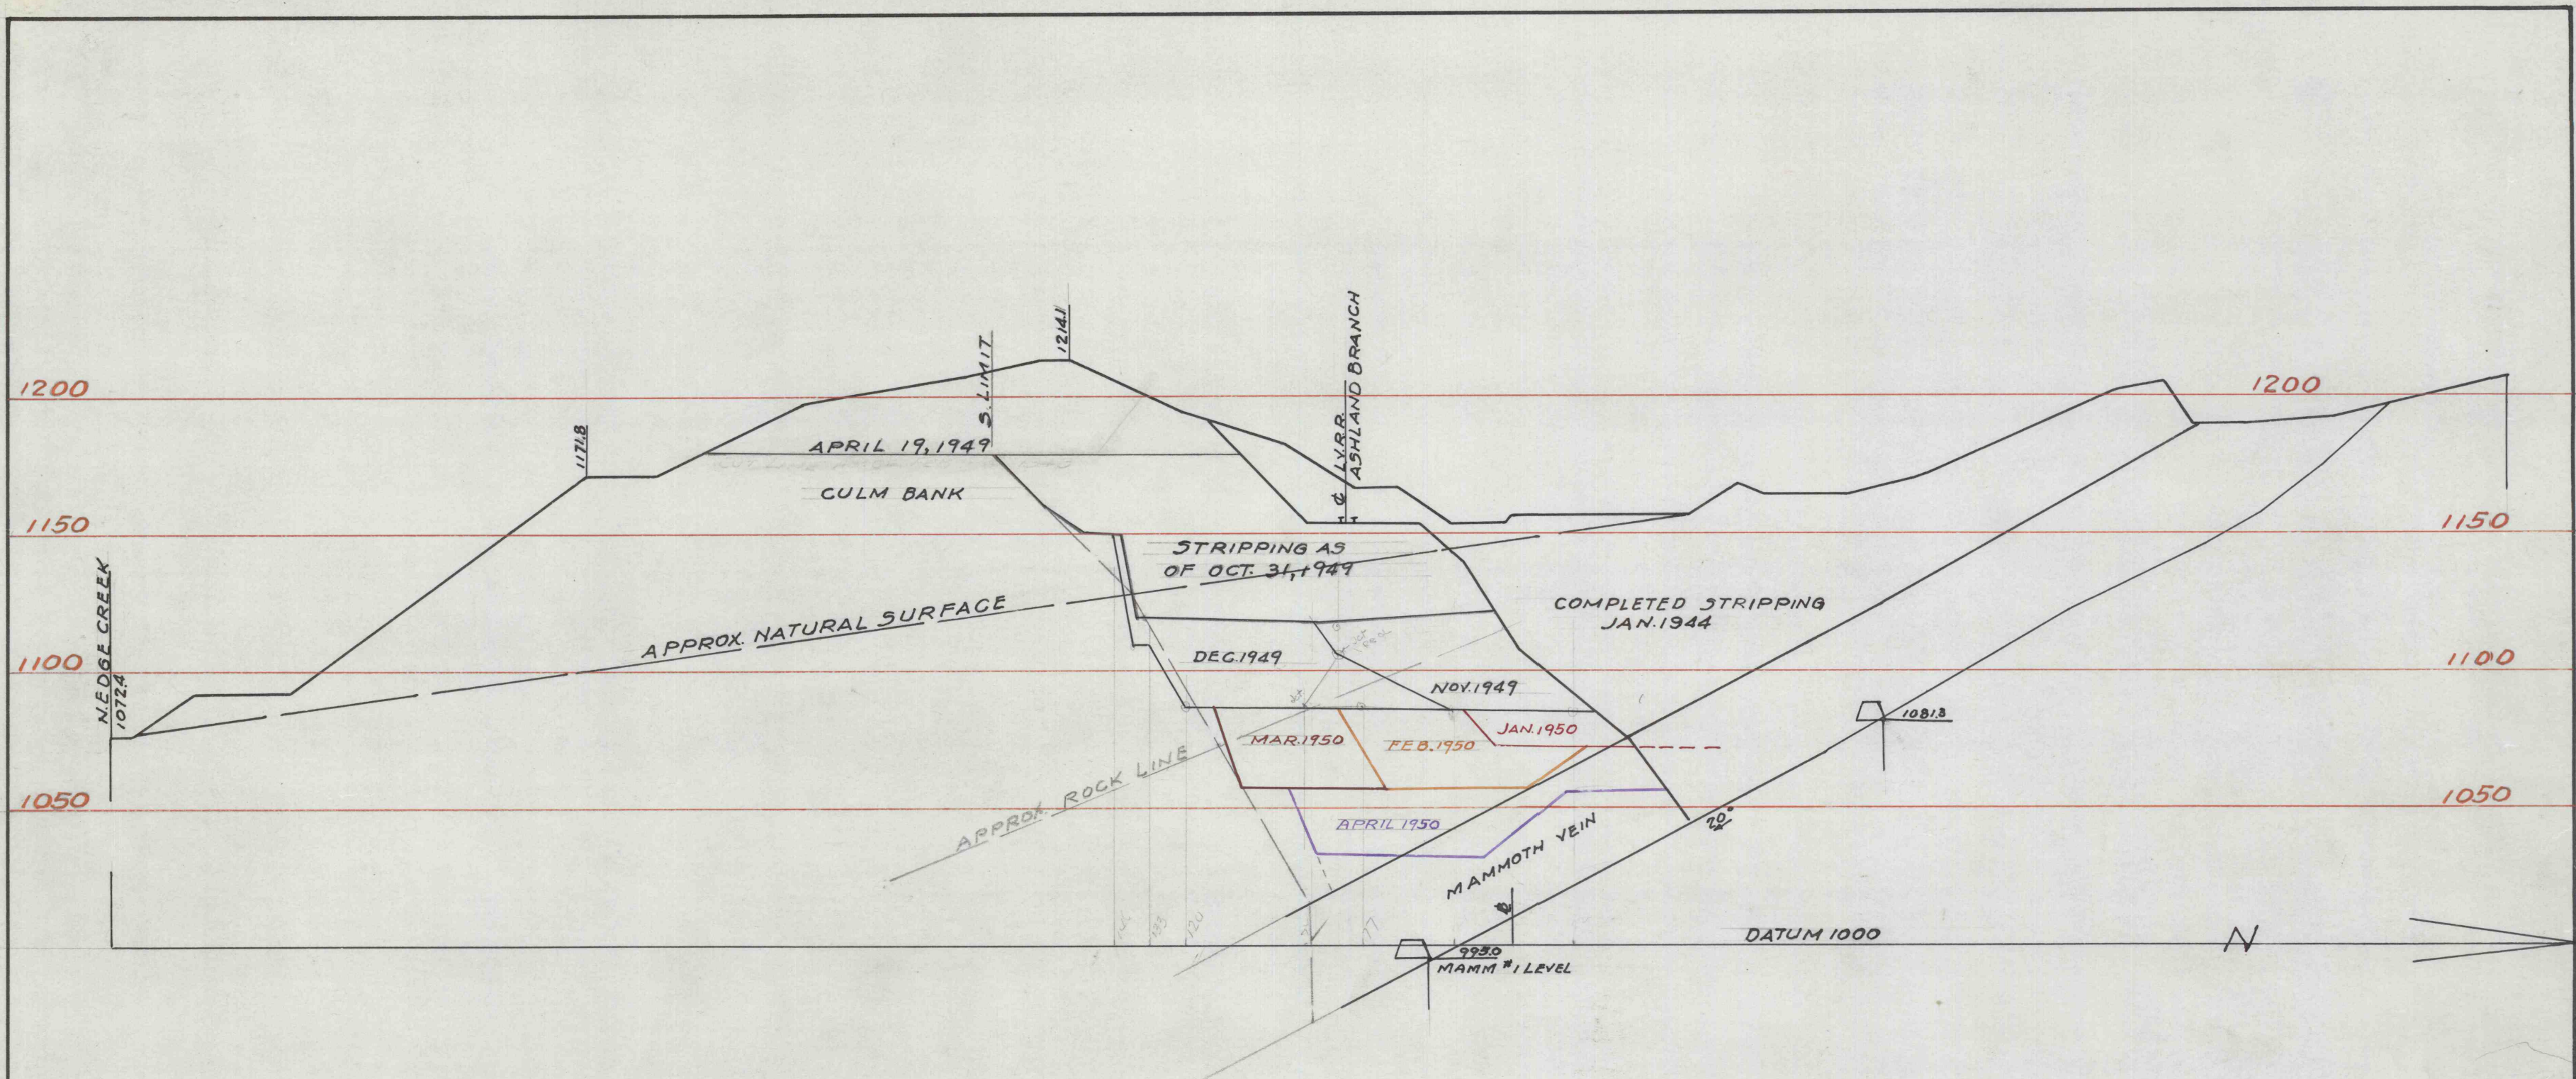

J. ROBERT BAZLEY, Inc.
 POTTSVILLE, PENNA.
 PACKER N°4 STRIPPING
 SECTION 6+00 EAST
 750 FT. EAST OF #4 GUNBOAT SLOPE
 DATE 3-49 SCALE 1"=50' BY G-33