


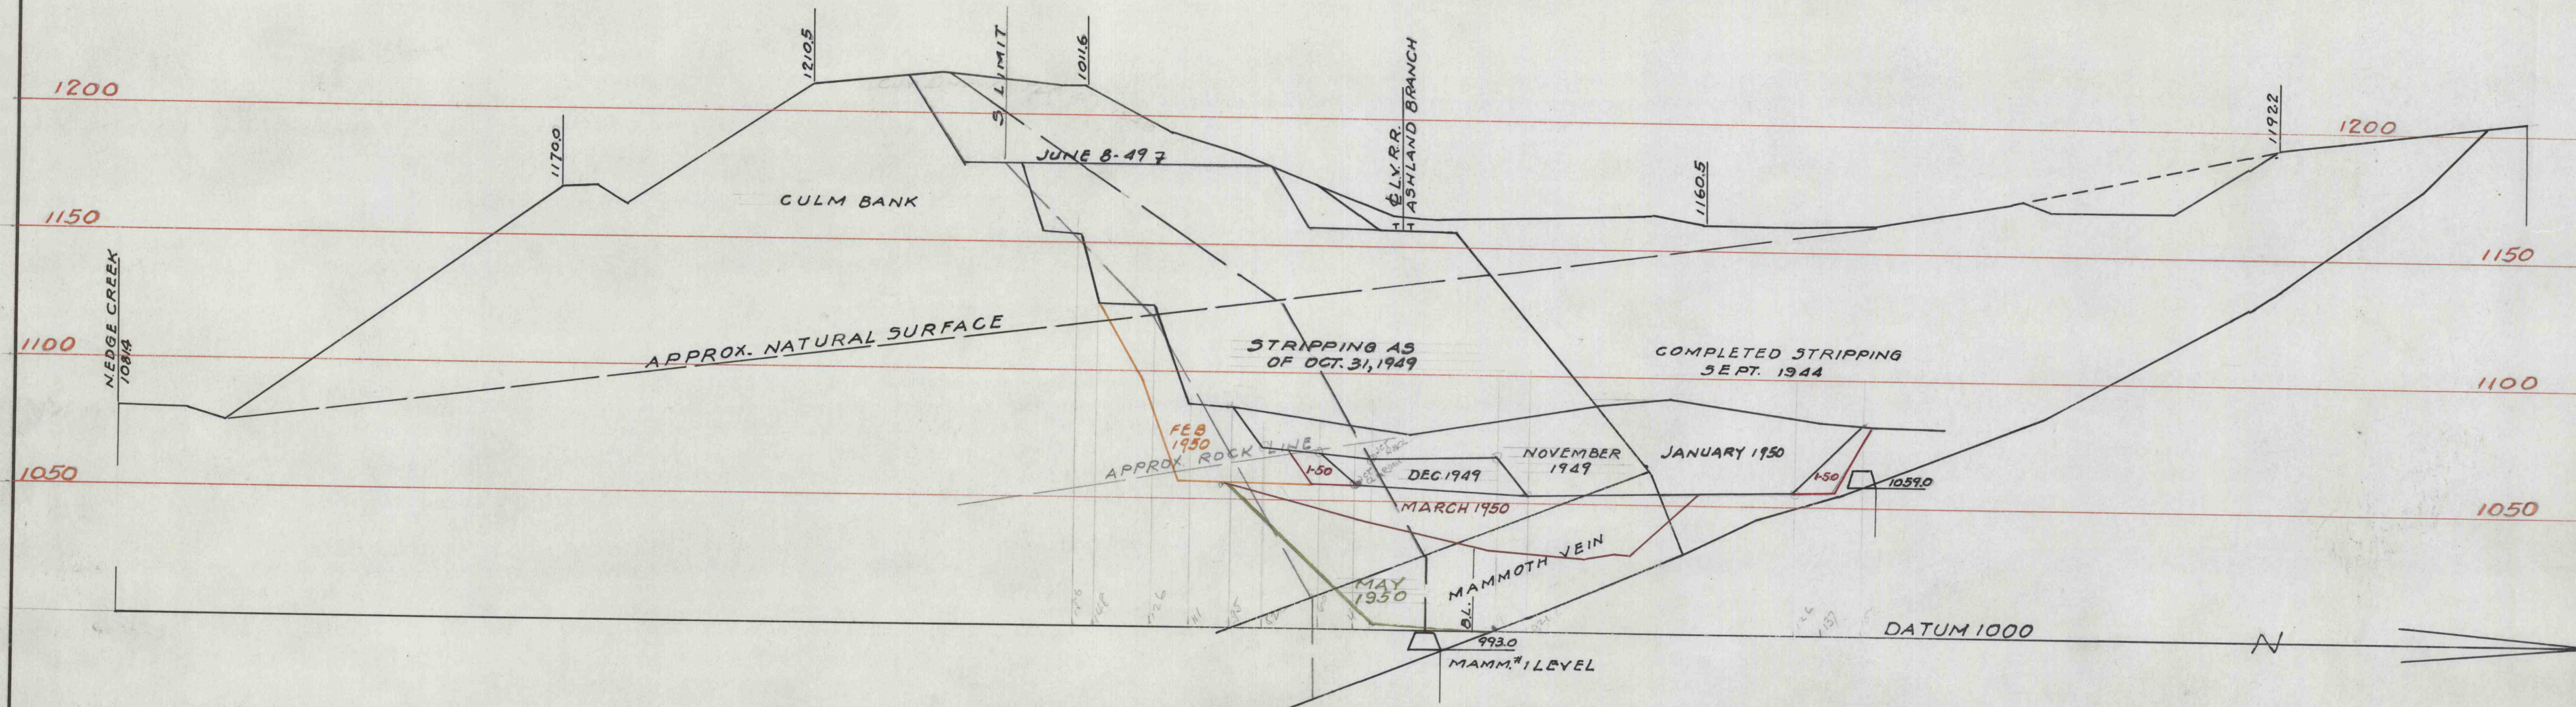

J. ROBERT BAZLEY, Inc.
 POTTSVILLE, PENNA.

PACKER NO 4 STRIPPING
 SECTION 10+00 EAST
 1150 FT. EAST OF GUNBOAT SLOPE

DATE	SCALE	BY	DATE
3-25	1"=50'		G-33