


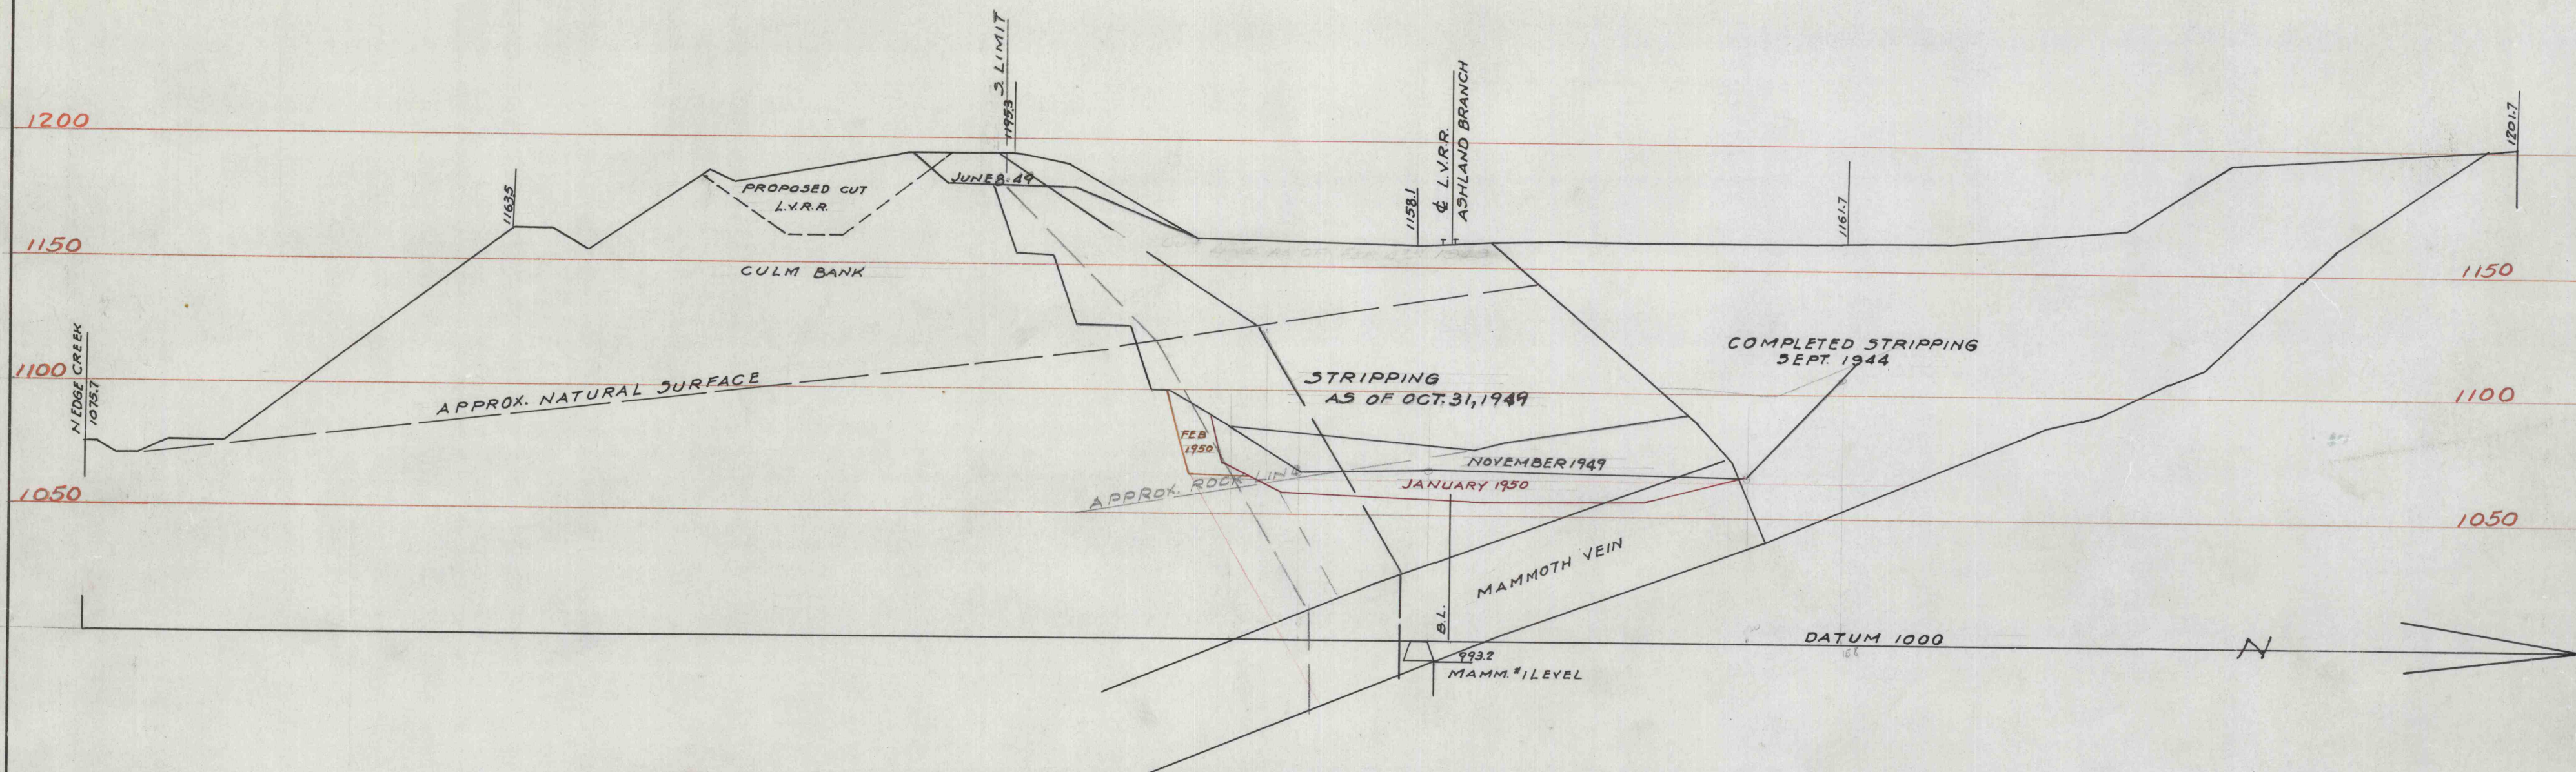

J. ROBERT BAZLEY, Inc.
 POTTSVILLE, PENNA.
 PACKER NO 4 STRIPPING
 SECTION 11400 EAST
 1250 FT. EAST OF GUNBOAT SLOPE
 DATE 3-49 SCALE 1"=50' BY G-33