


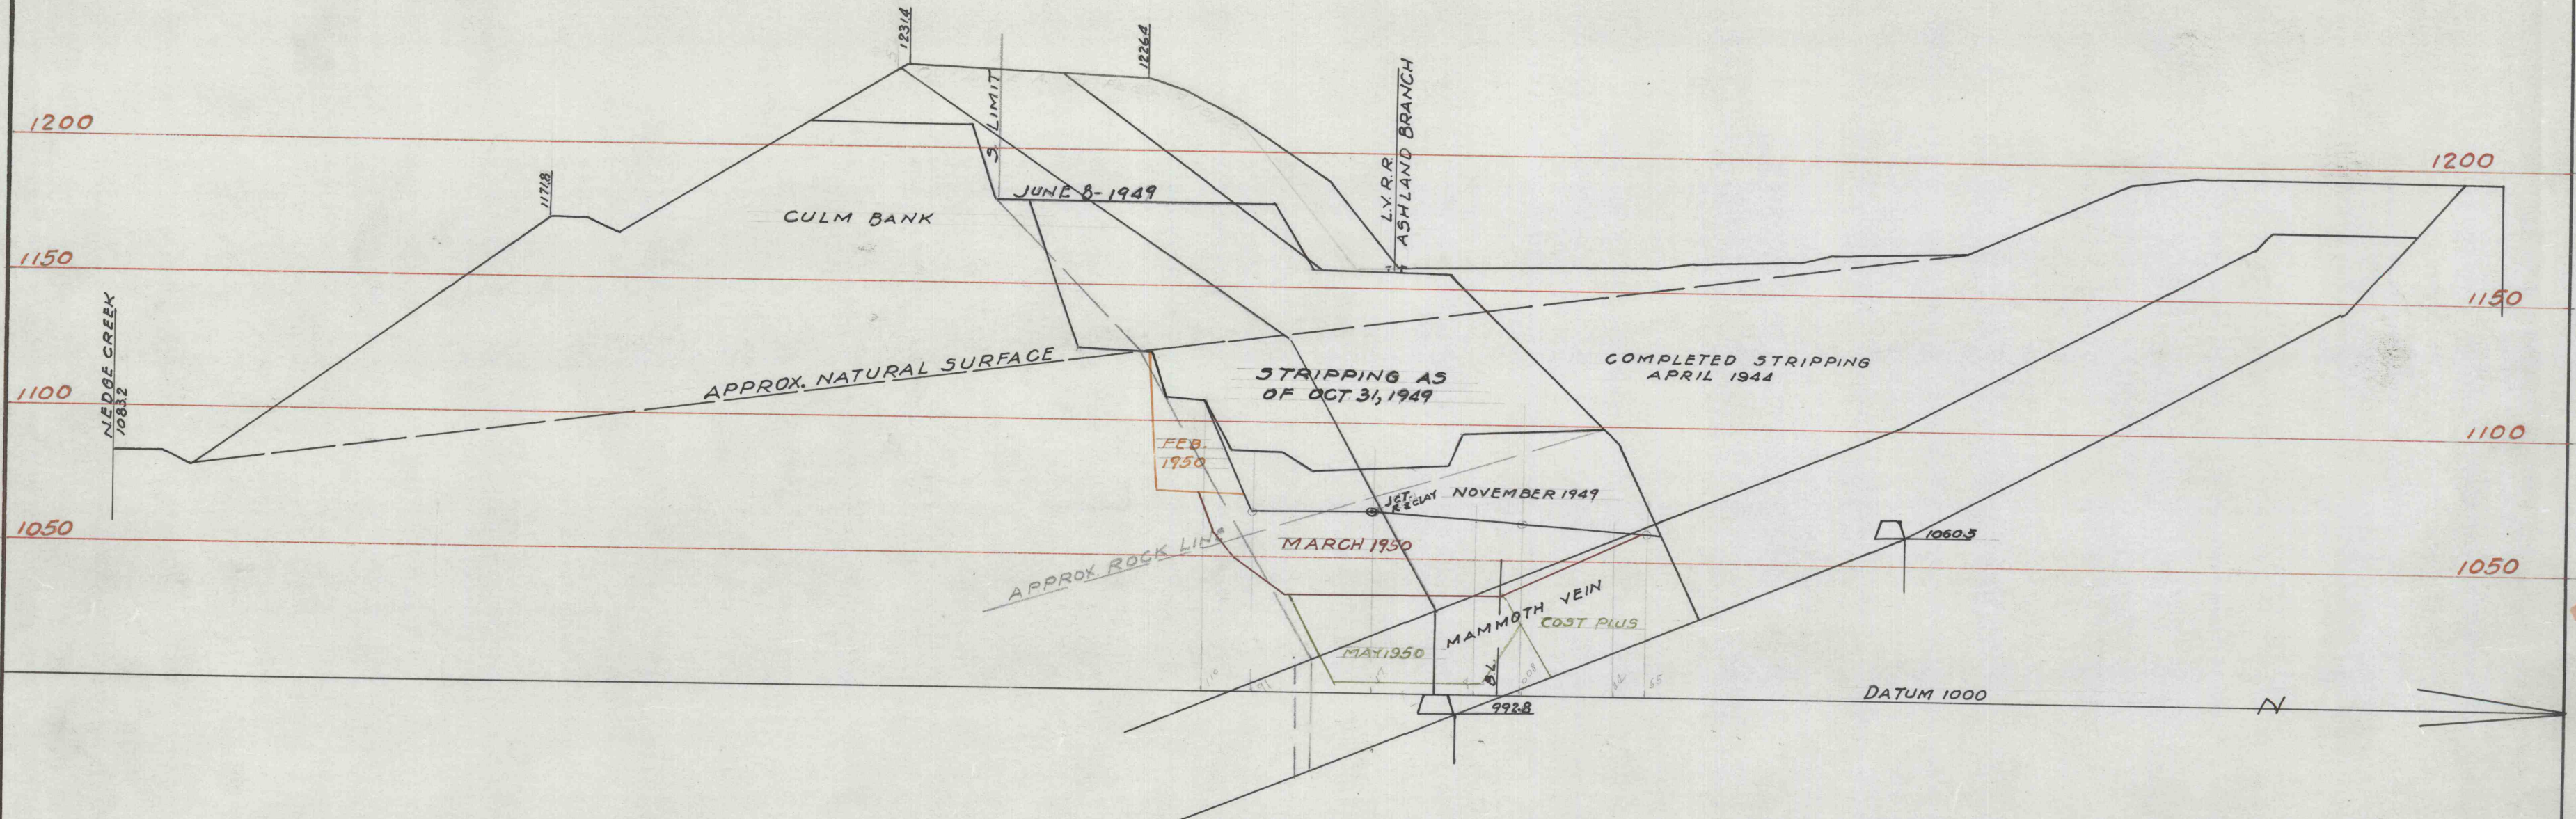

J. ROBERT BAZLEY, Inc.
POTTSVILLE, PENNA.
PACKER NO. 4 STRIPPING
SECTION 9+00
1050 F. EAST OF GUNBOAT SLOPE
DATE 3-49 SCALE 1"=50' BY G-33