


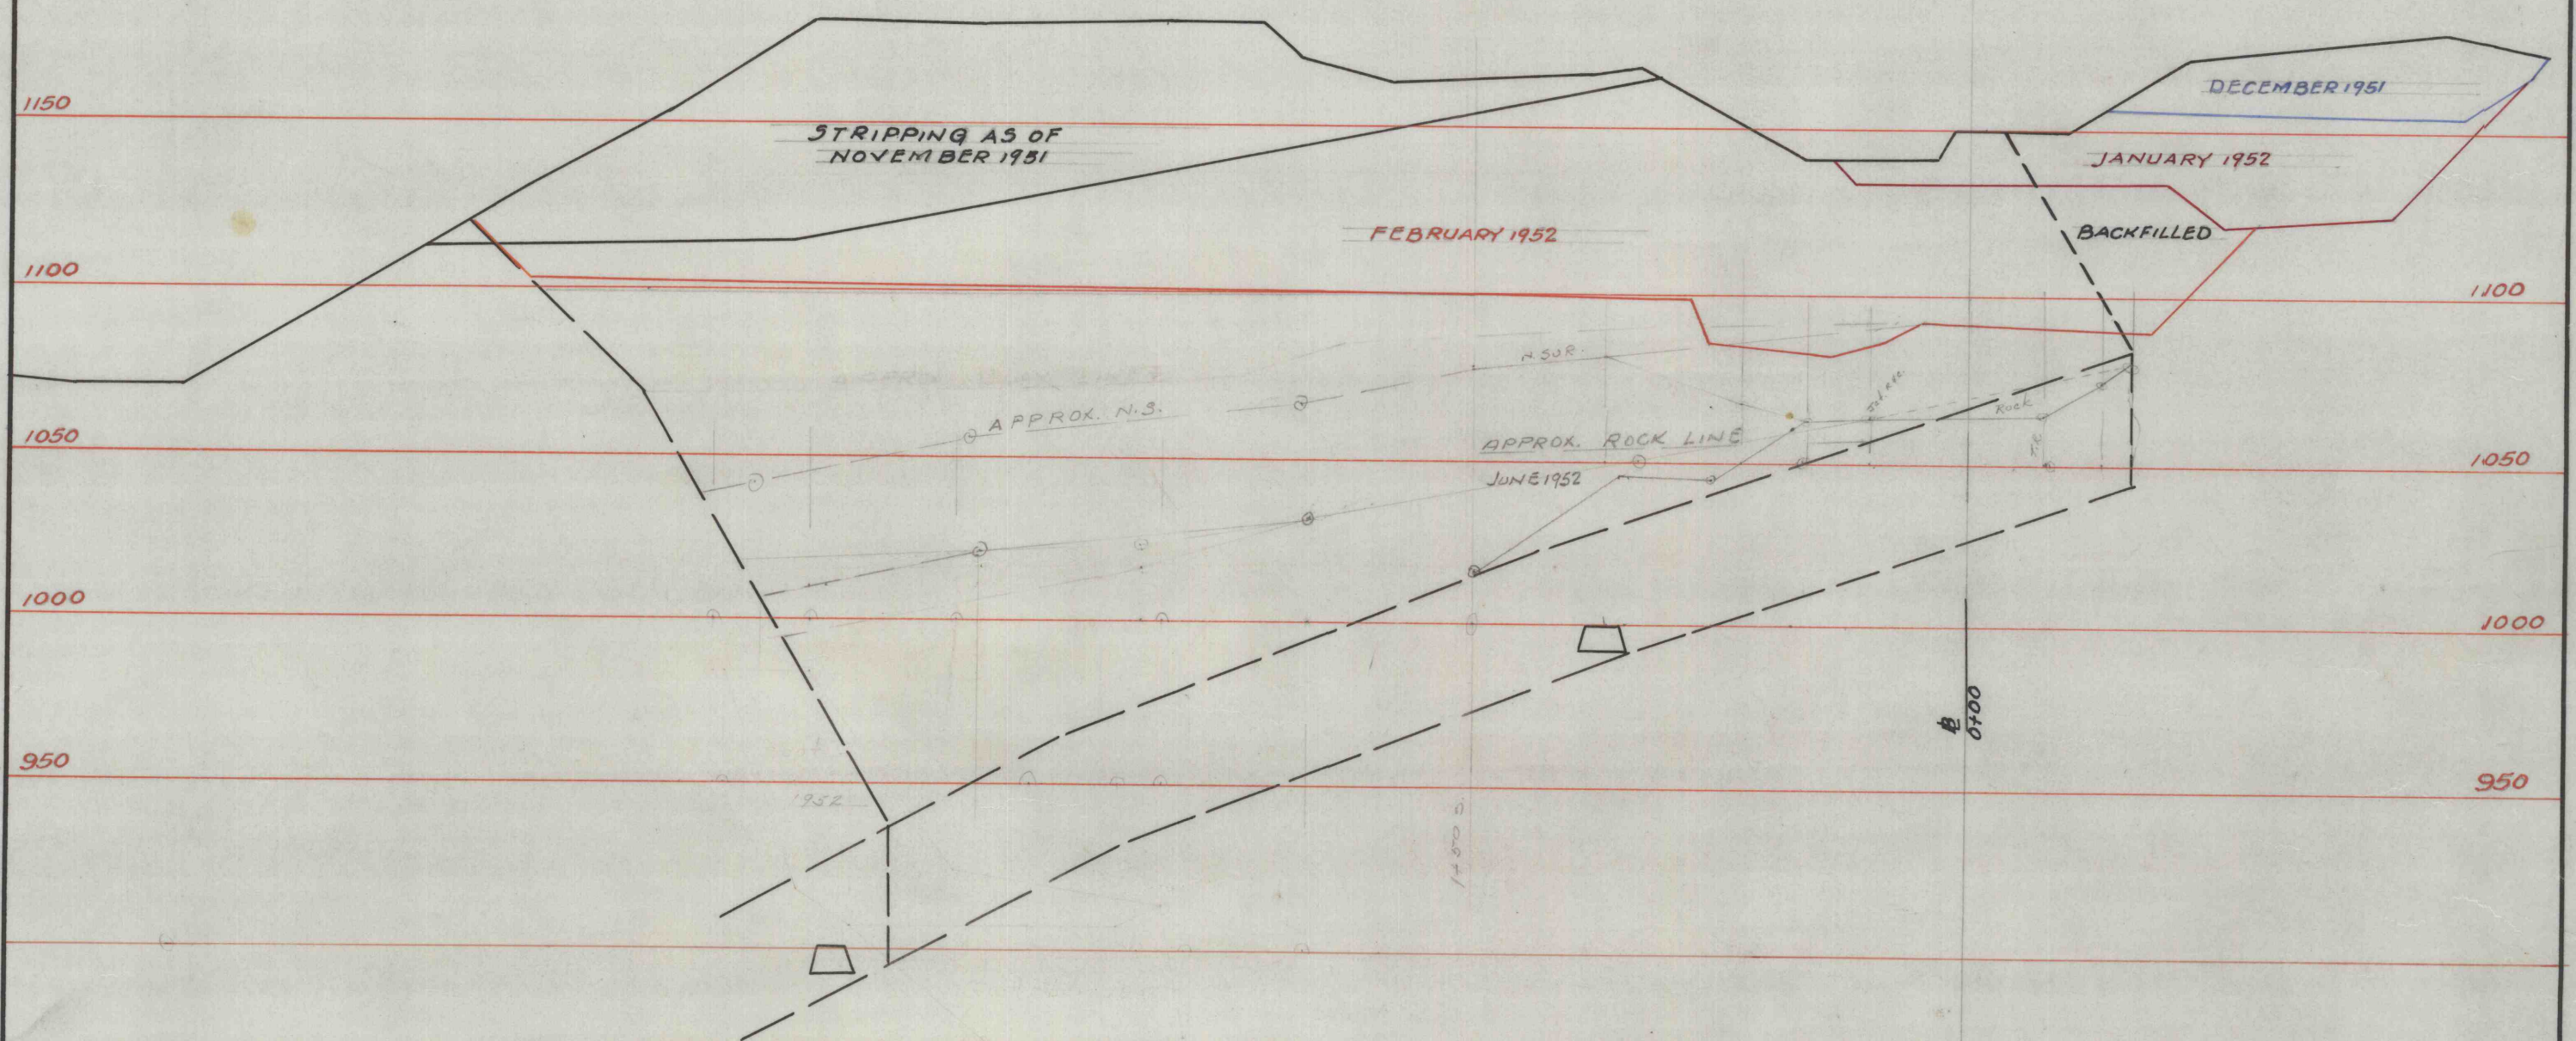

J. ROBERT BAZLEY, Inc.			
POTTSVILLE, PENNA.			
PACKER NO 10 STRIPPING			
WEST EXTENSION			
SECTION 5+00 WEST			
DATE	SCALE	BY	DRW. NO.
12-51	1"=50'		