


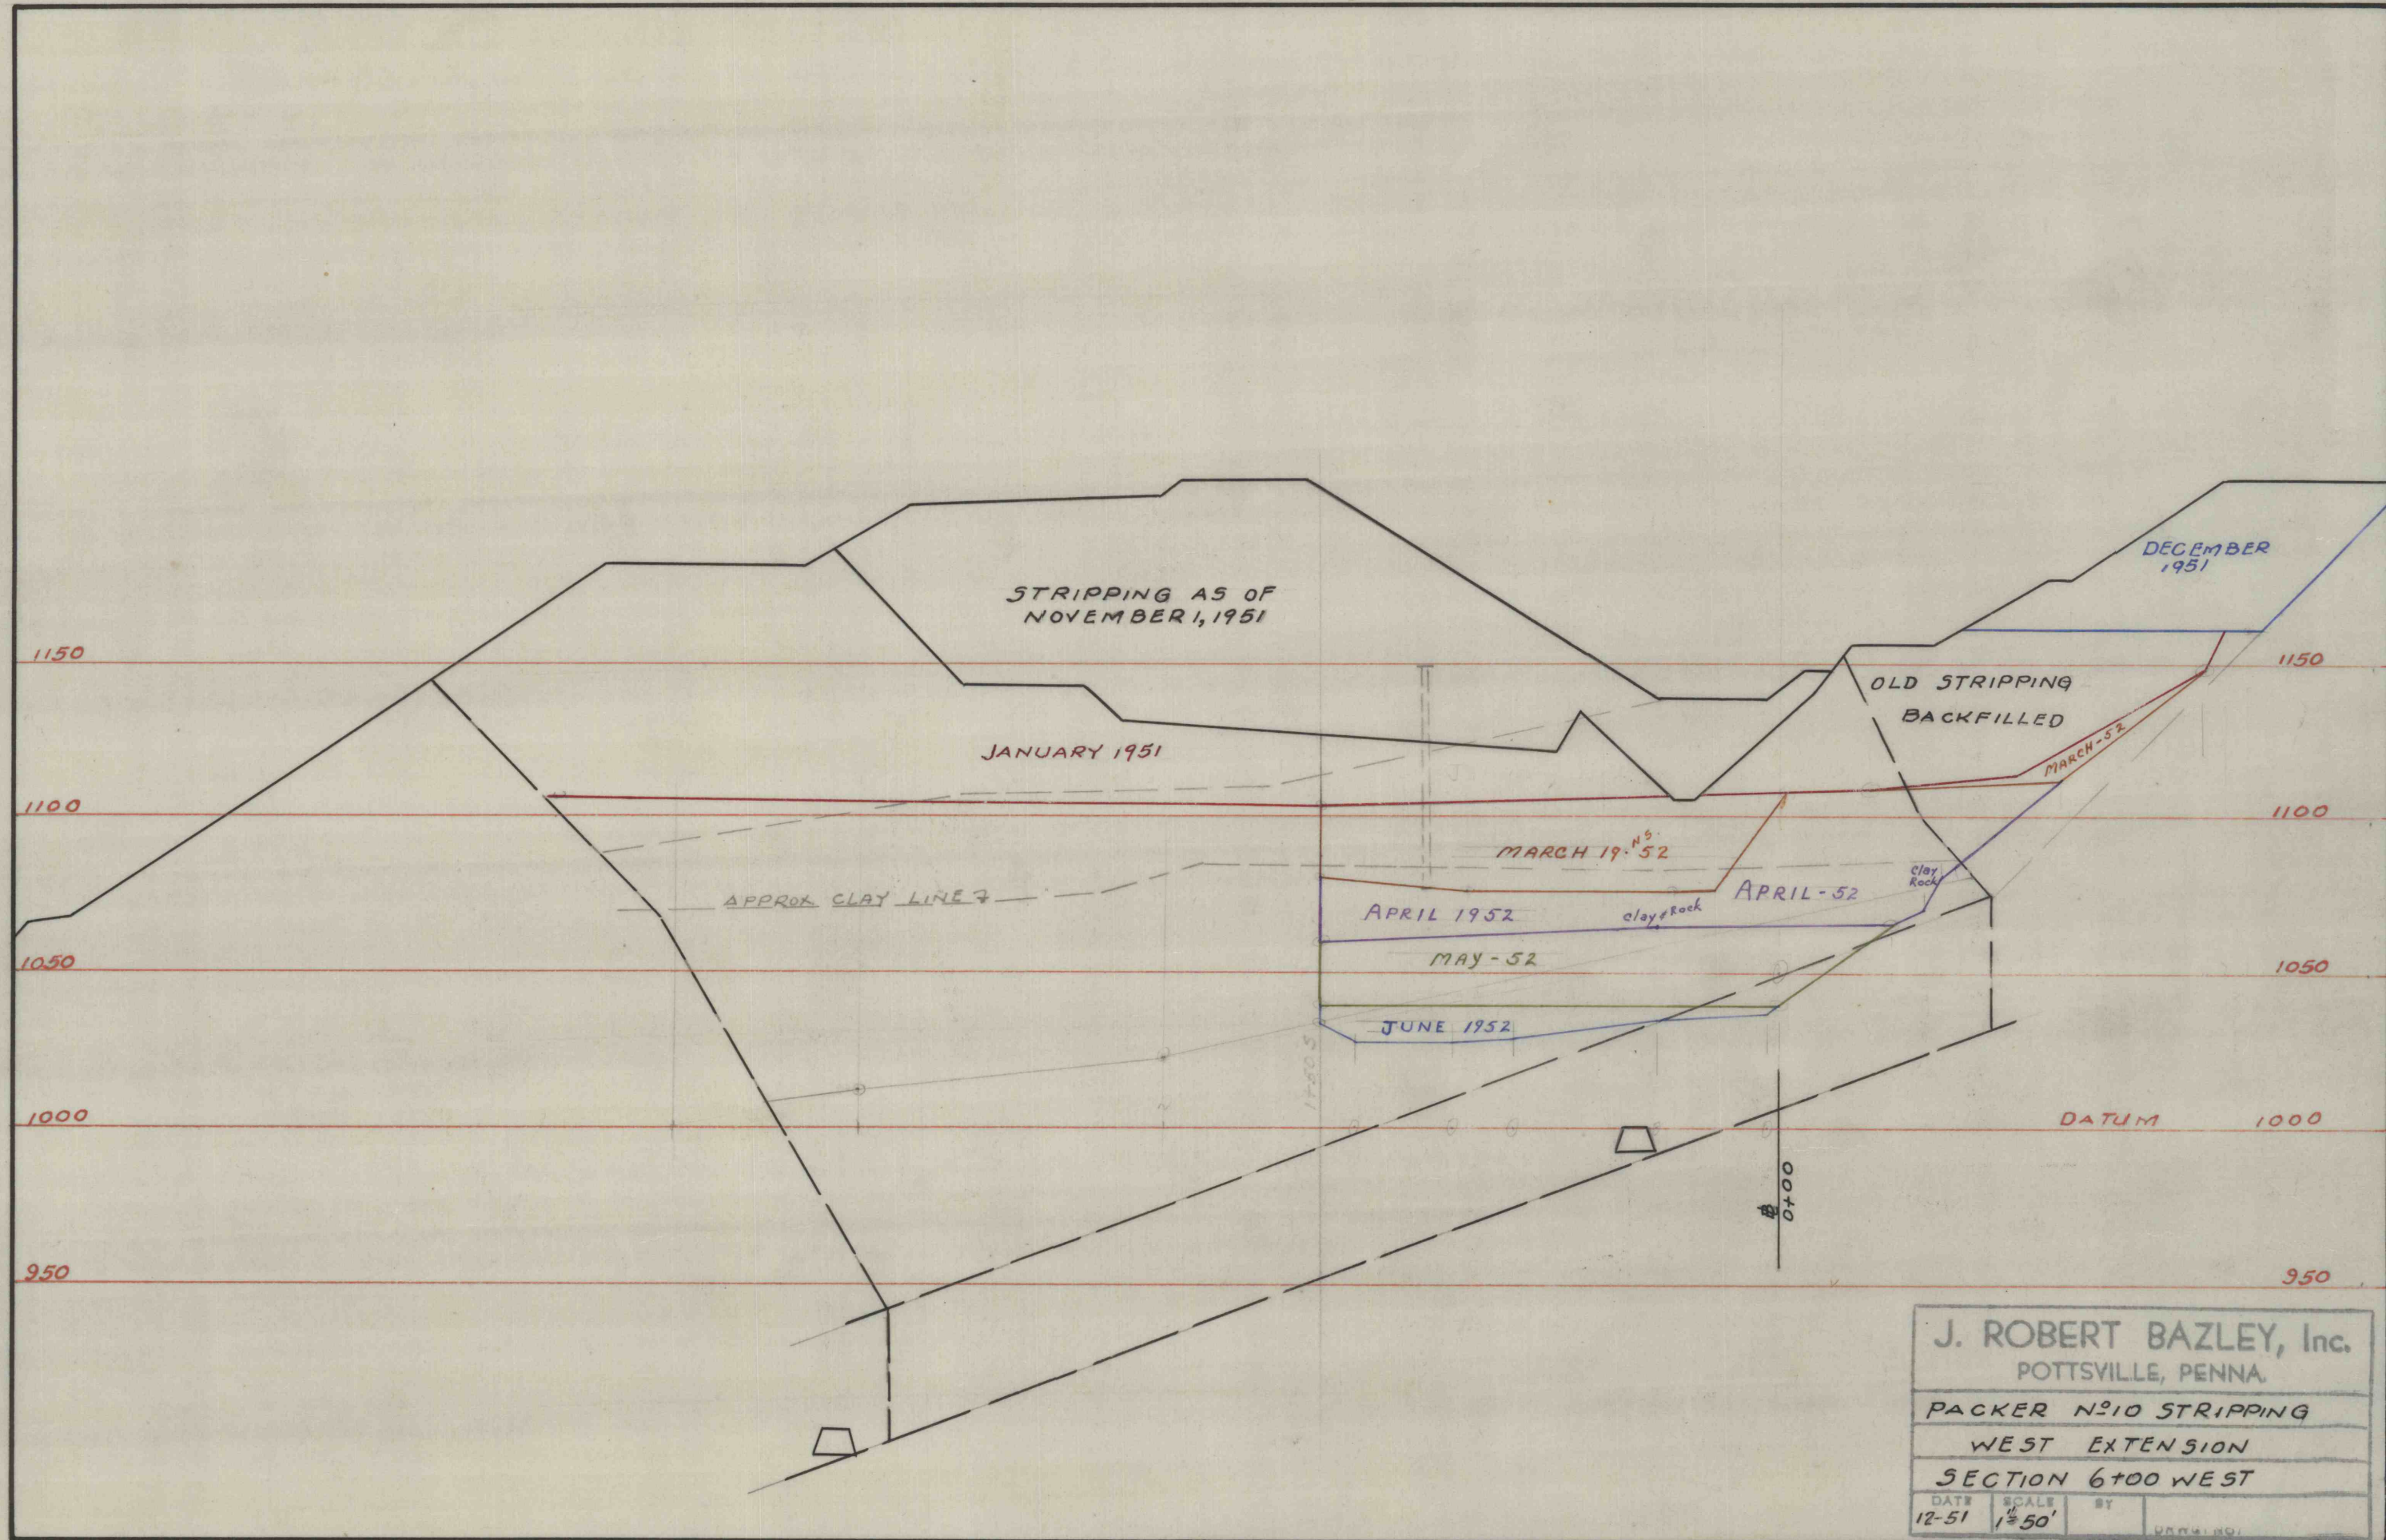

J. ROBERT BAZLEY, Inc.
POTTSVILLE, PENNA.

PACKER N^o10 STRIPPING
WEST EXTENSION
SECTION 6+00 WEST

DATE 12-51	SCALE 1"=50'	BY	DATE
---------------	-----------------	----	------