


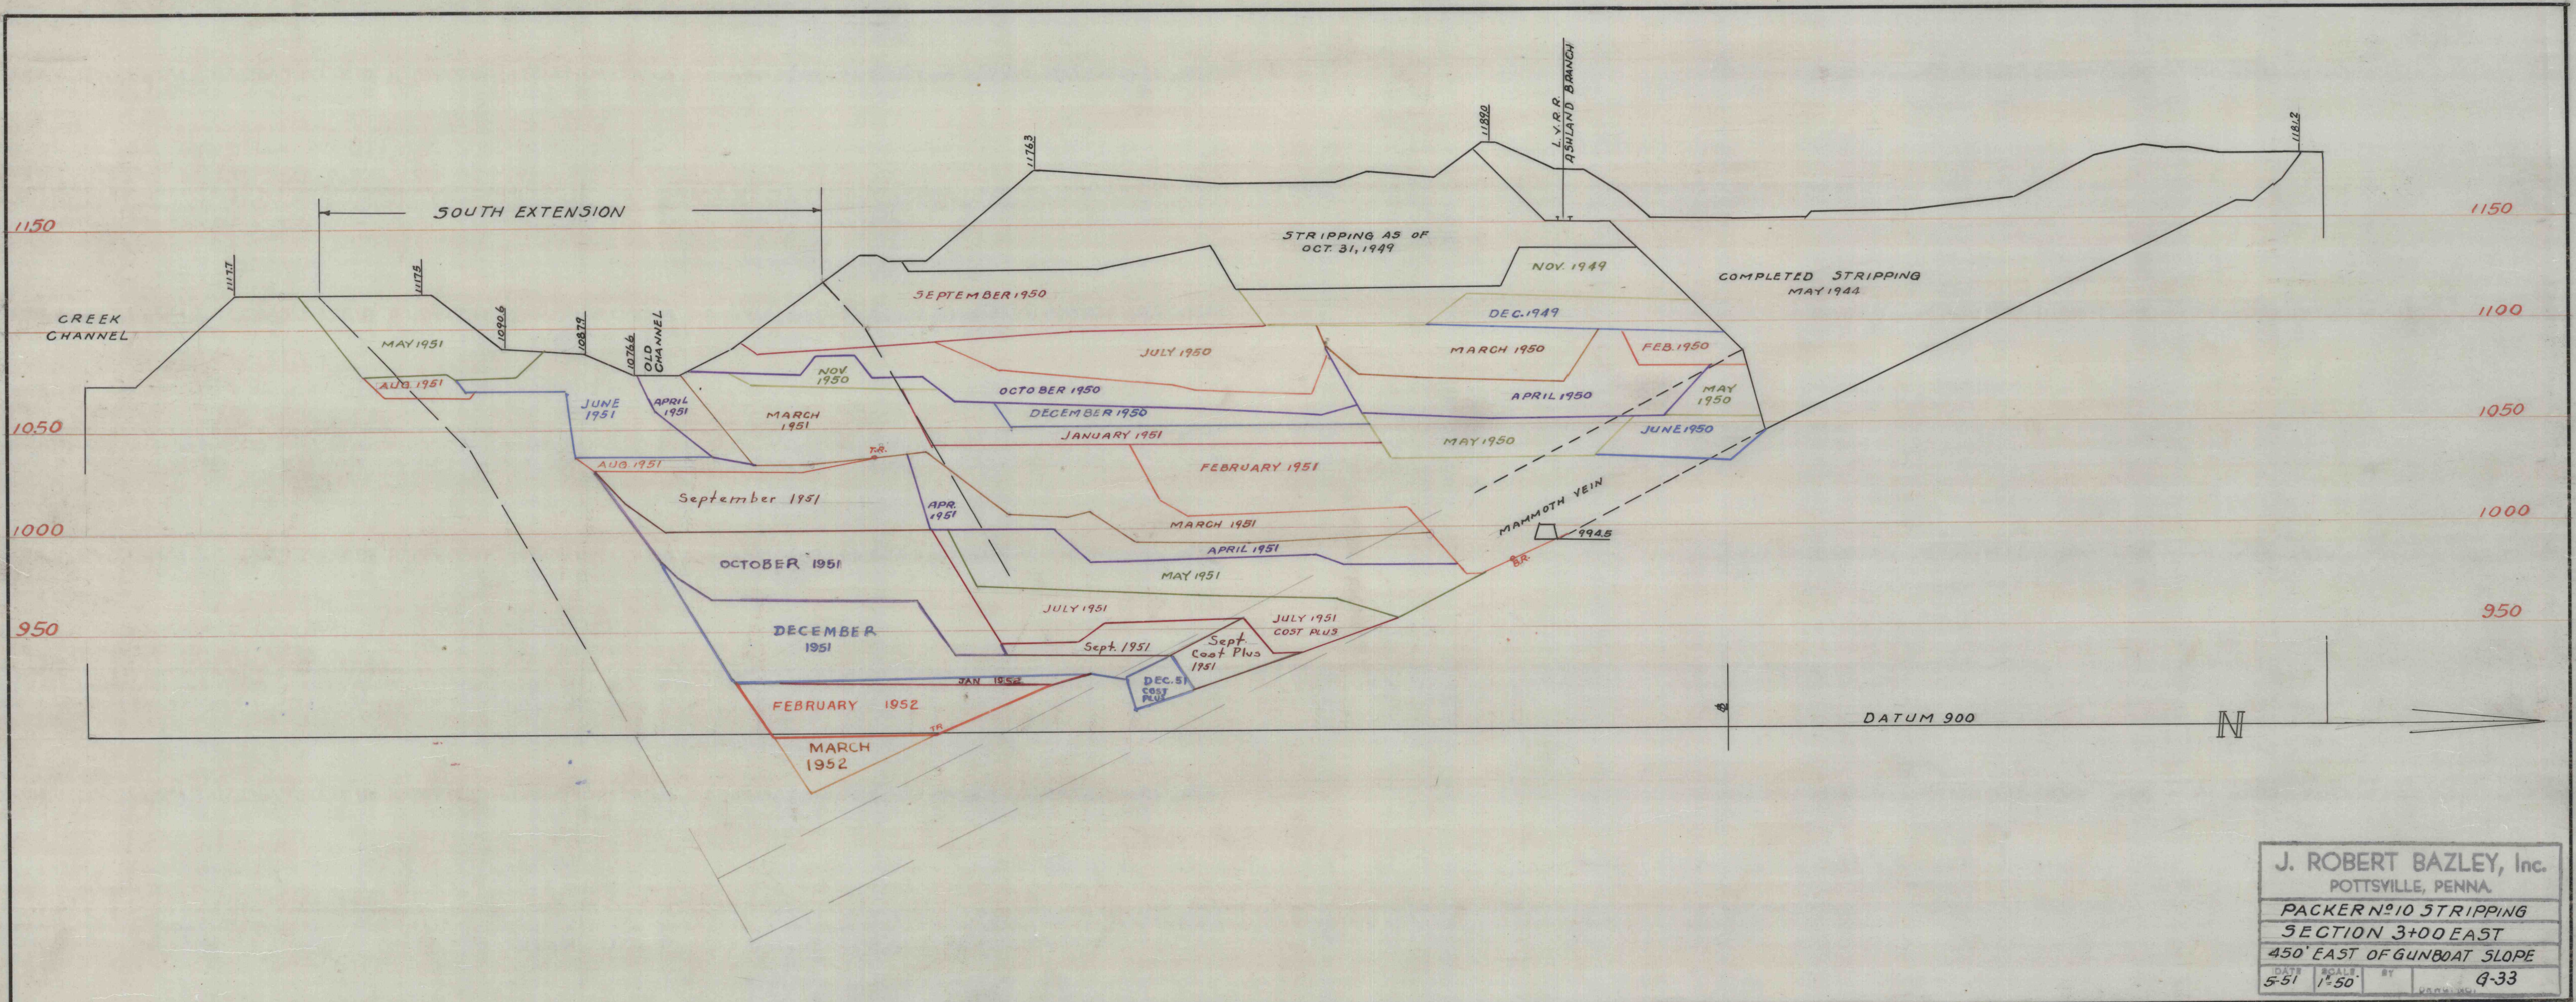

J. ROBERT BAZLEY, Inc.
POTTSVILLE, PENNA.
PACKER NO 10 STRIPPING
SECTION 3+00 EAST
450' EAST OF GUNBOAT SLOPE
DATE 5-51 SCALE 1"=50' BY G-33