


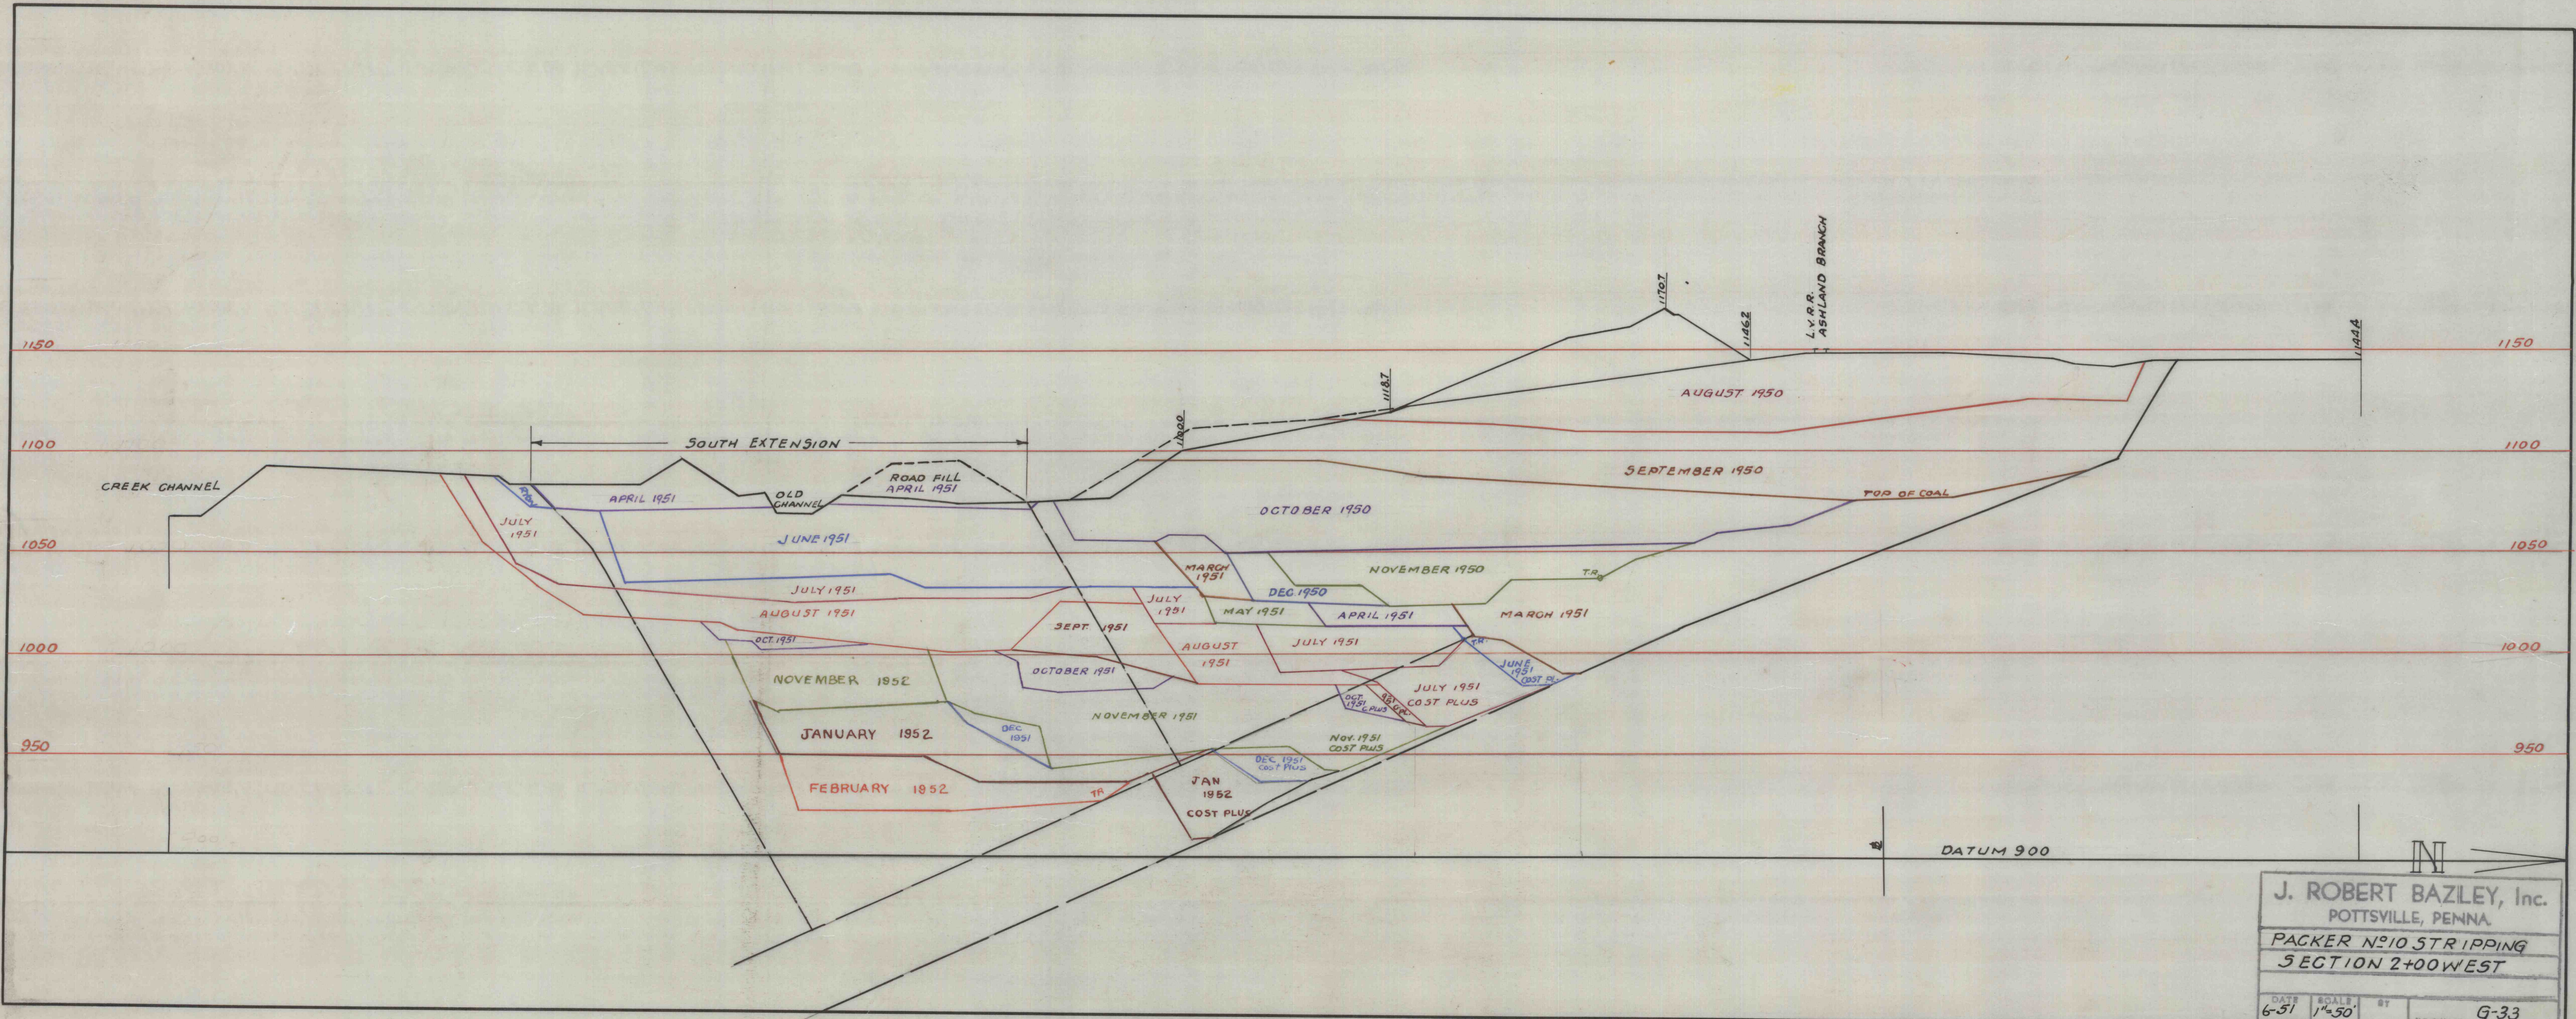

J. ROBERT BAZLEY, Inc.
POTTSVILLE, PENNA.
PACKER NO 10 STRIPPING
SECTION 2+00 WEST
DATE 6-51 SCALE 1"=50' ST G-33

IVT-JW-1320