


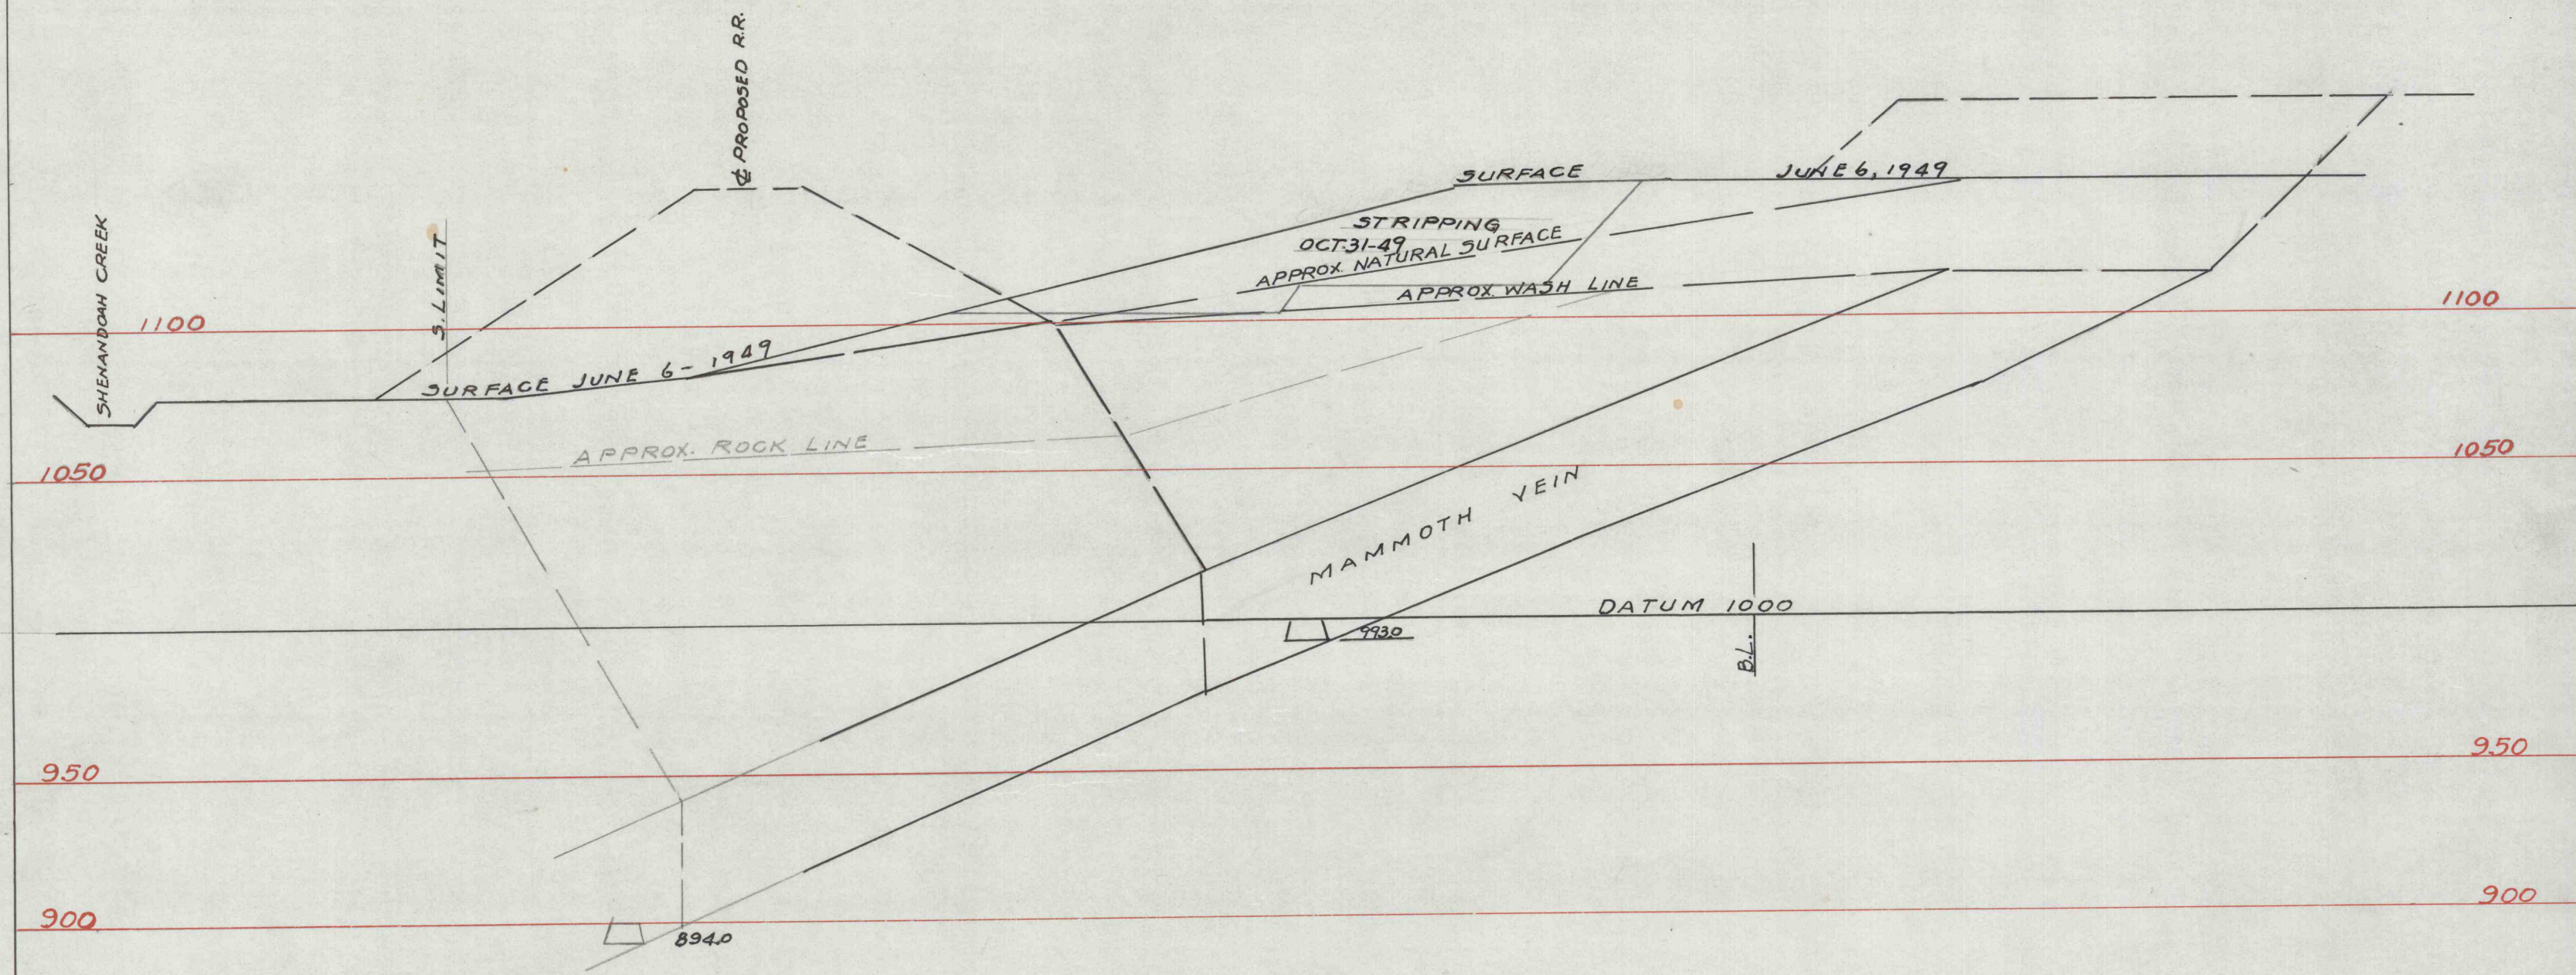

J. ROBERT BAZLEY, Inc.
POTTSVILLE, PENNA.
PACKER No 4 STRIPPING
SECTION 2+80 WEST
150 F. WEST OF GUNBOAT SLOPE
DATE 4-49 SCALE 1"=50' BY G-33