


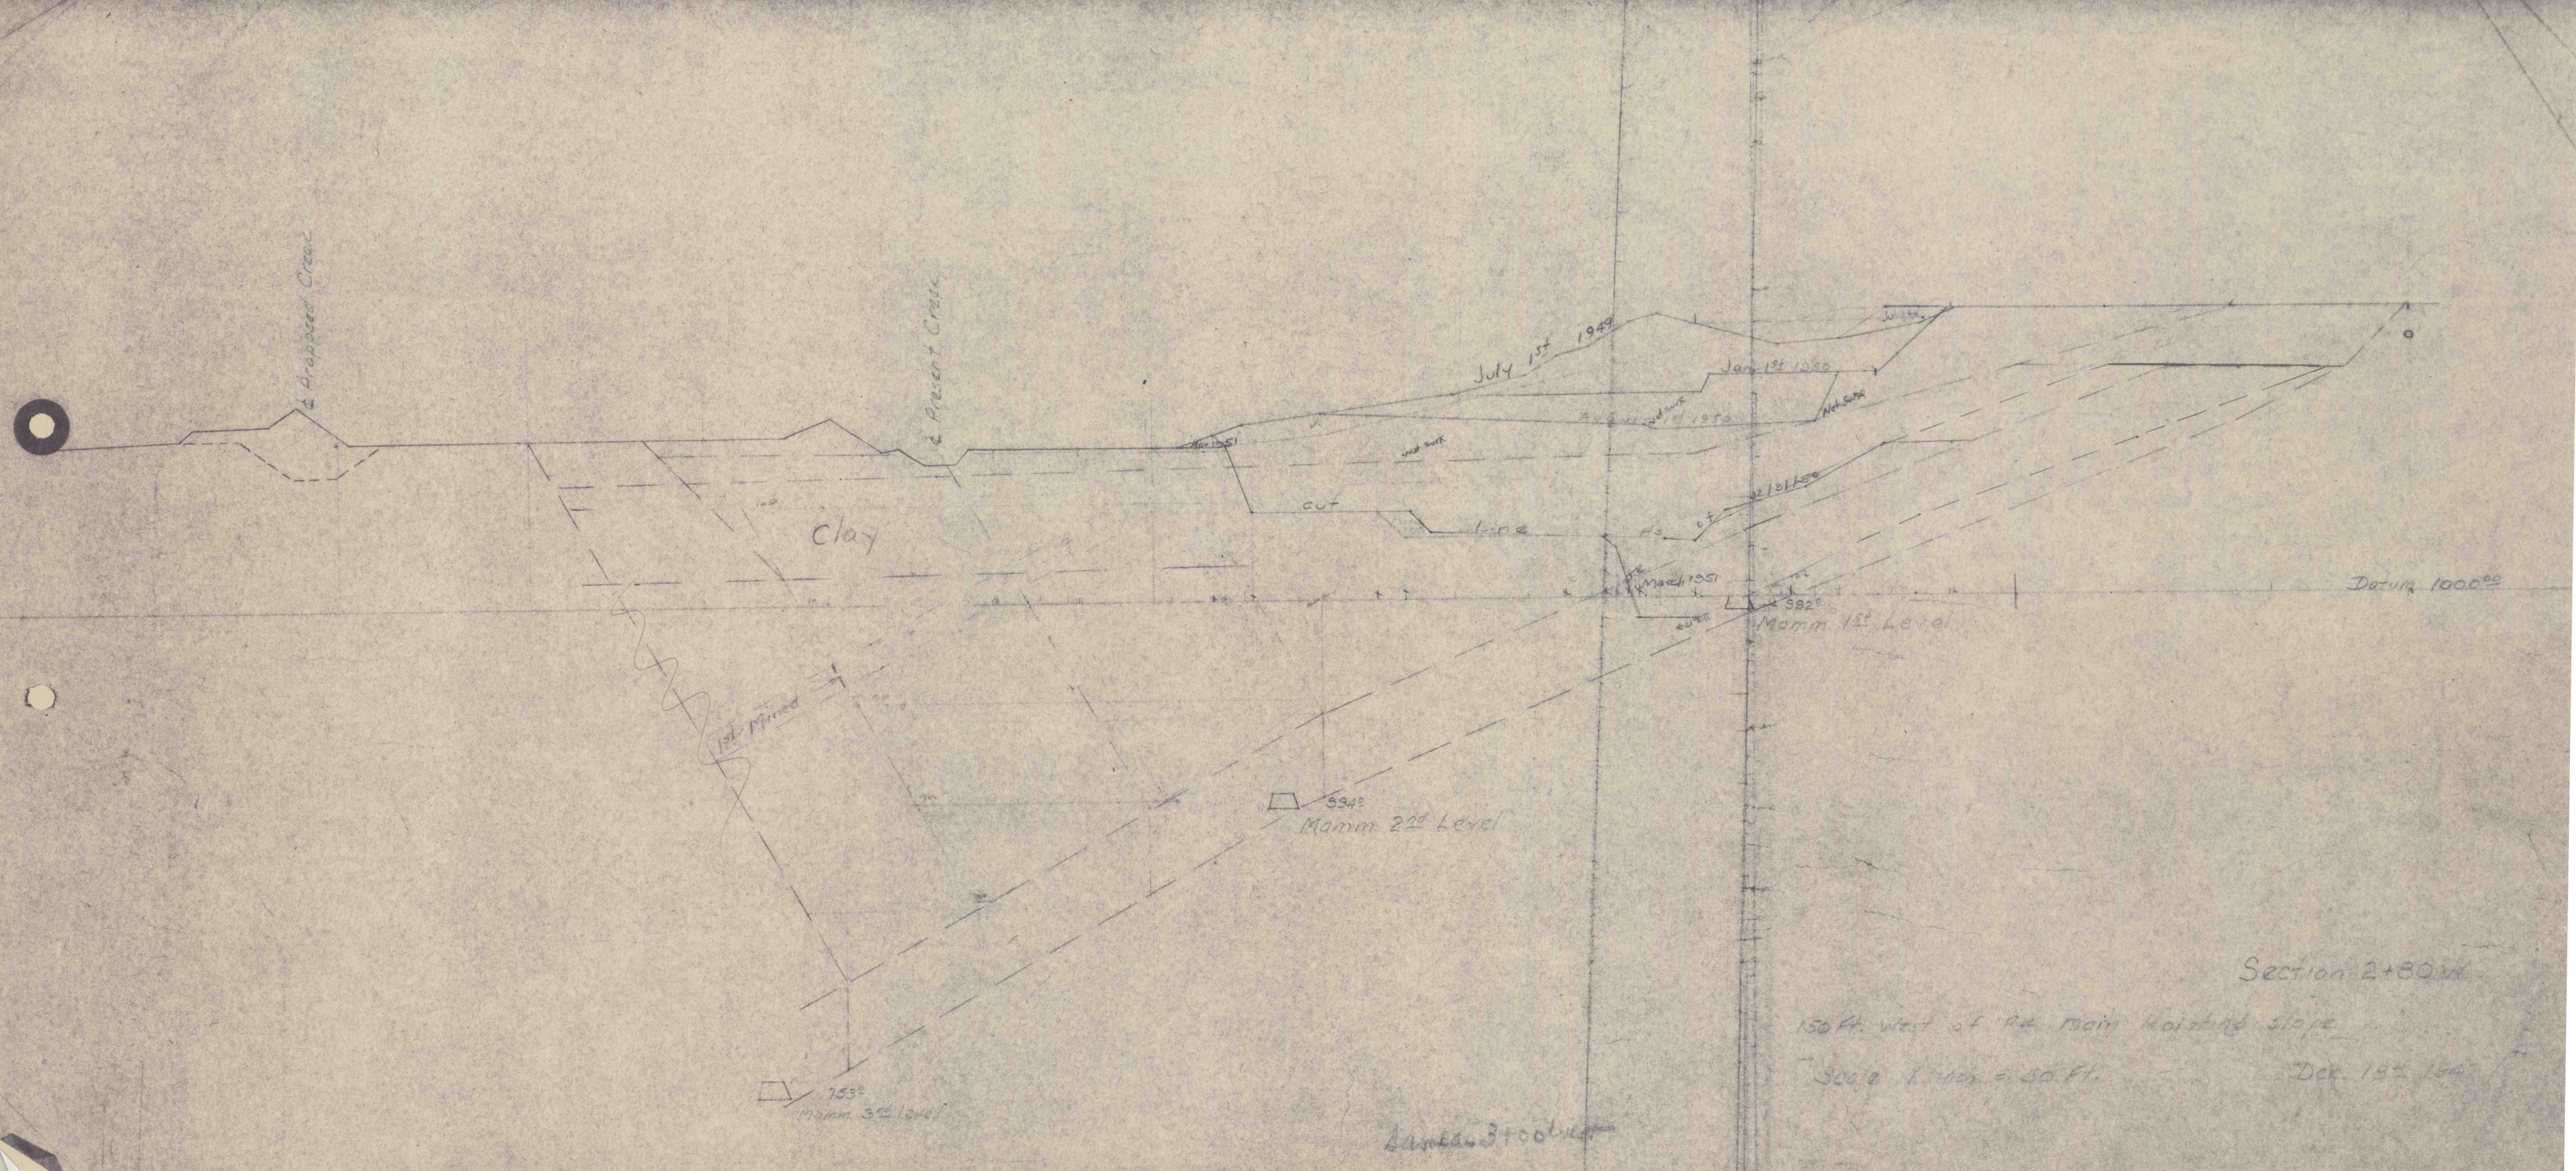

Proposed Creek

Present Creek

clay

cut

line

July 1st 1949

Jan 1st 1950

March 1951

July 1st 1951

Datum 1000.00

Mamm 1st Level

894
Mamm 2nd Level

1st Mined

753
Mamm 3rd Level

Section 2+80m

150 Ft. west of Pt. Main Hoisting slope

Scale 1 inch = 50 ft.

Dec. 18th 1949

