


posed Creek Channel

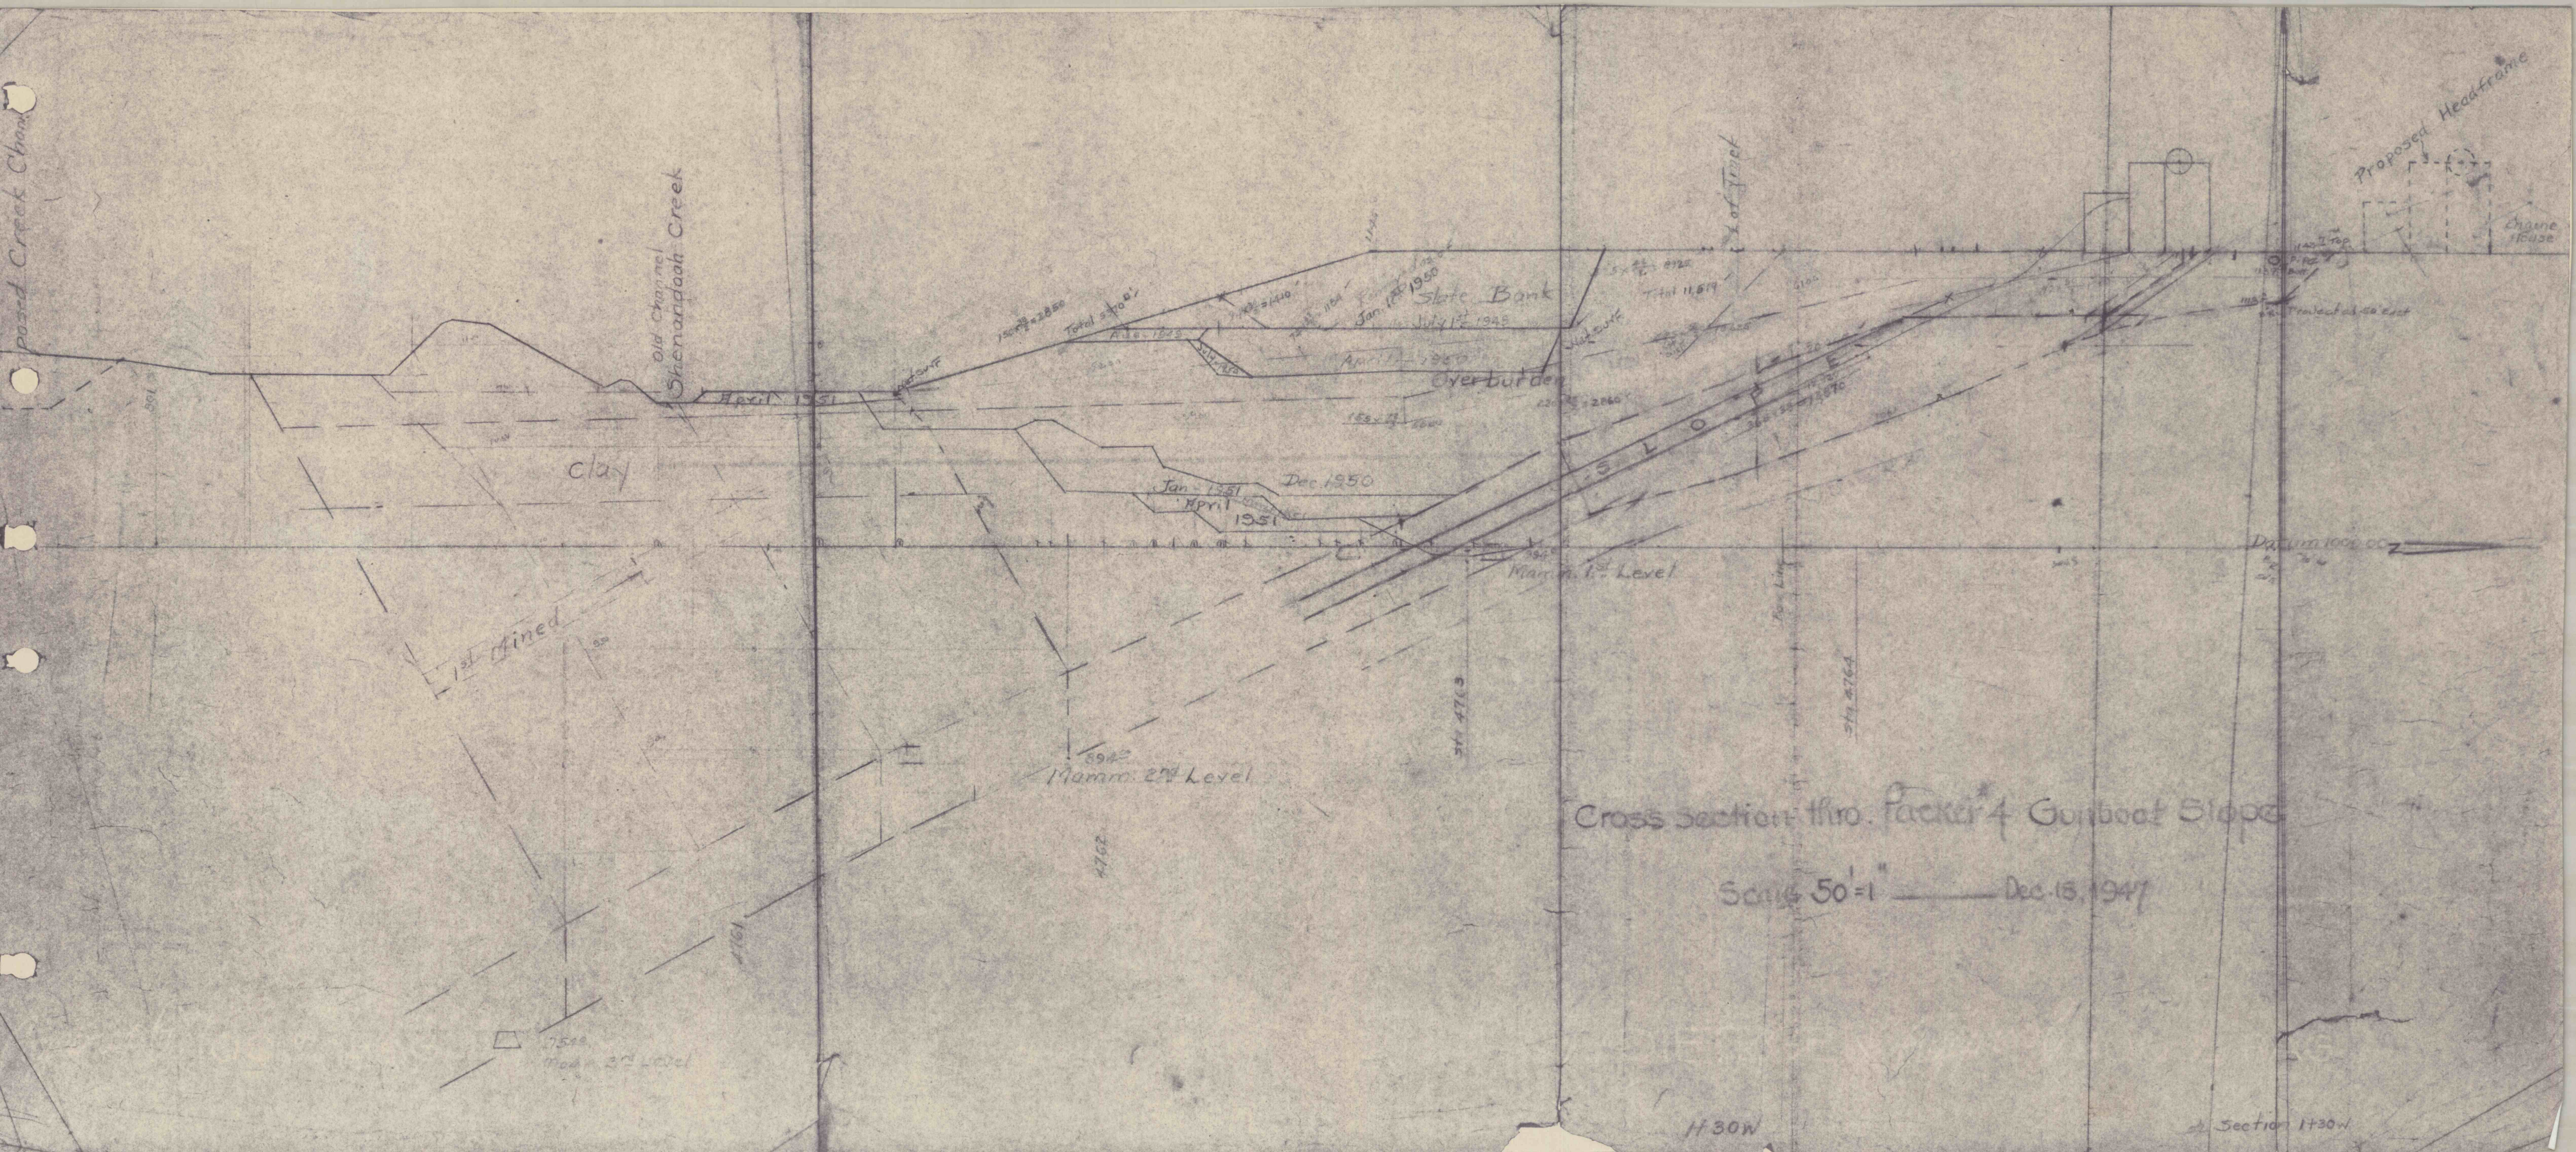

Cross section thro. Packer 4 Gunboat Slope

Scale 50' = 1" Dec 15, 1947

H 30W

Section 1+30W