


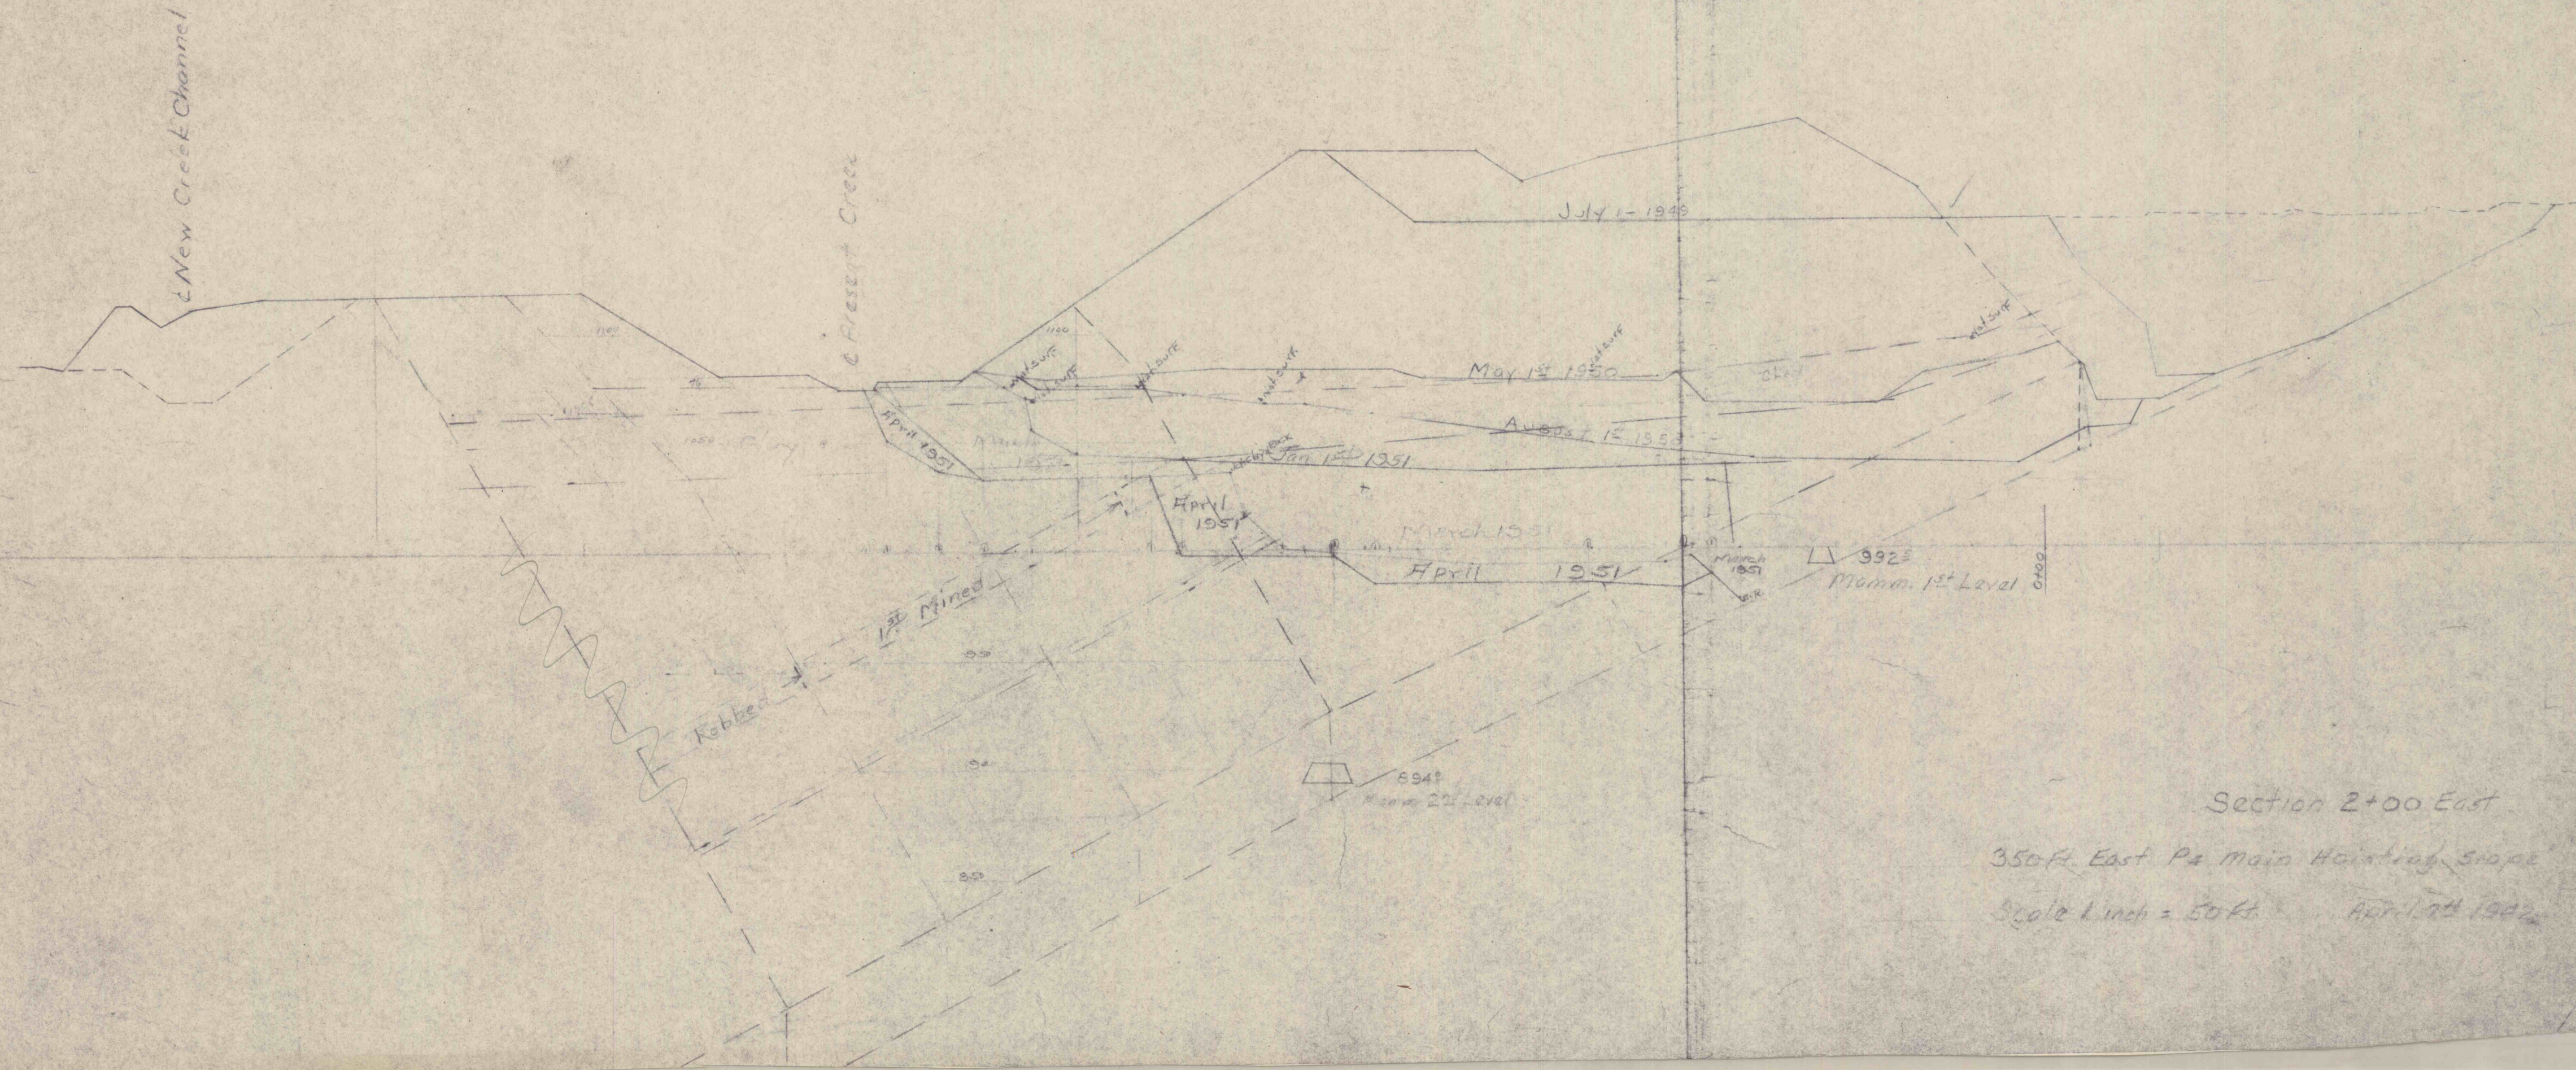

Section 2+00 East

350 ft East P4 main Haining slope

Scale 1 inch = 50 ft April 24 1942