


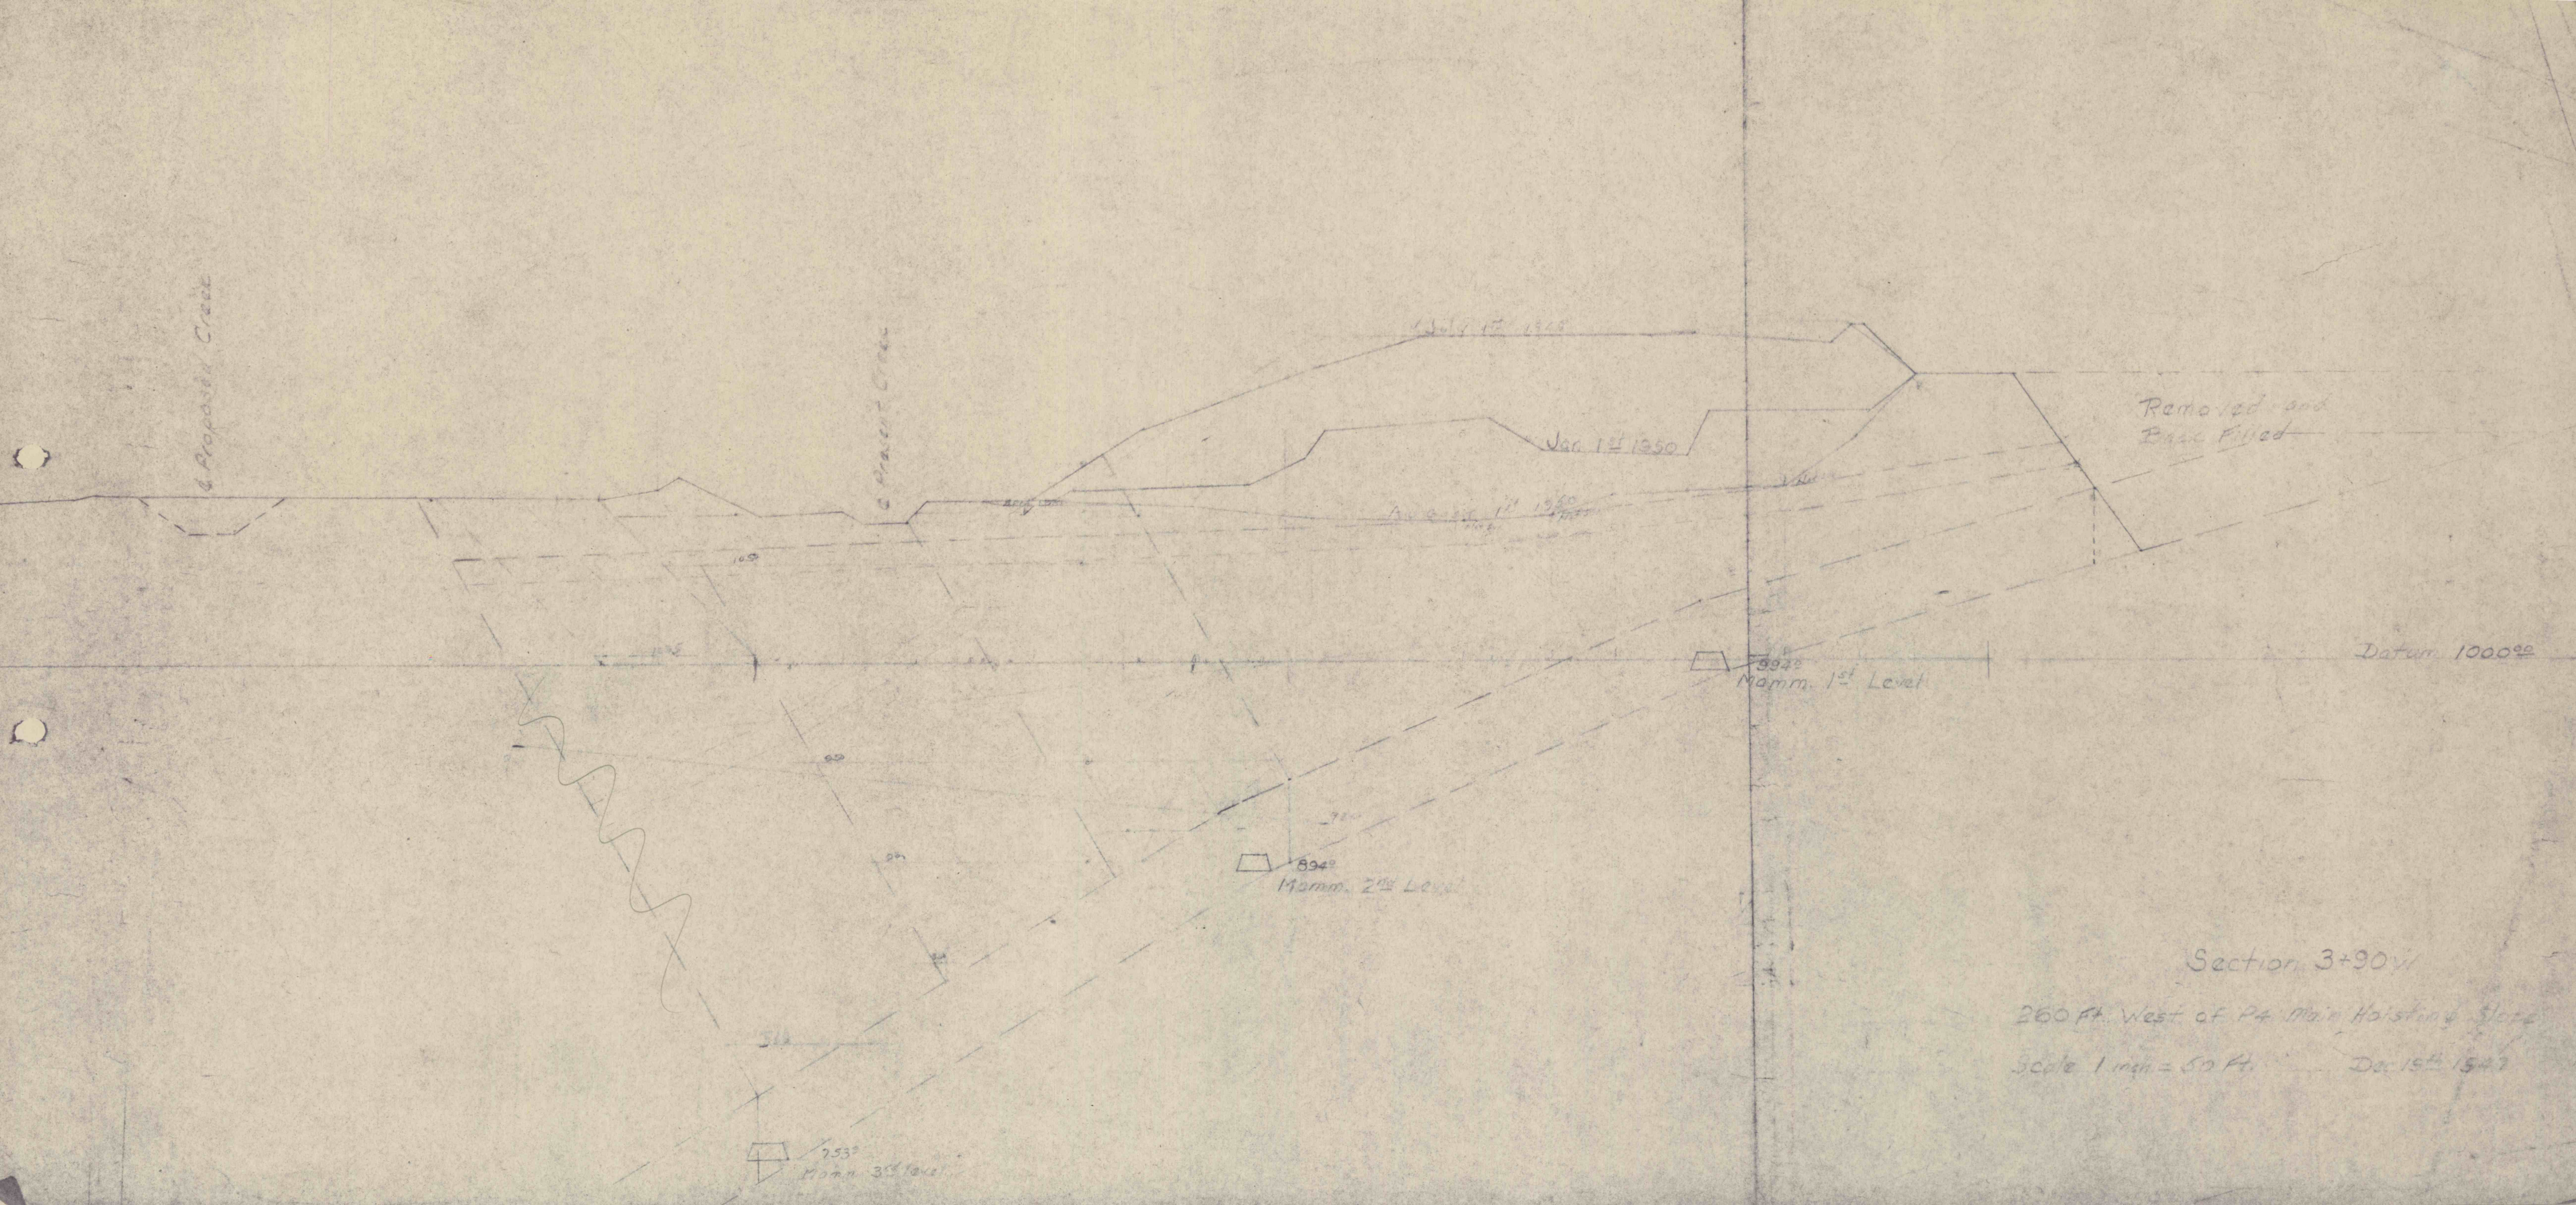

Proposed Creek

C. River Creek

July 12, 1948

Jan 1st 1950

Aug 2nd 1950

Removed and
Back Filled

Datum 1000'±

8942
Mamm. 1st Level

8940
Mamm. 2nd Level

753
Mamm. 3rd Level

Section 3+90 W

260 ft. West of P4 Main Hoisting Shaft

Scale 1 inch = 50 ft. Dec 15th 1947