


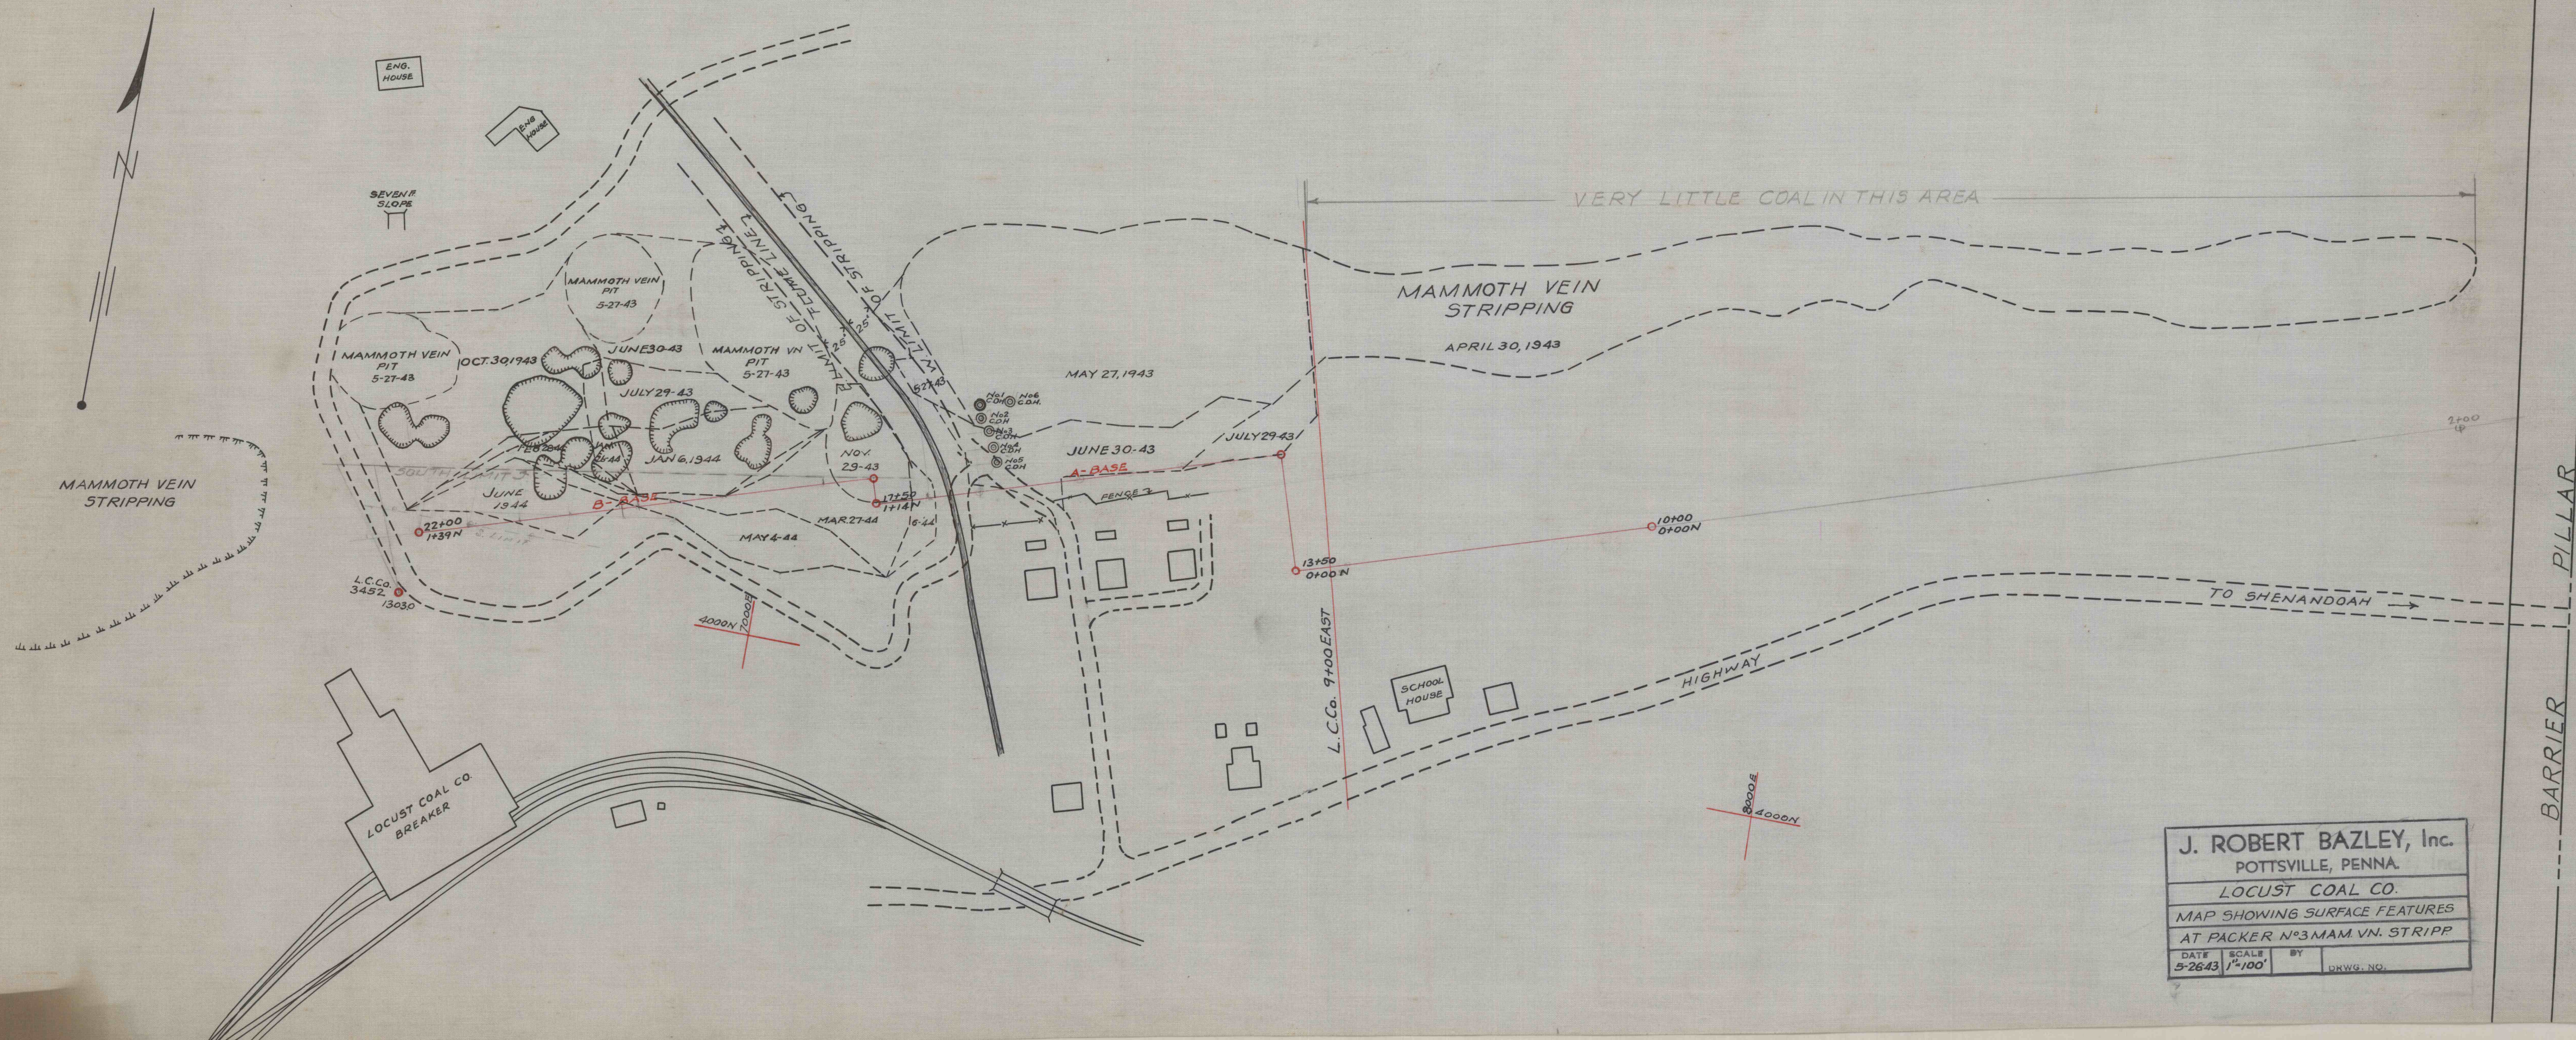

J. ROBERT BAZLEY, Inc.
POTTSVILLE, PENNA.
LOCUST COAL CO.
MAP SHOWING SURFACE FEATURES
AT PACKER N°3 MAM. VN. STRIPP
DATE 5-26-43 SCALE 1"=100' BY DRWG. NO.