




16+50

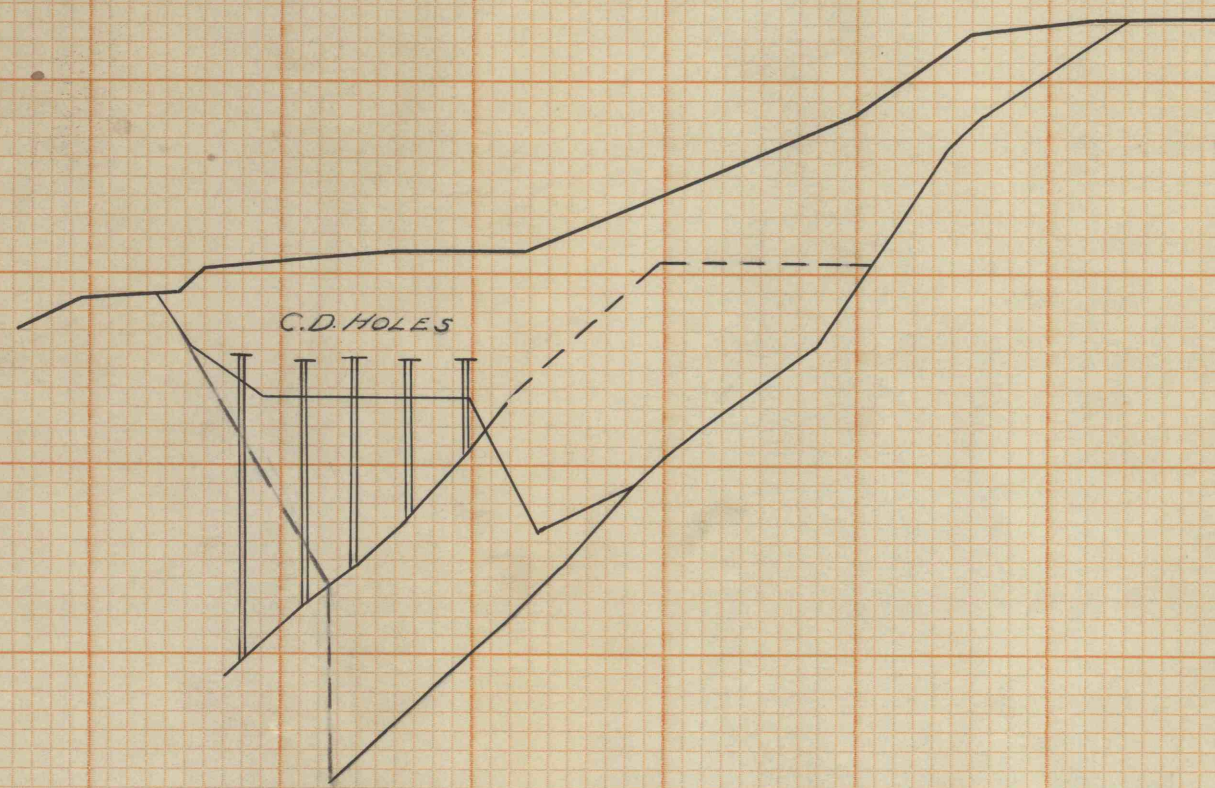

17+50

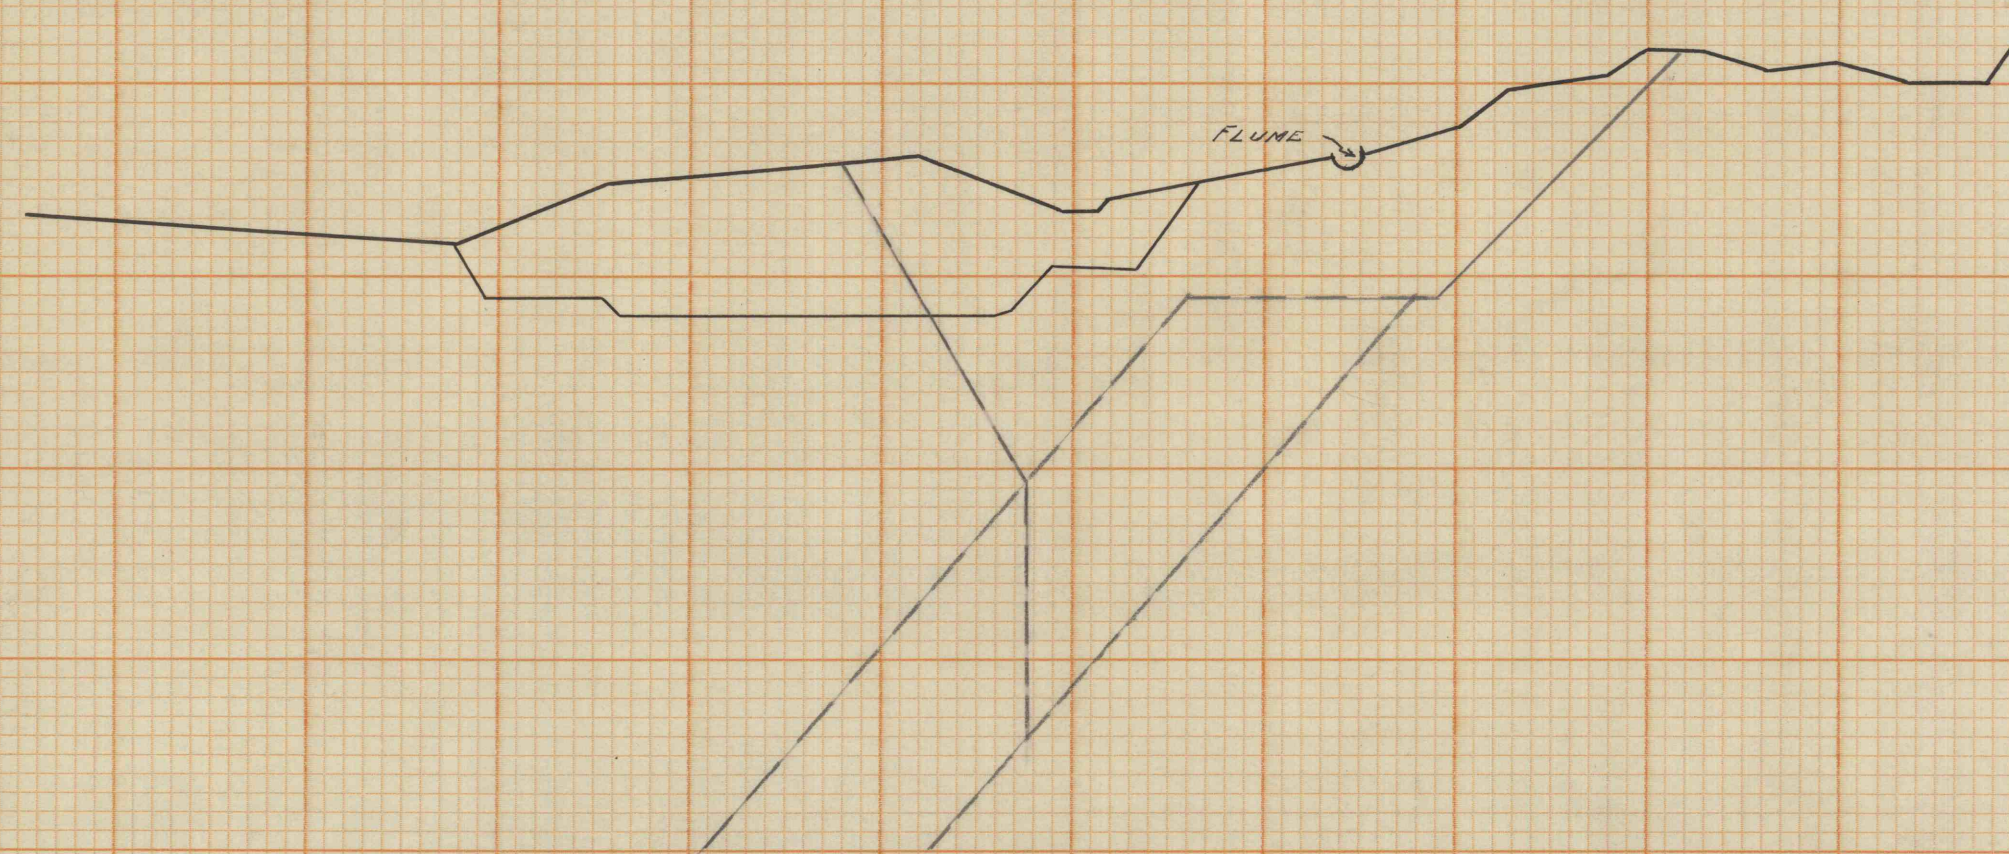


18+50

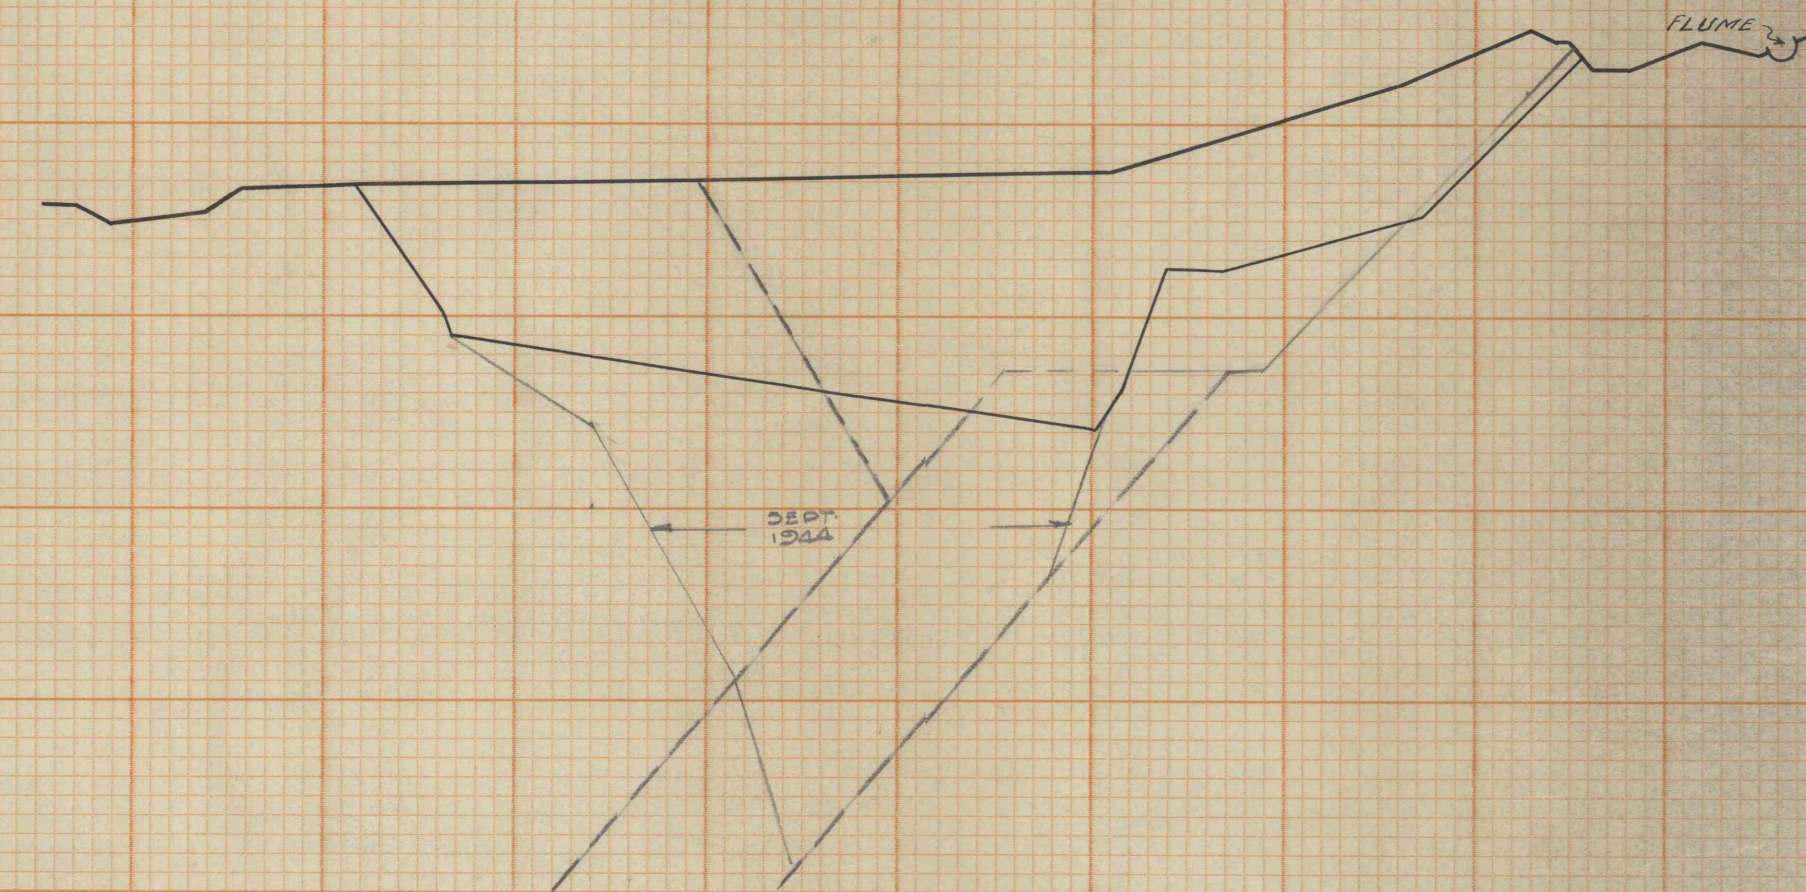

17+00



18+00

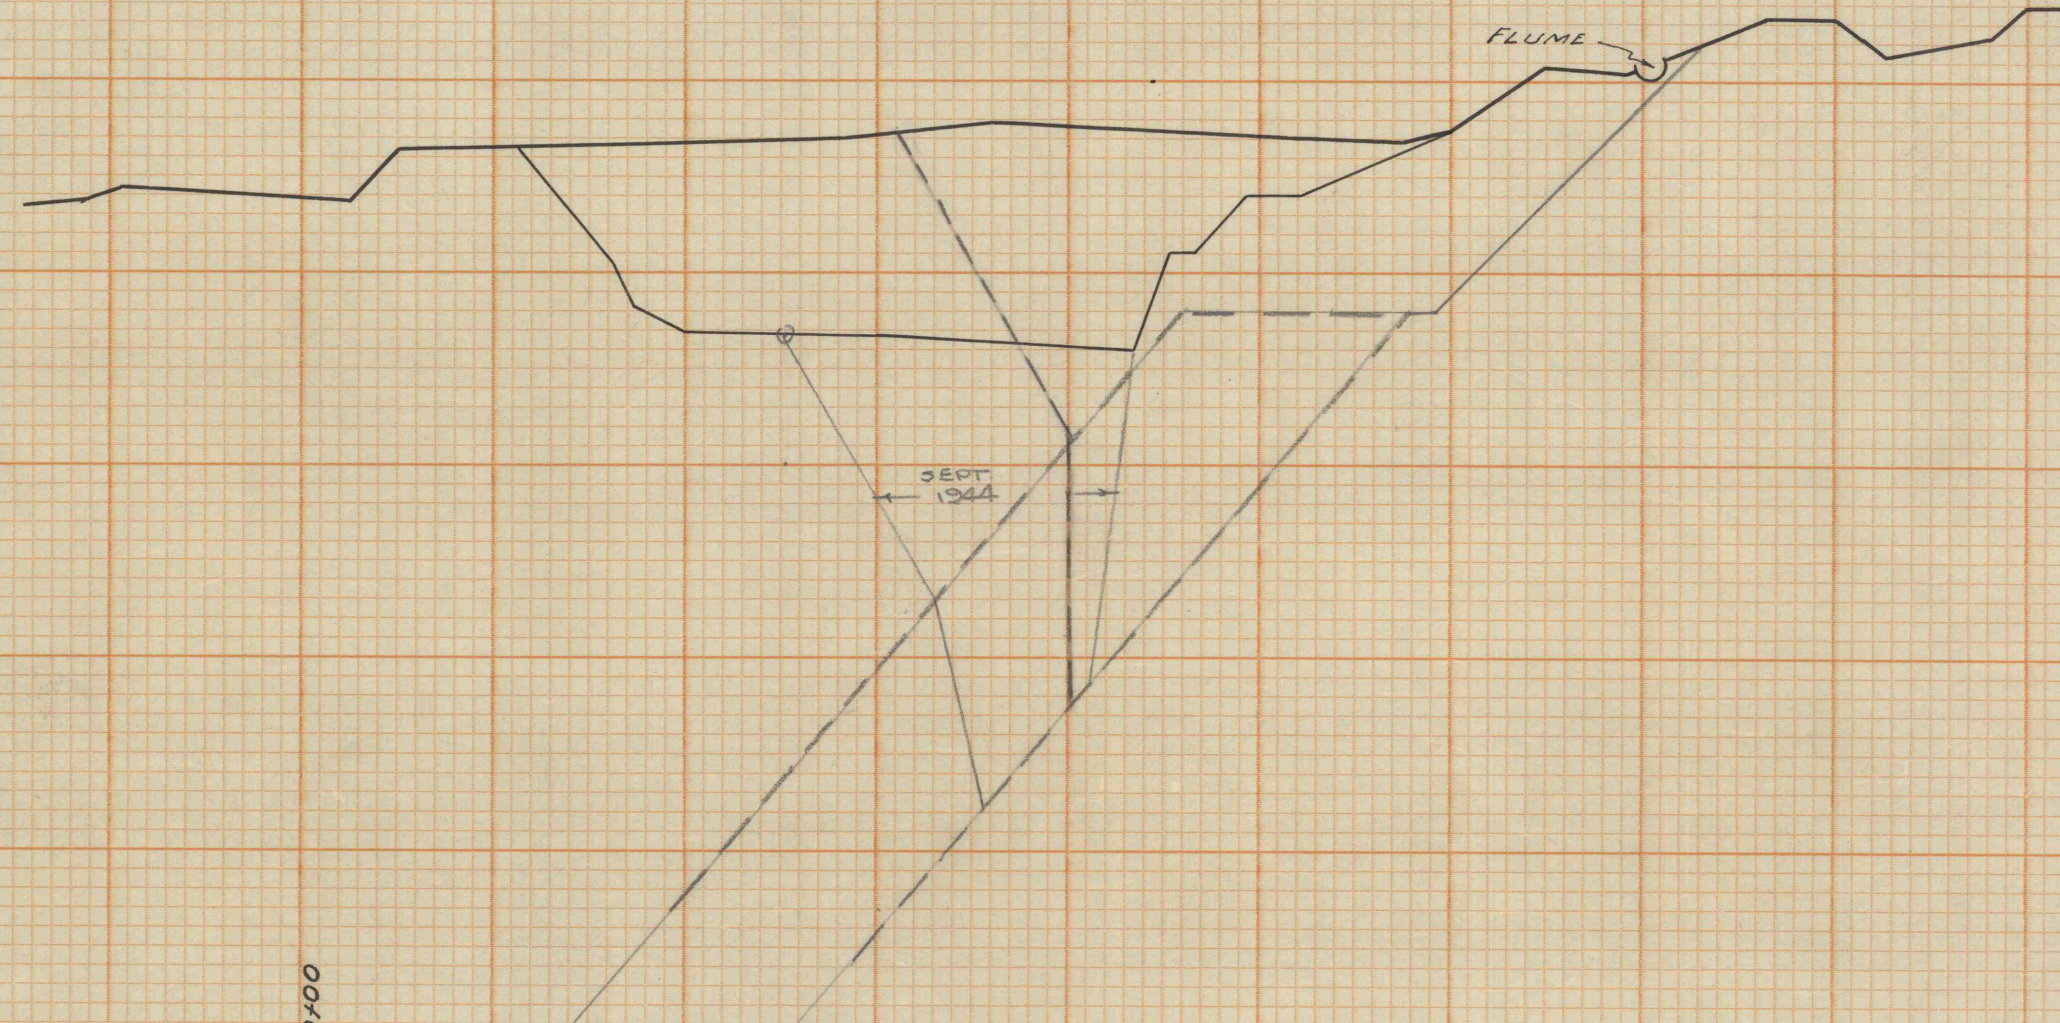

19+00

