


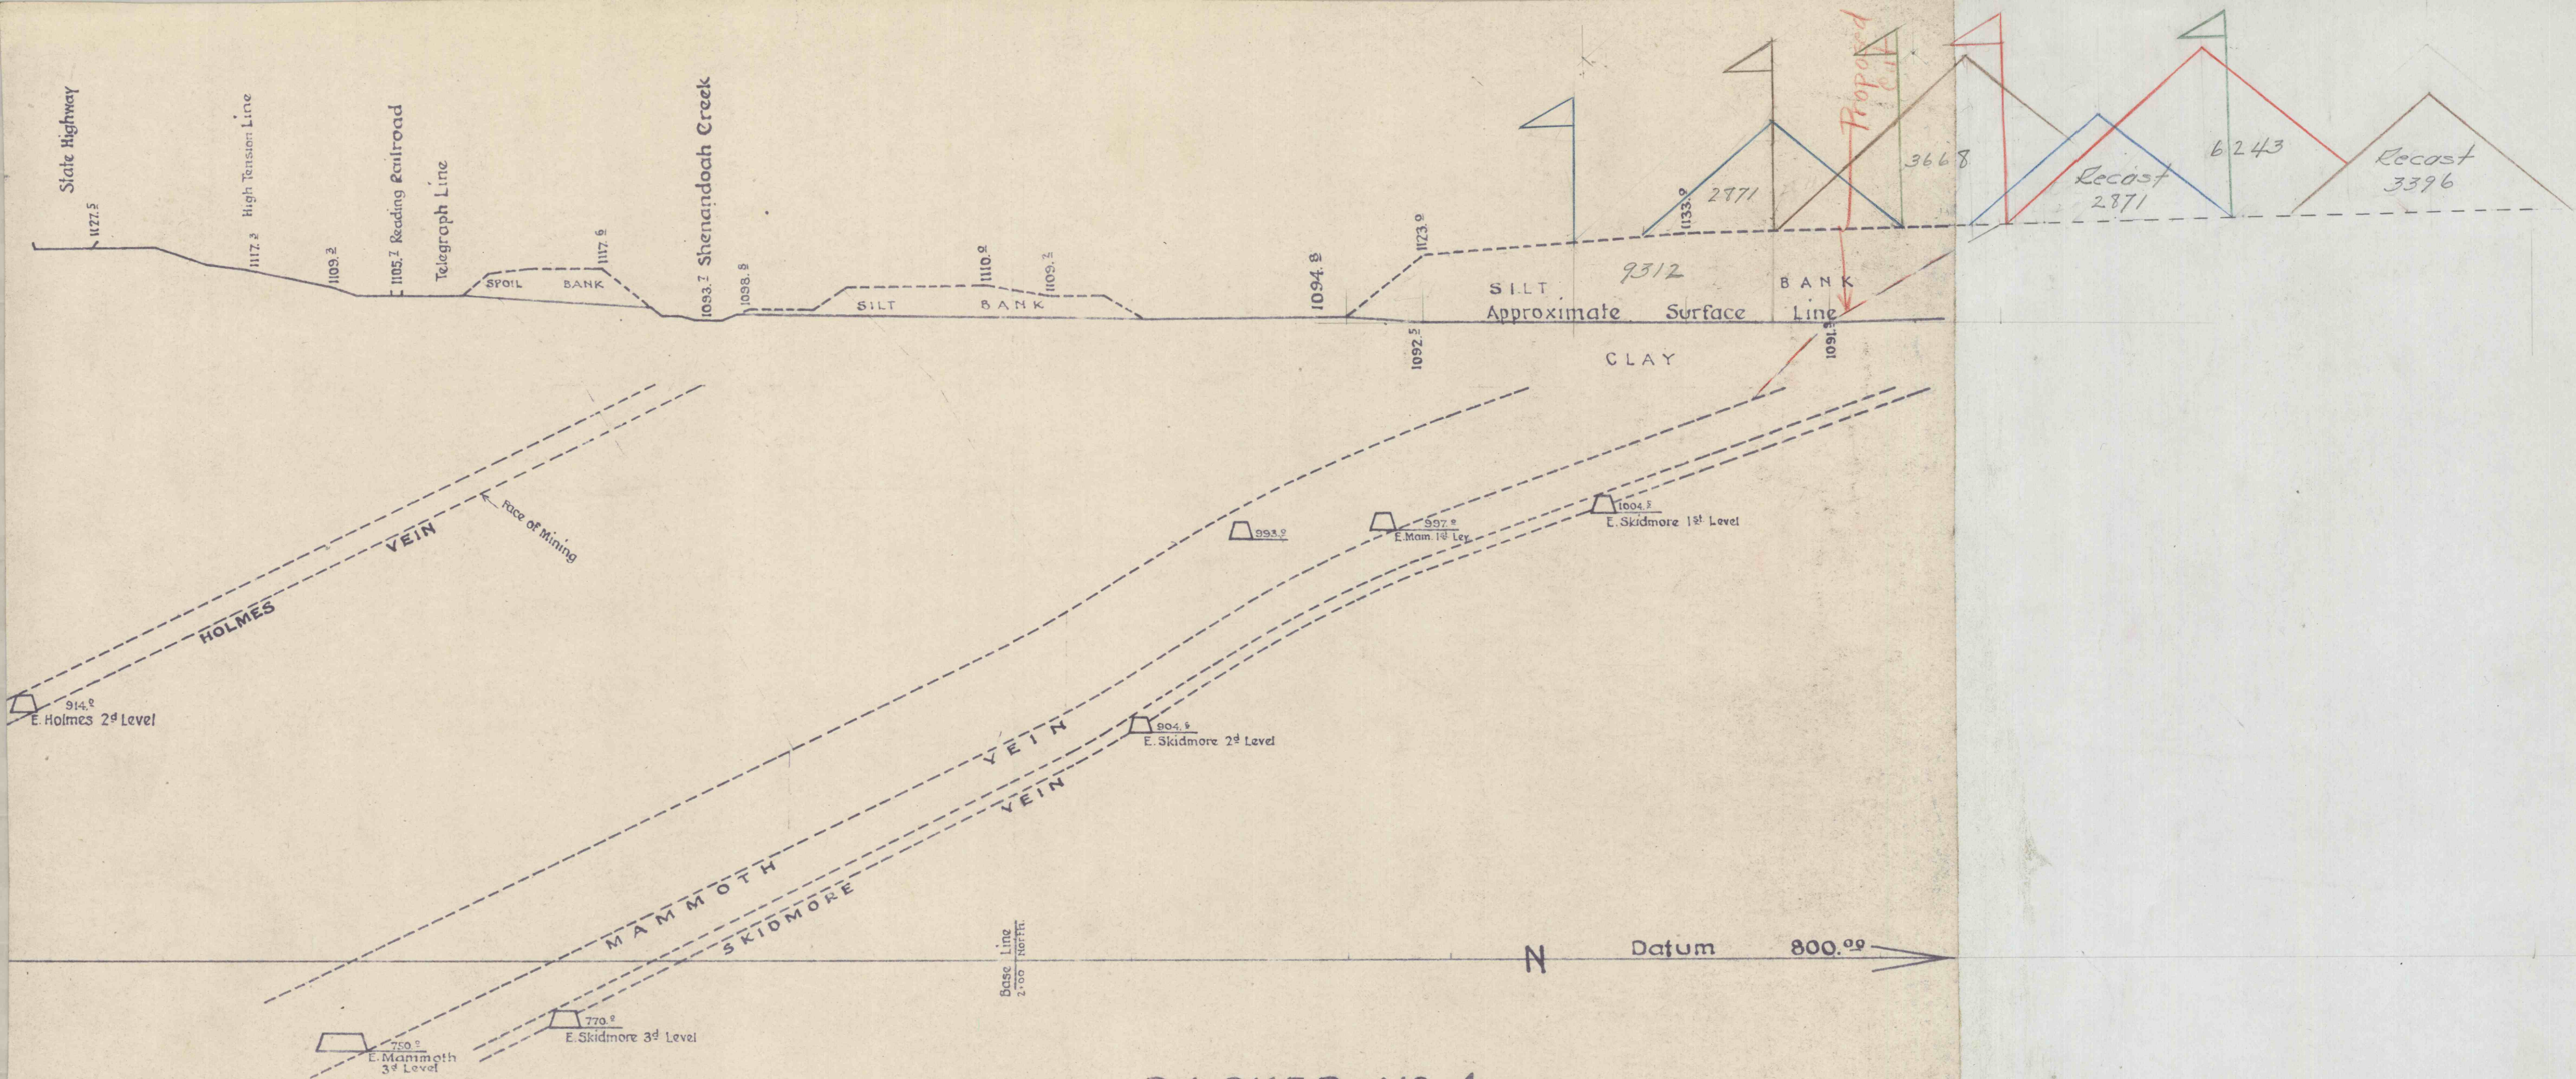

PACKER No 4
 SECTION 3100 FEET EAST OF MAMMOTH GUNBOAT SLOPE
 SCALE 50' = 1" OCT. 1944 ENG. DEPT. L.C.CO.