


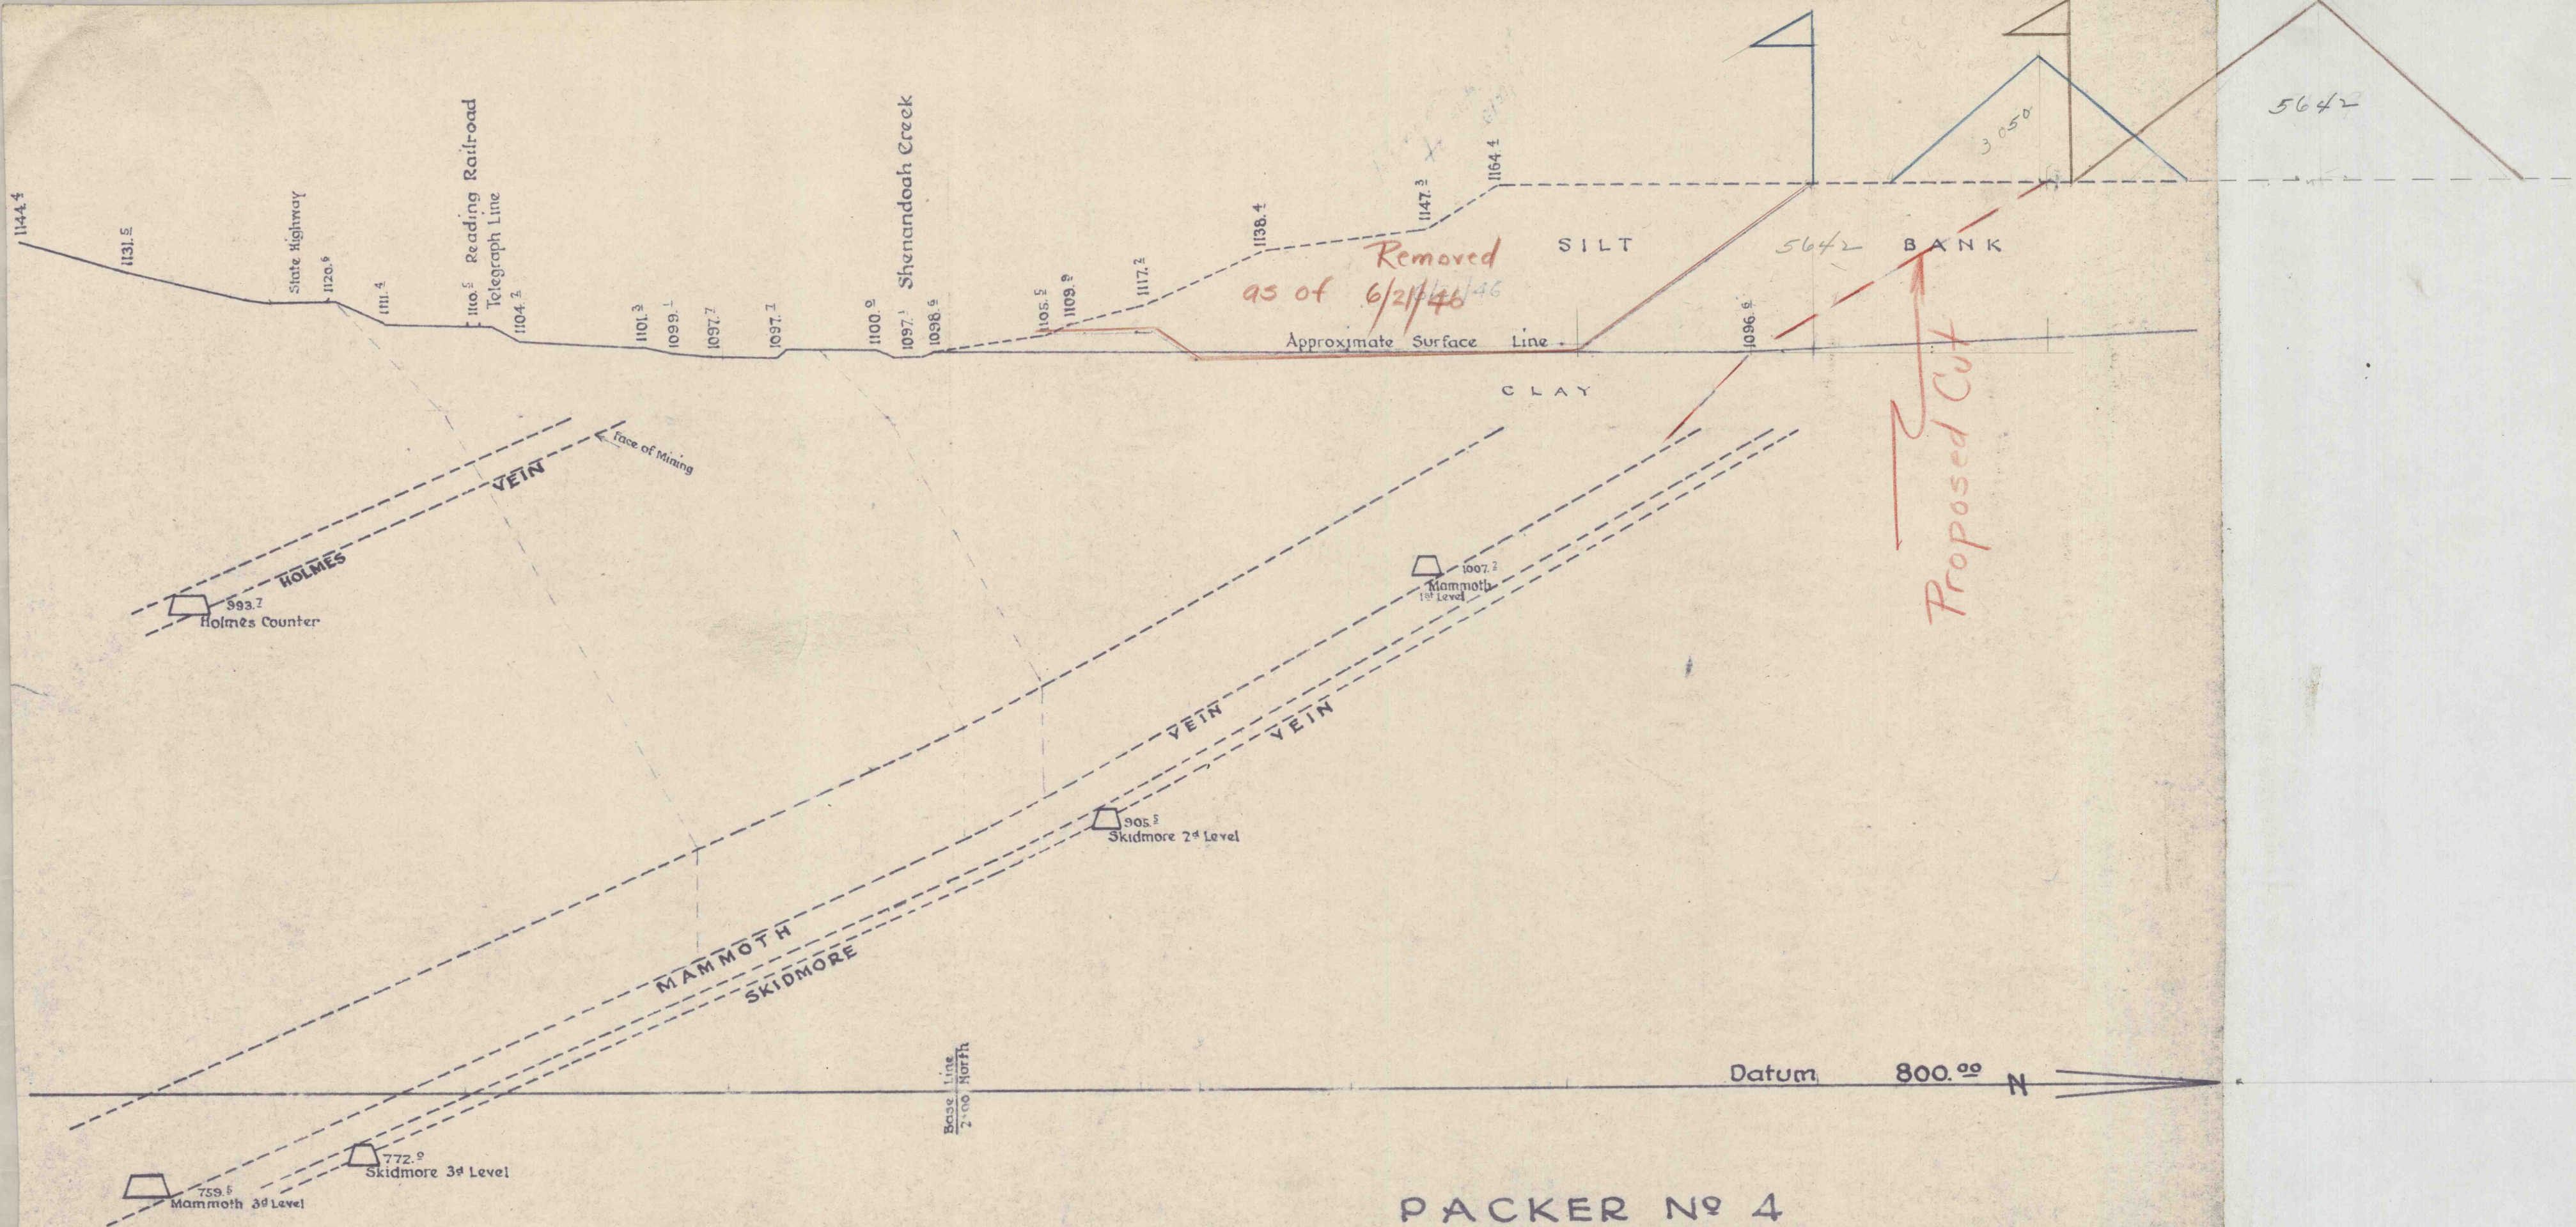

PACKER No 4
SECTION 3500 FEET EAST OF MAMMOTH GUNBOAT SLOPE
SCALE 50'-1"
OCT. 1944.
ENG. DEPT. L.C.CO.