


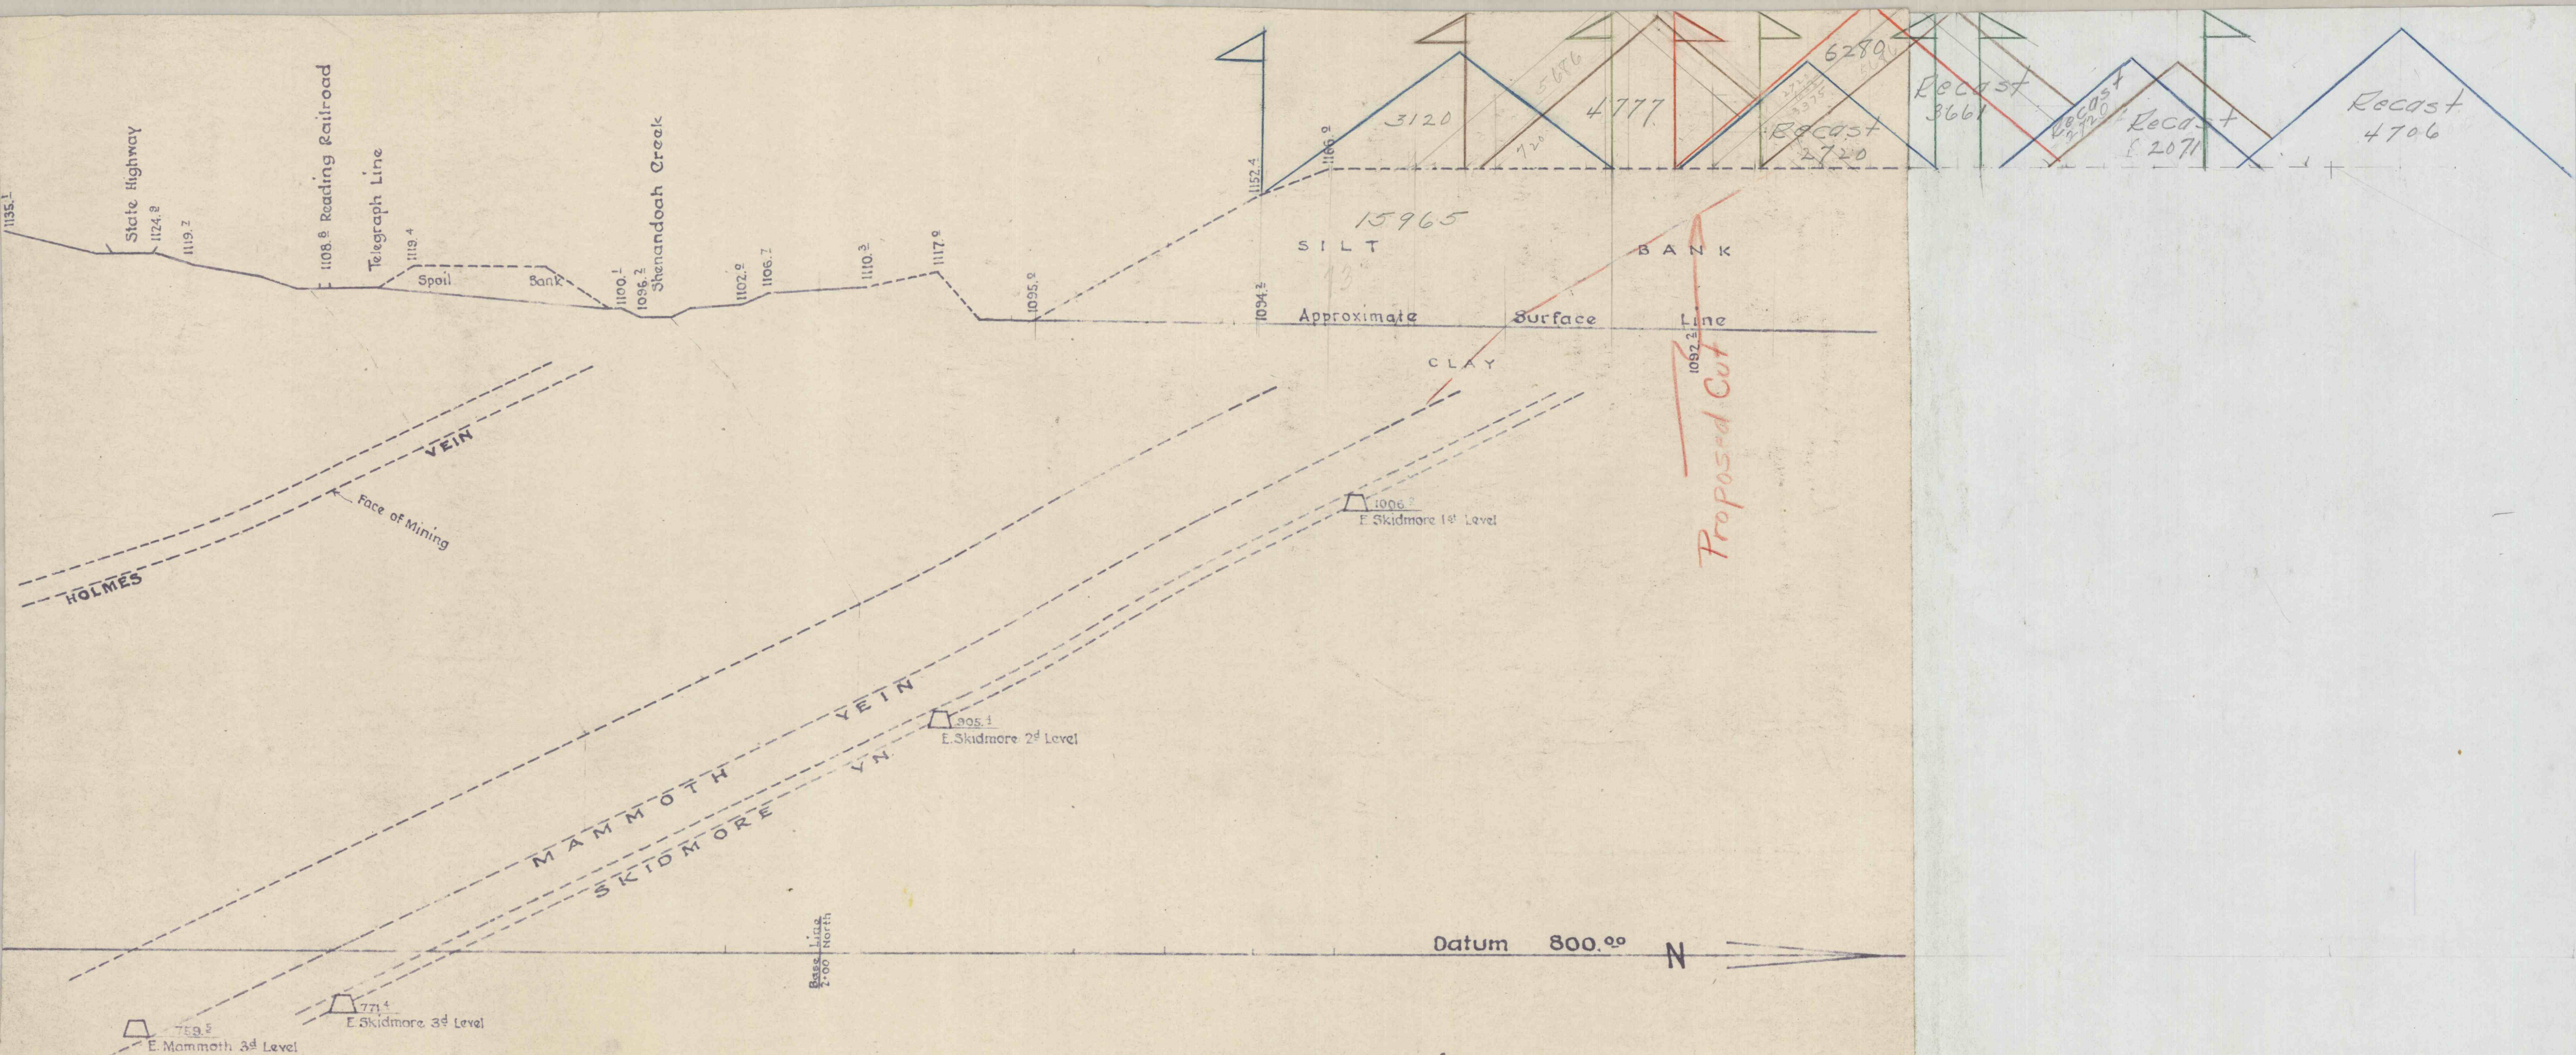

PACKER No 4
SECTION 3300 FEET EAST OF MAMMOTH GUNBOAT SLOPE
Scale 50' = 1" OCT. 1944 ENG. DEPT. L.C.CO.