


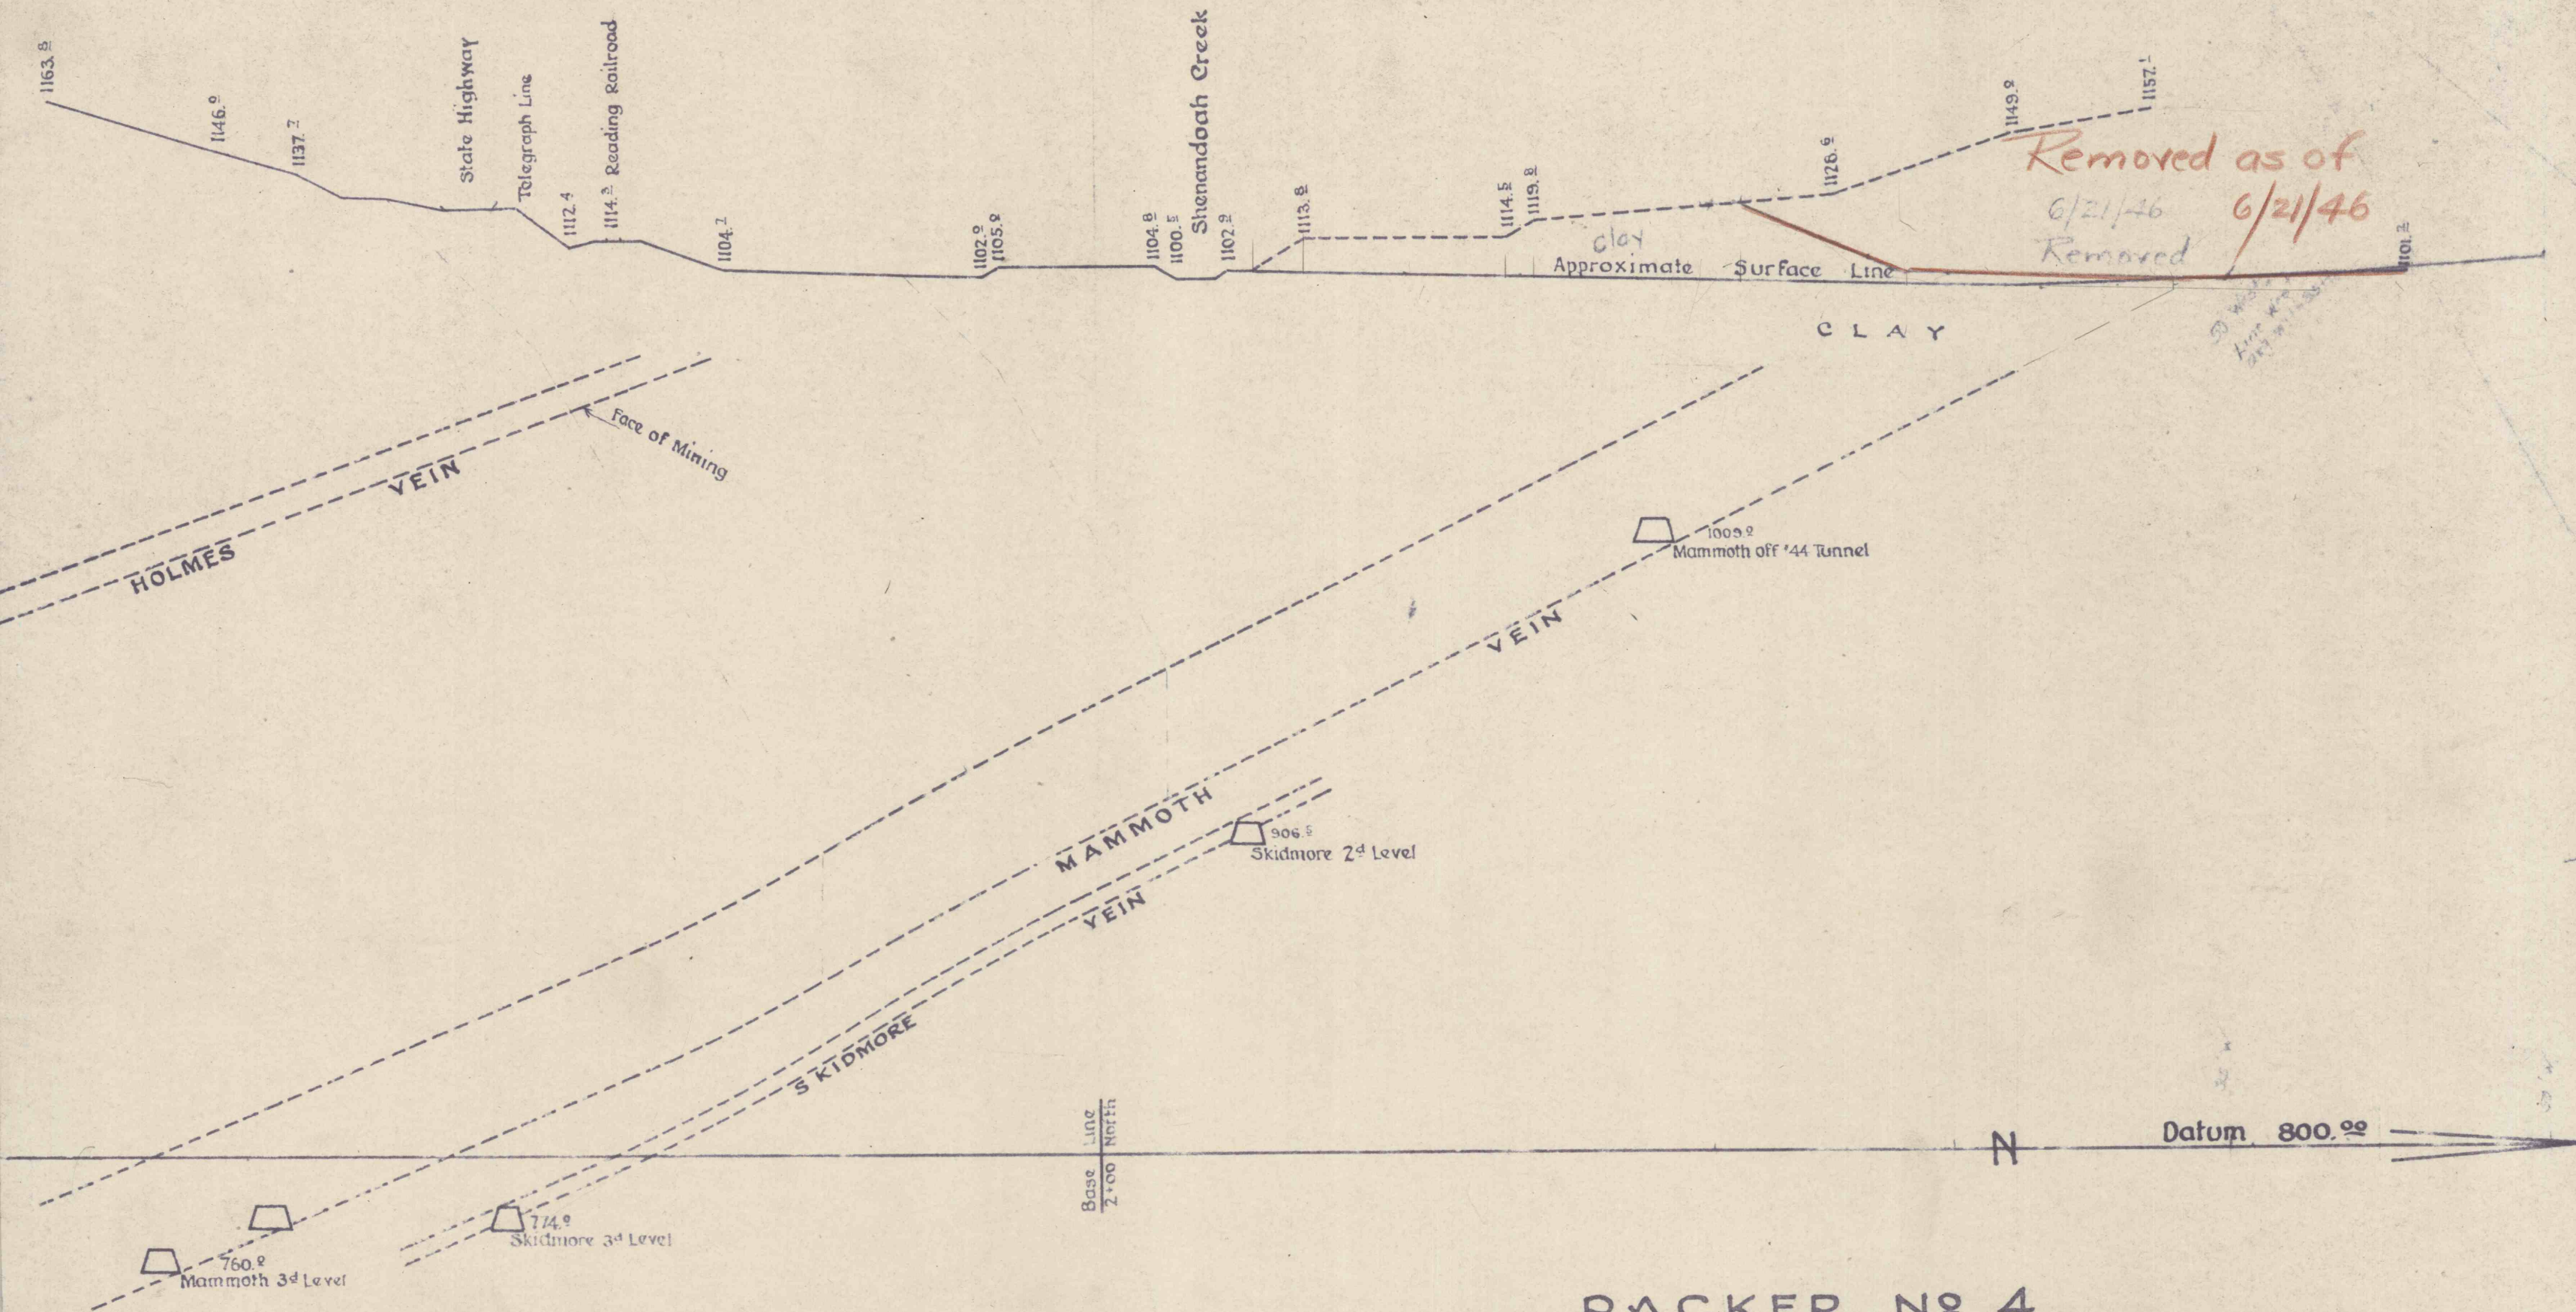

PACKER NO 4
SECTION 3700 FEET EAST OF MAMMOTH GUNBOAT SLOPE
SCALE 50' - 1" **OCT. 1944** **ENG. DEPT. L.C.CO.**