


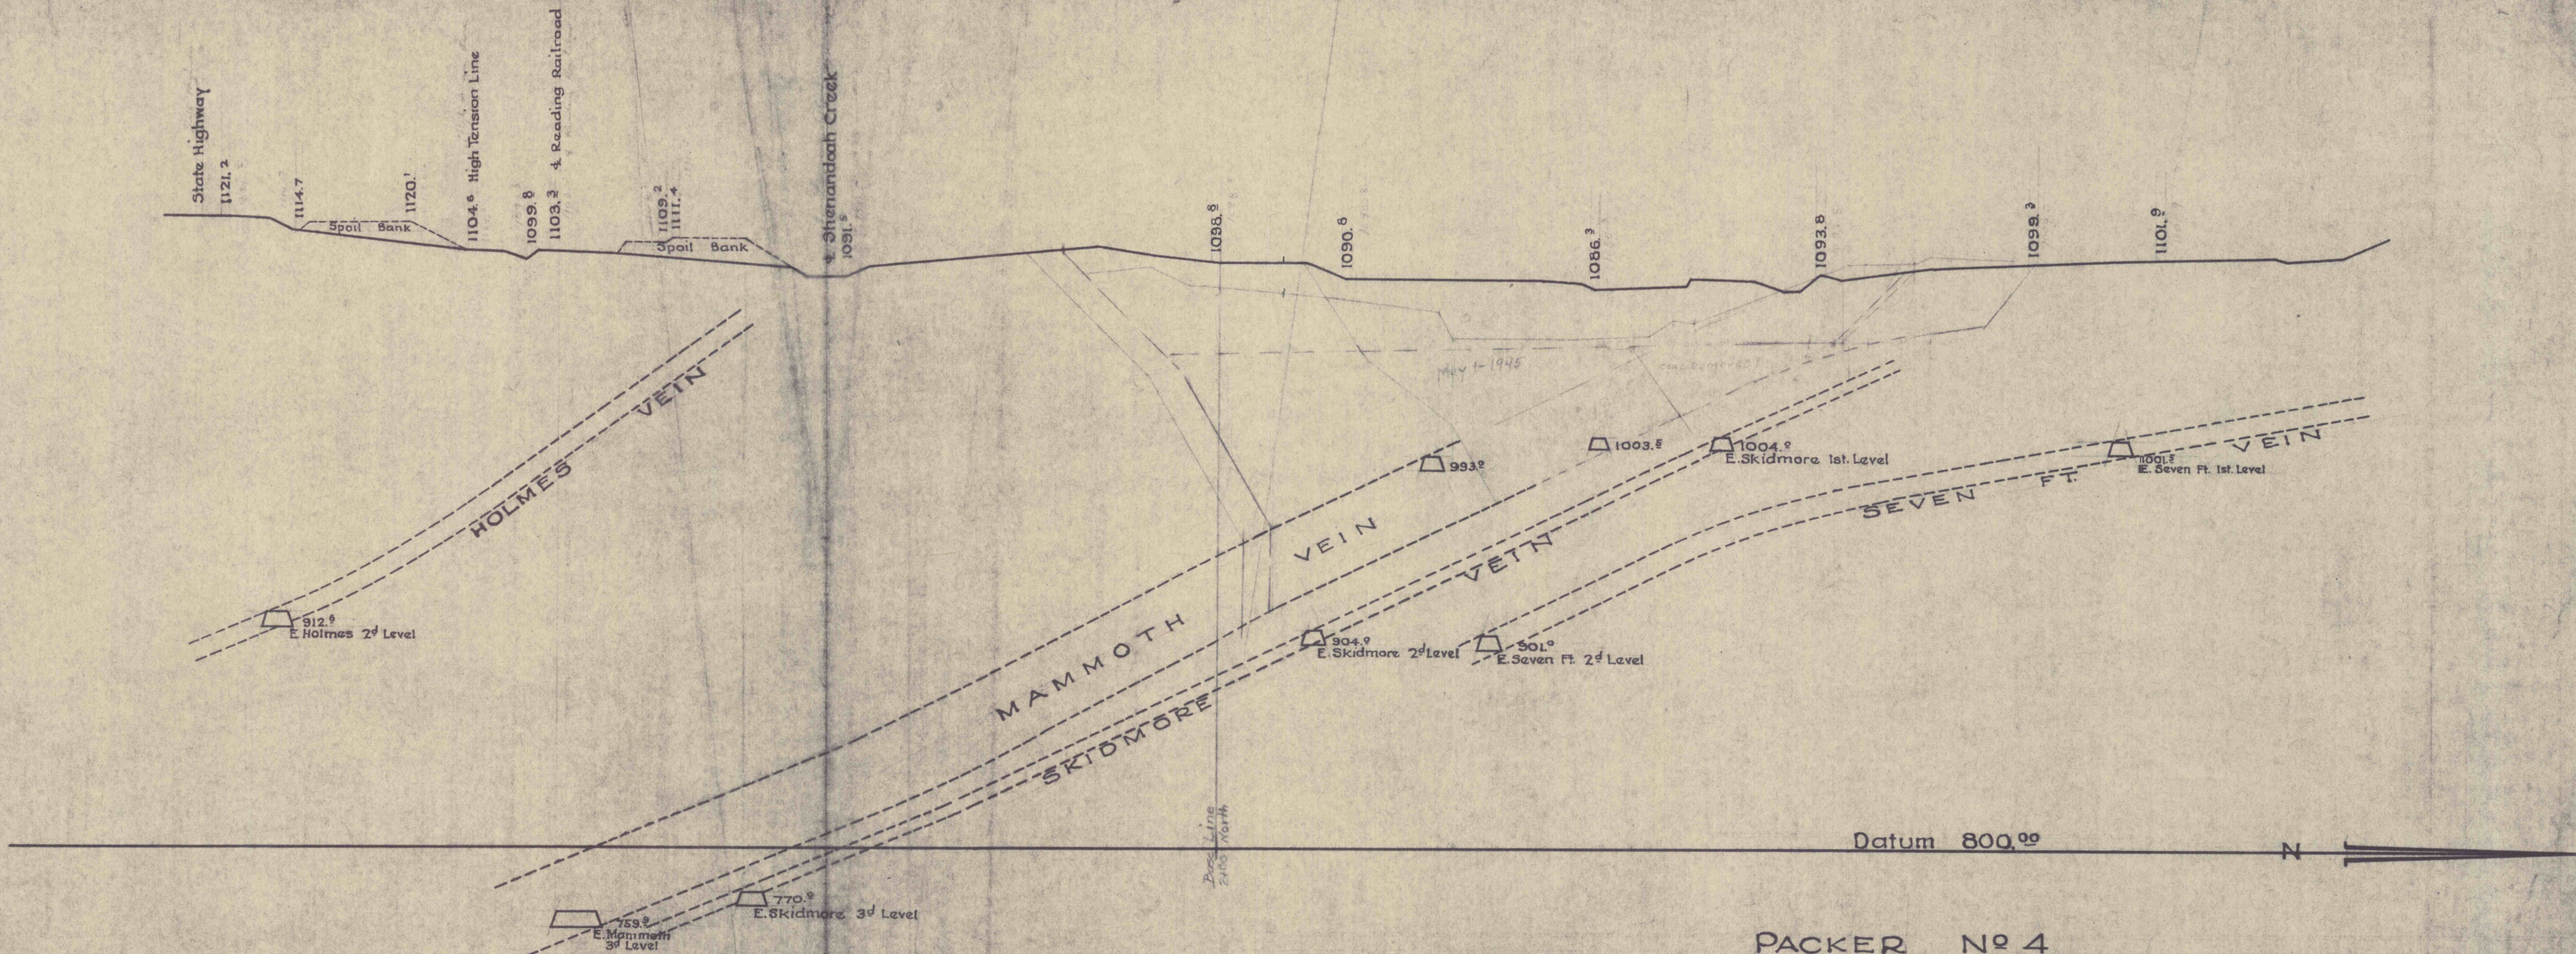

PACKER No 4
 Section 2900 Feet East of Mammoth Gunboat Slope
 Scale 50' = 1" Oct 1944 Eng. Dept. L.C. Co.