


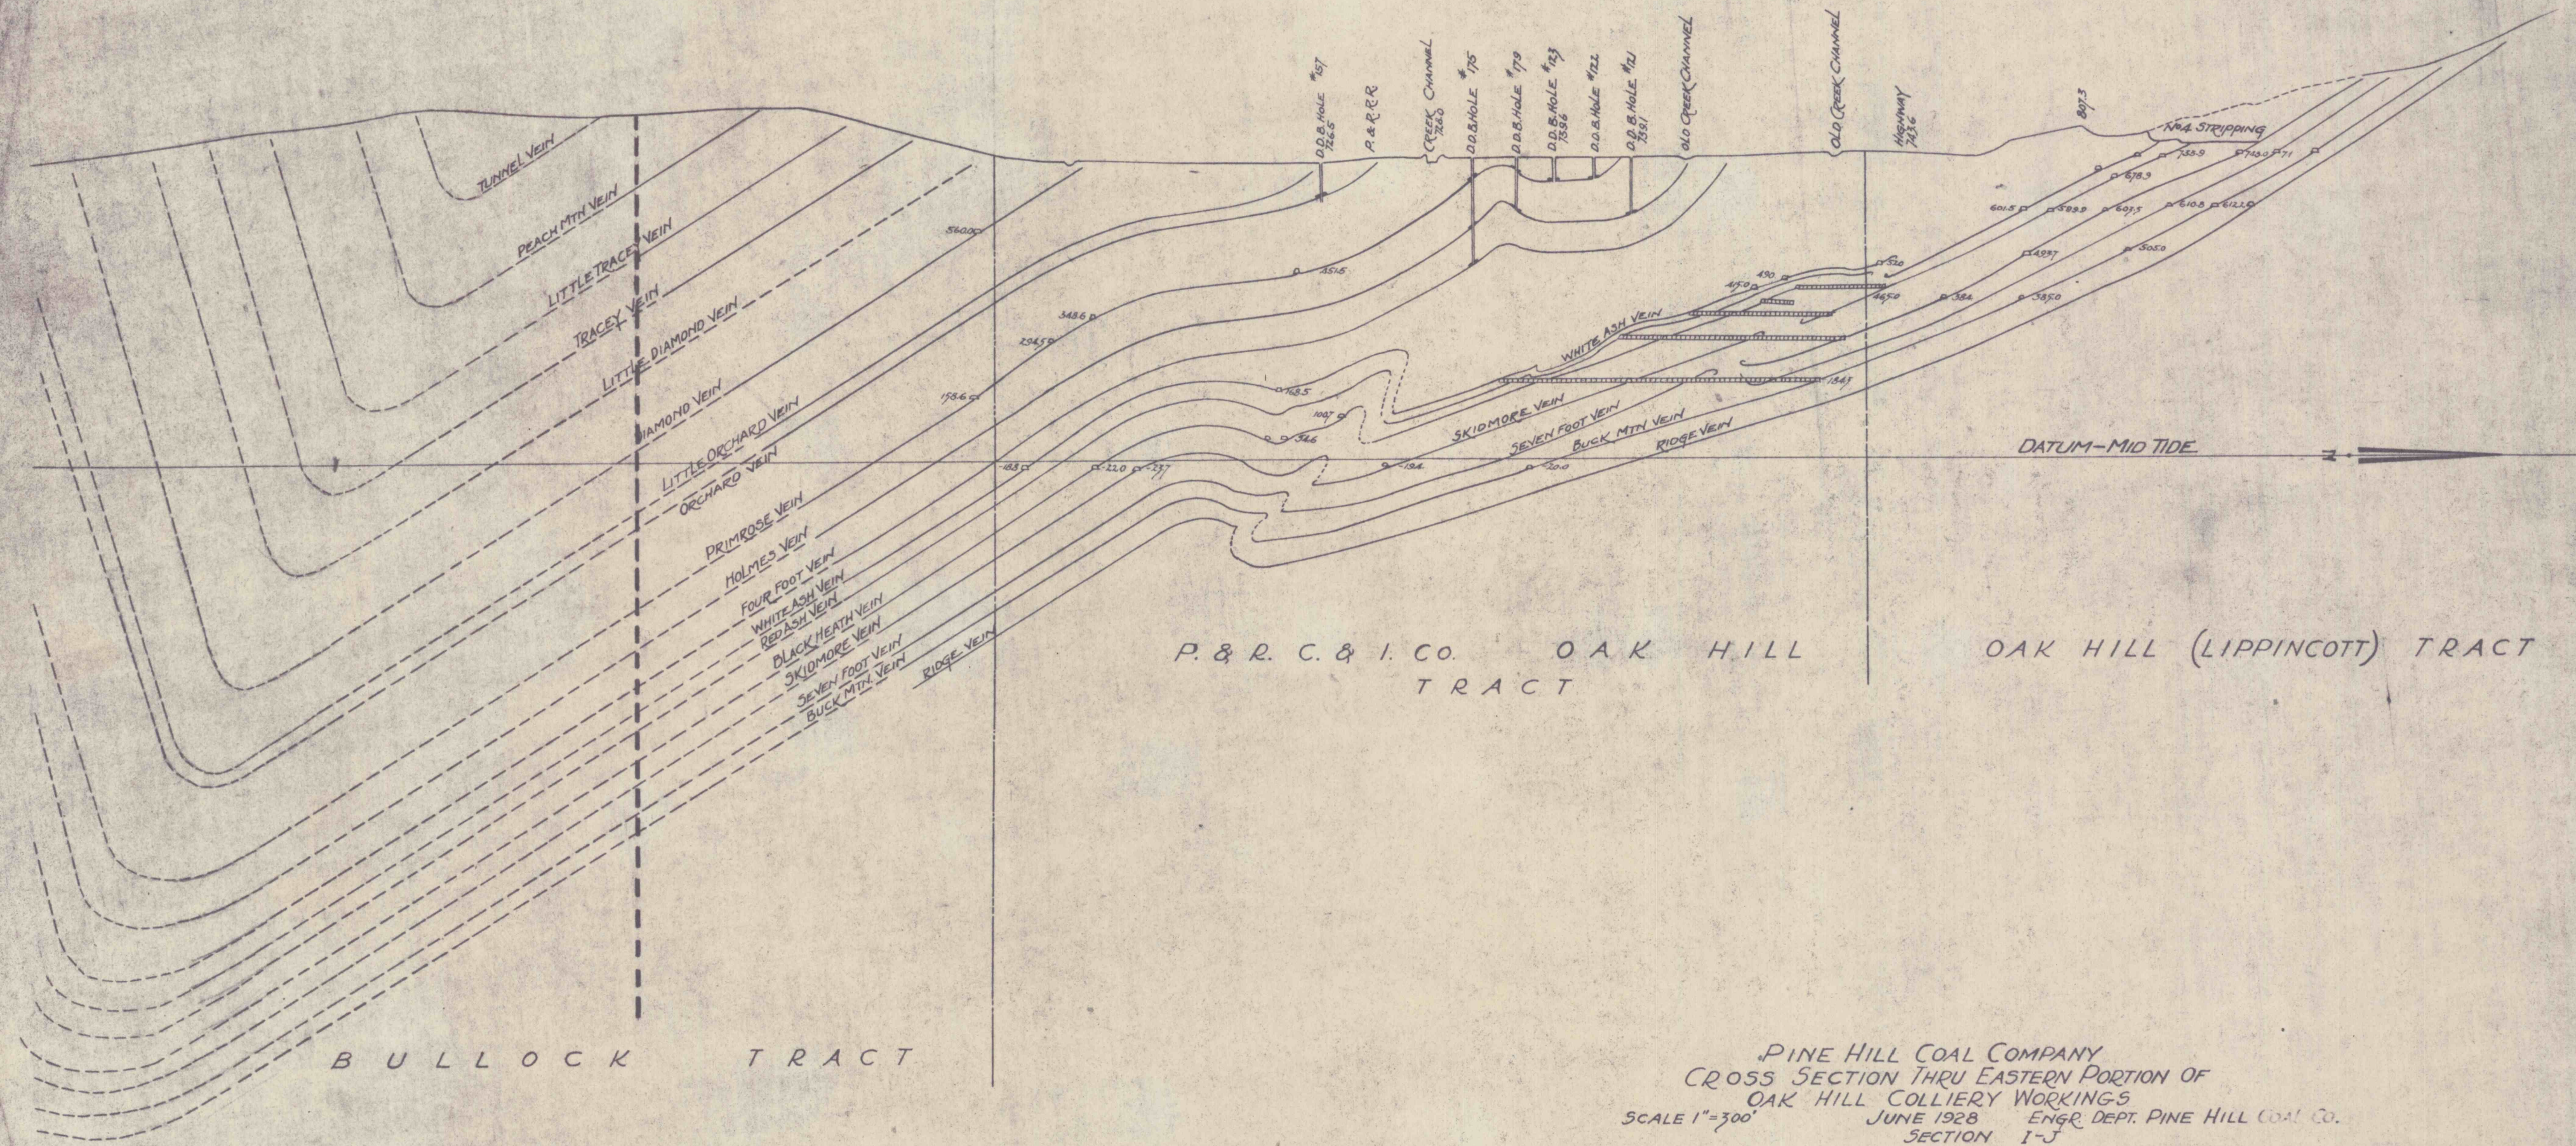

PINE HILL COAL COMPANY  
CROSS SECTION THRU EASTERN PORTION OF  
OAK HILL COLLIERY WORKINGS  
SCALE 1"=300'  
JUNE 1928 ENGR. DEPT. PINE HILL COAL CO.  
SECTION I-J