


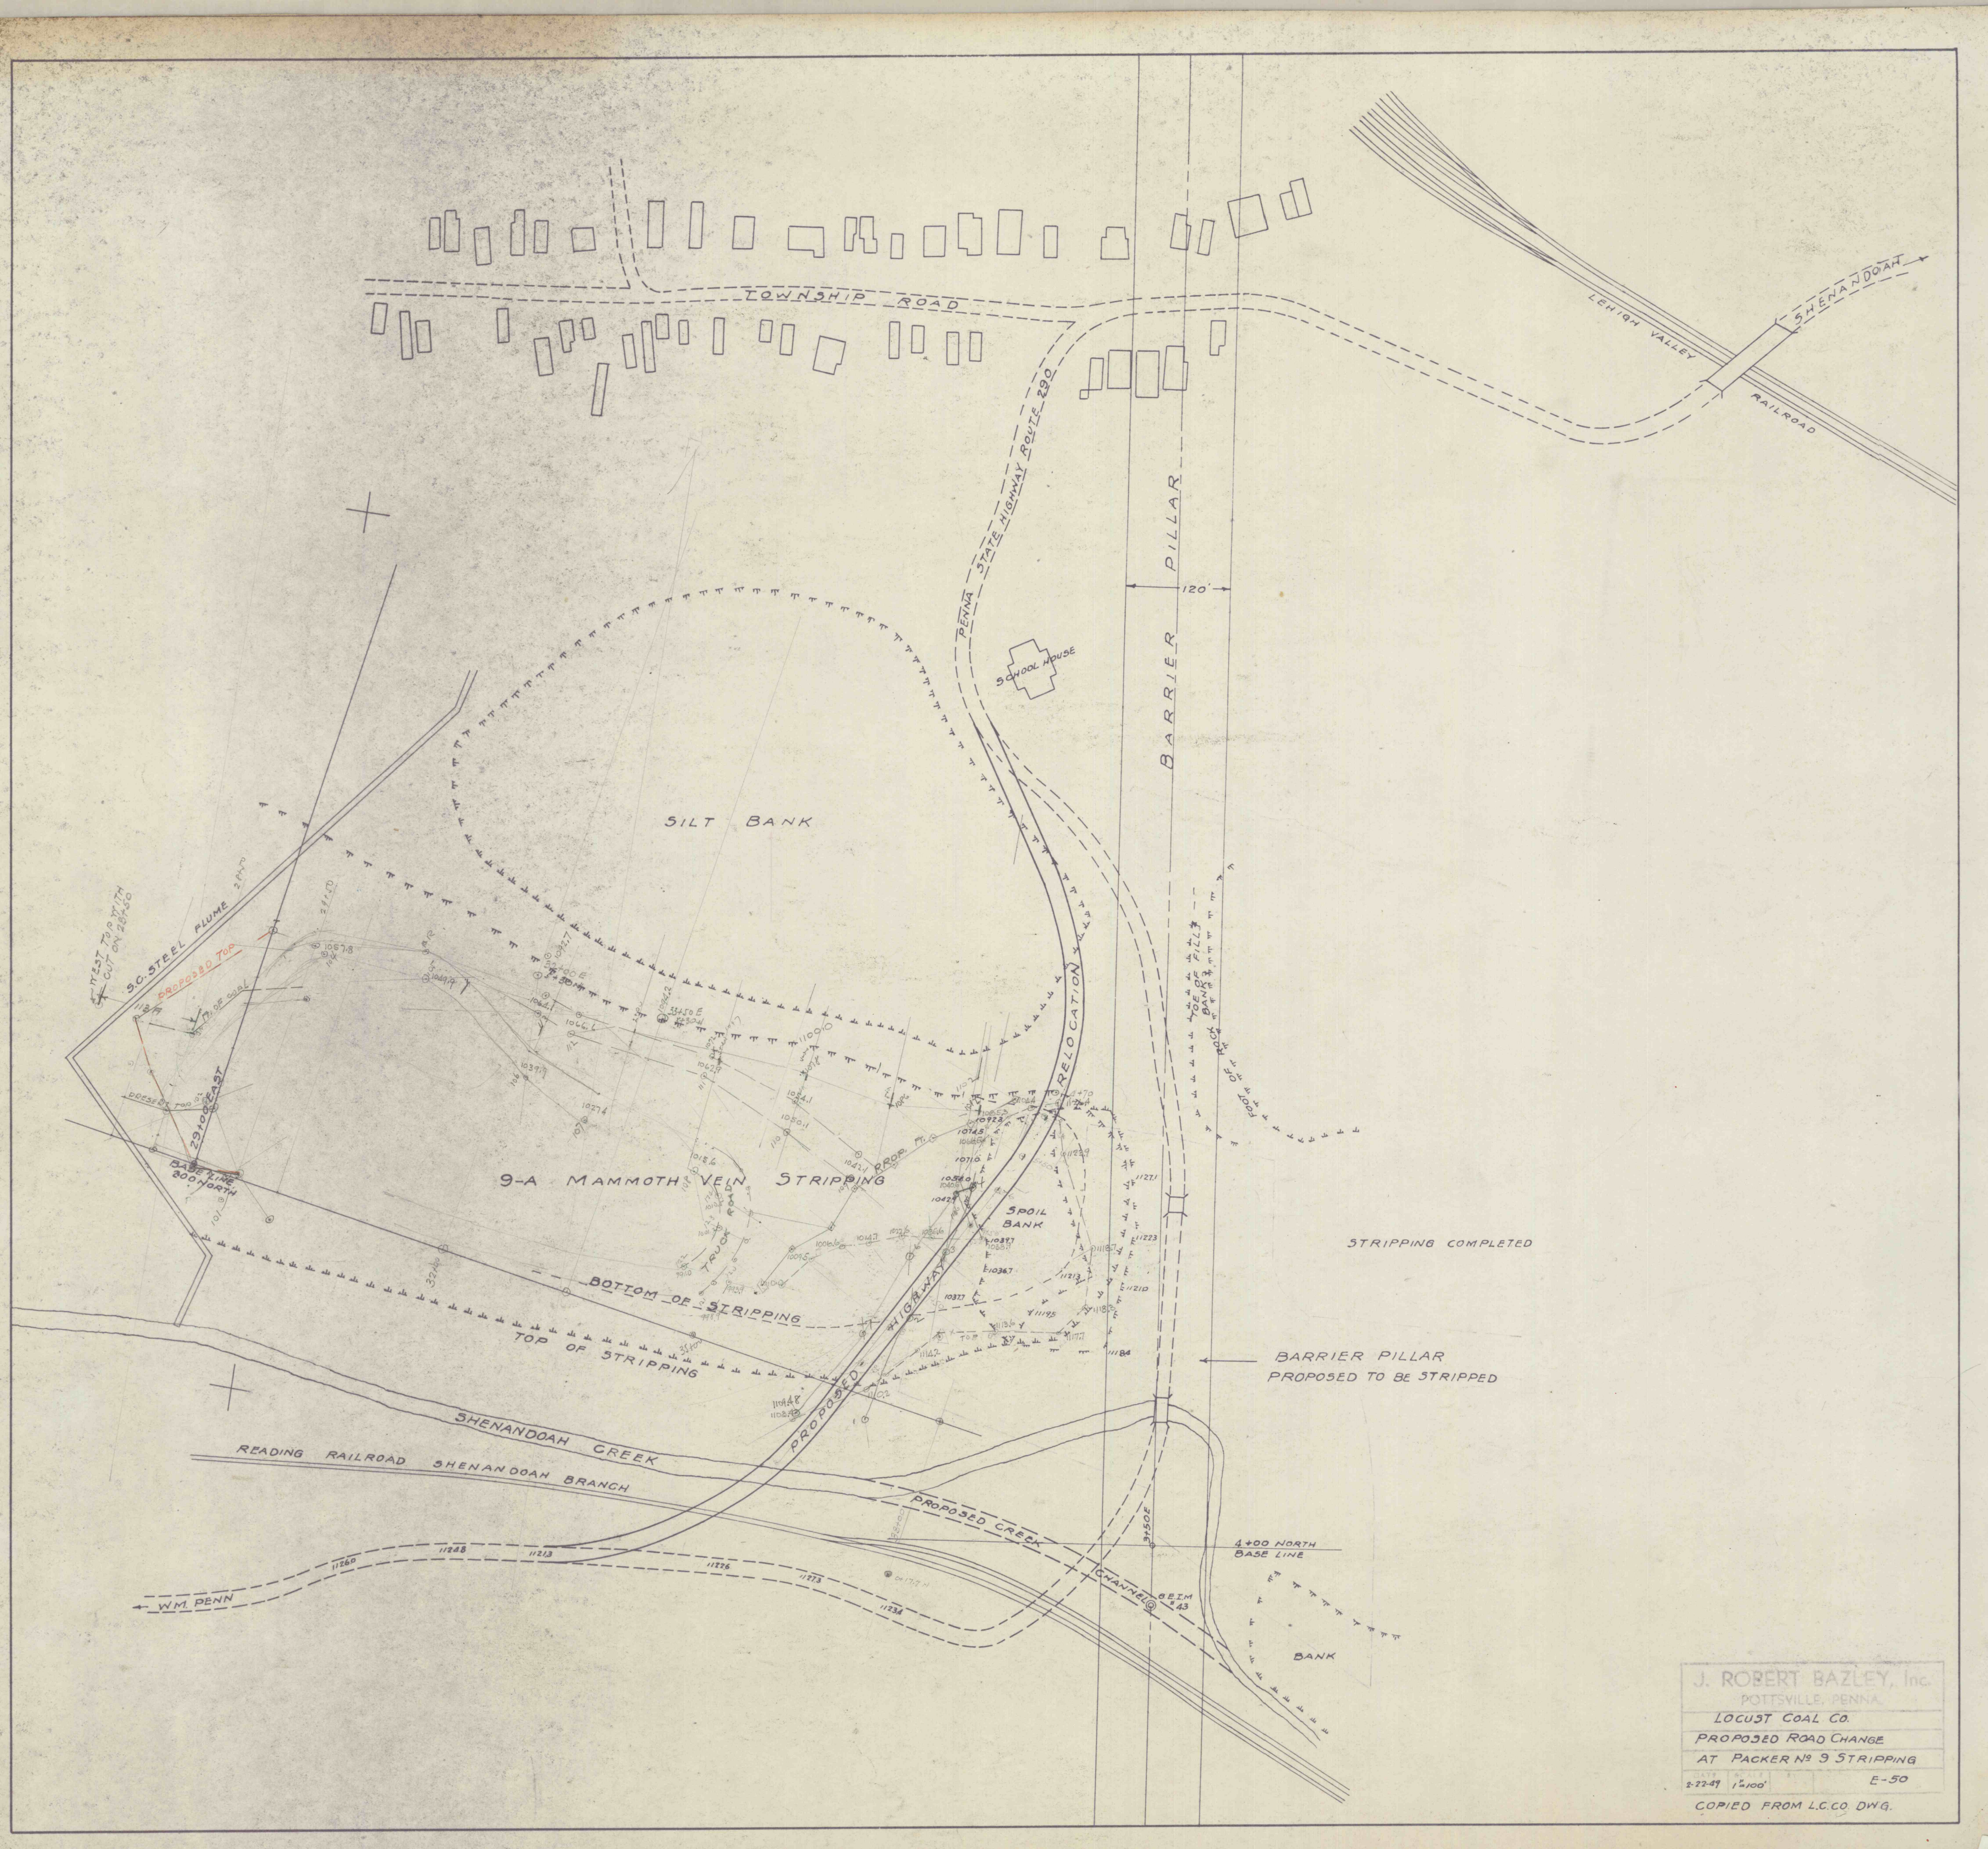

J. ROBERT BAZLEY, Inc.
 POTTSVILLE, PENNA.
 LOCUST COAL CO.
 PROPOSED ROAD CHANGE
 AT PACKER NO 9 STRIPPING
 2-22-49 1"=100' E-50
 COPIED FROM L.C.CO. DWG.