


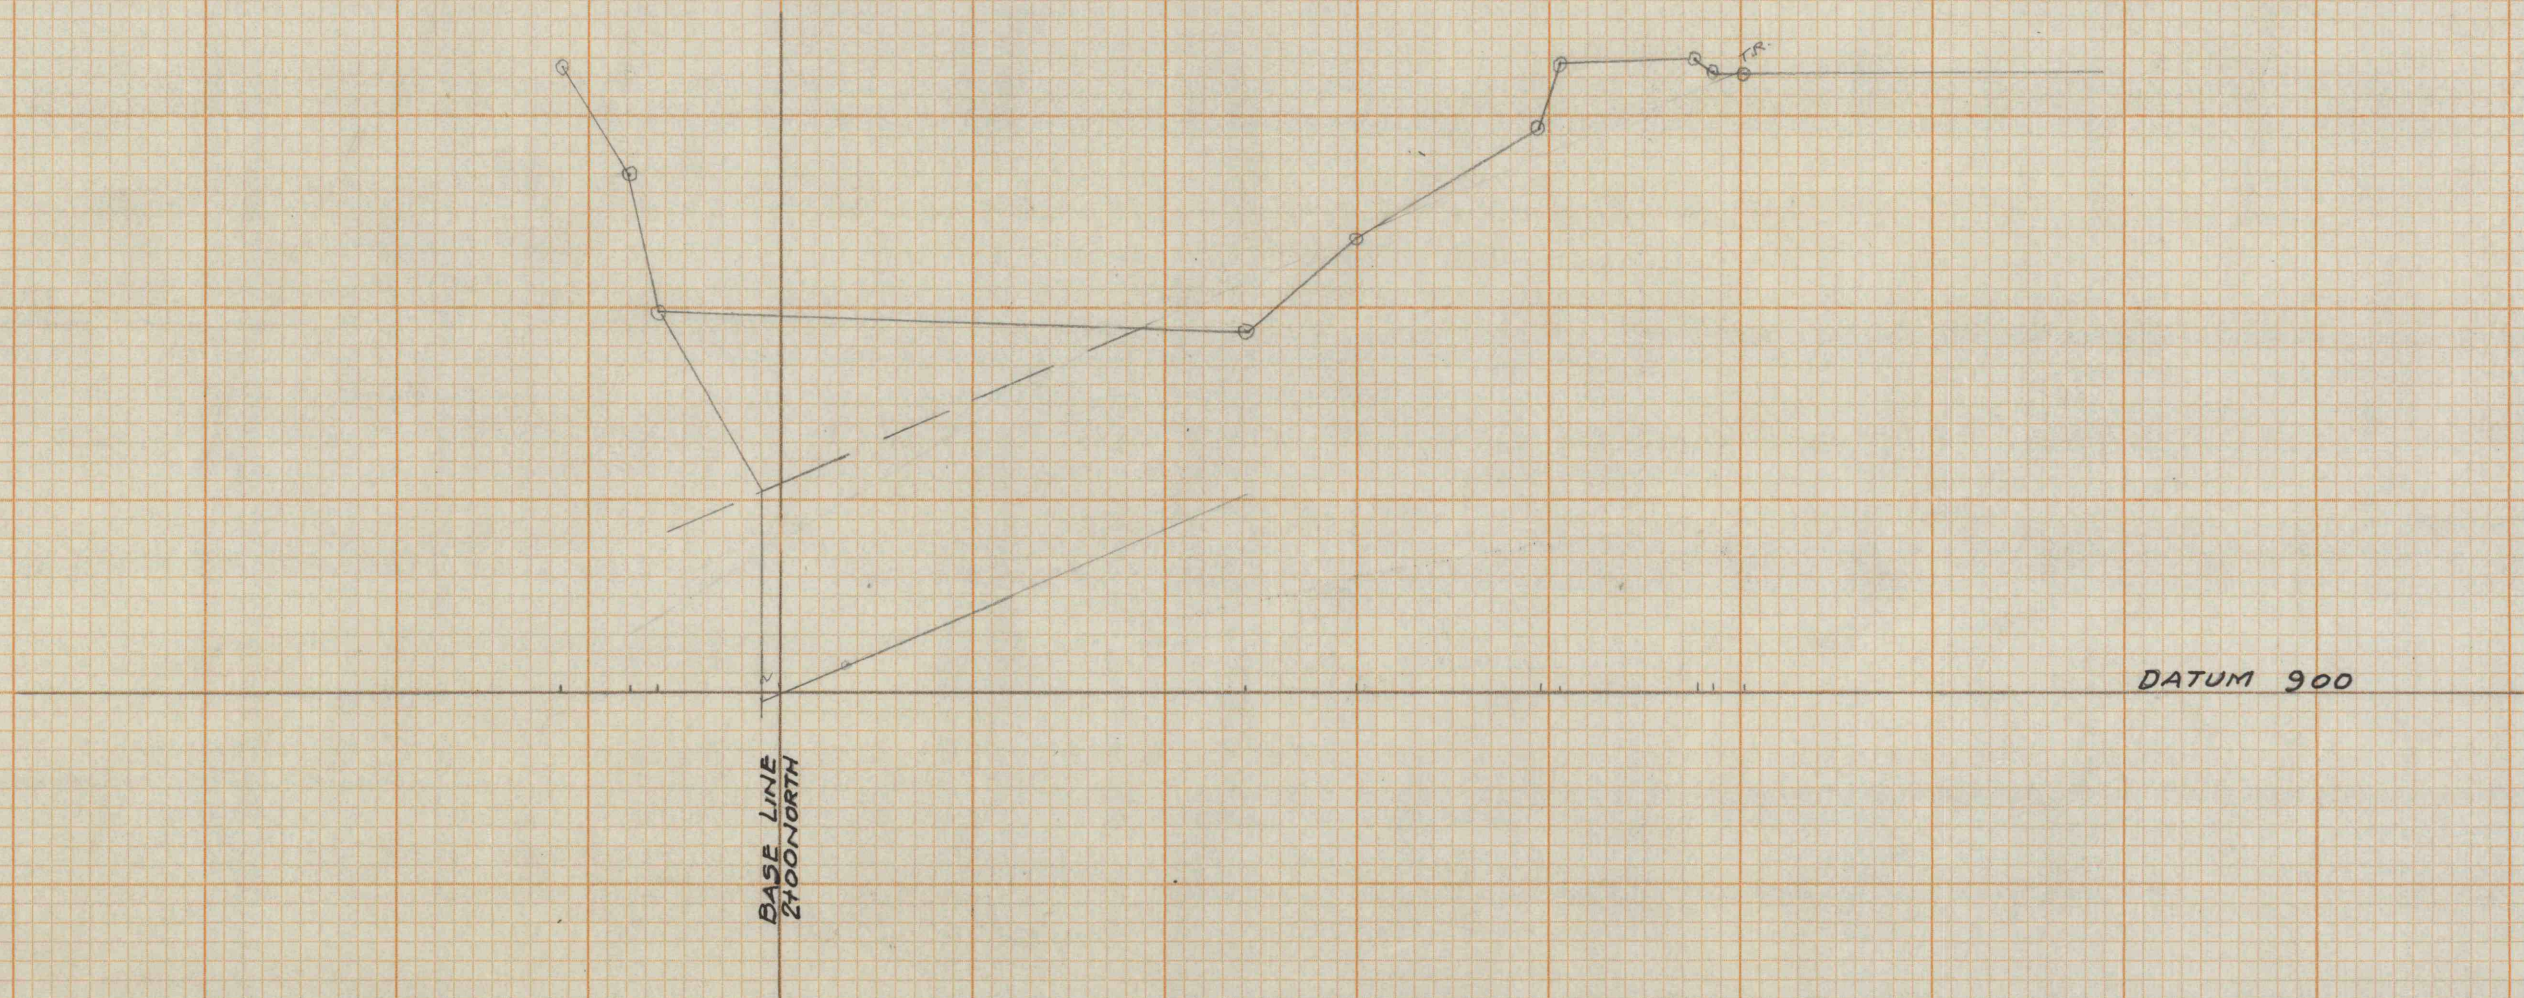

SECTION 31+50
1" = 50'

PACKER 9A STRIPPING AS OF JAN. 31, 1949