


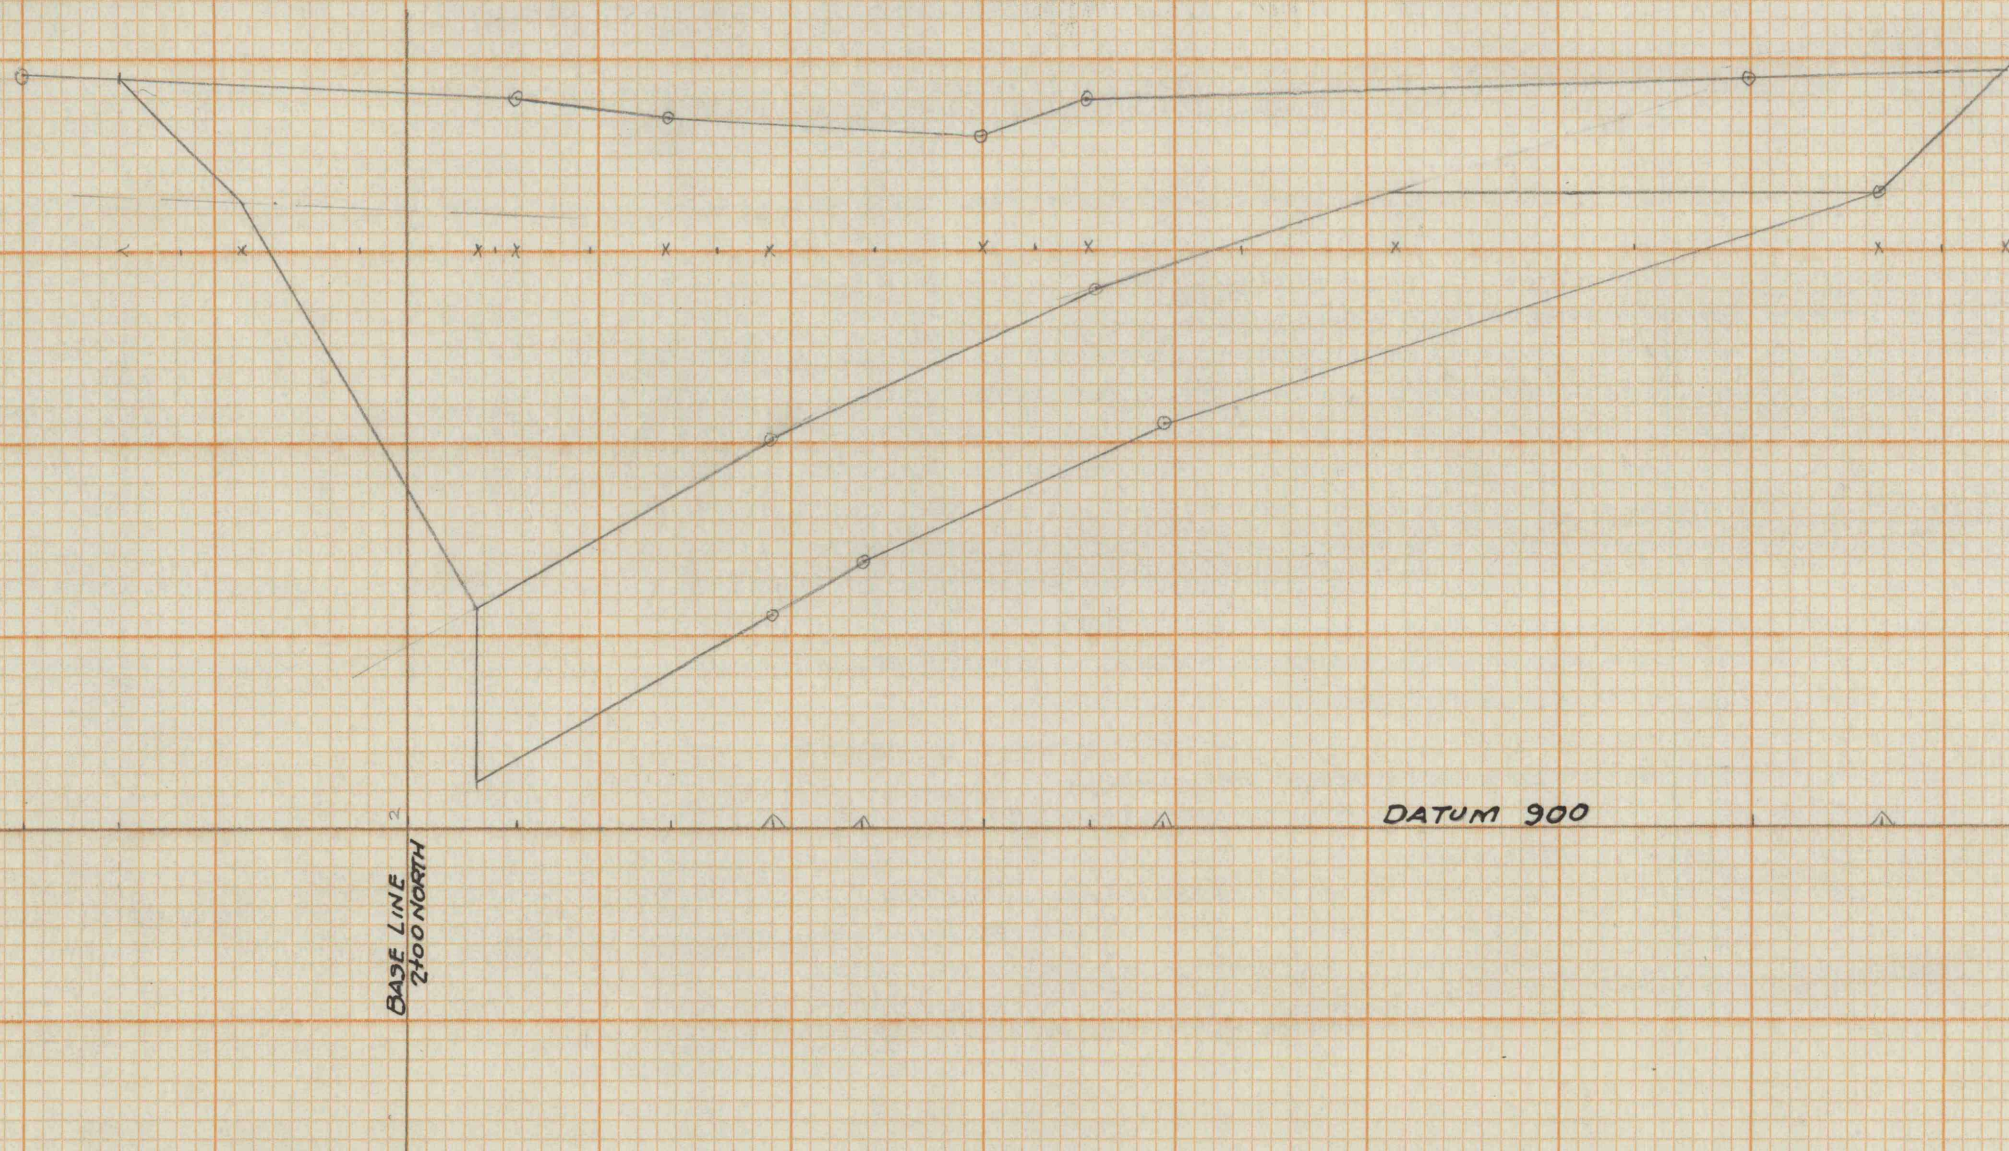

SEC. 30+00

PACKER 9A STRIPPING AS OF JAN. 31, 1949

Scale 1" = 50'