


SECTION 28+50

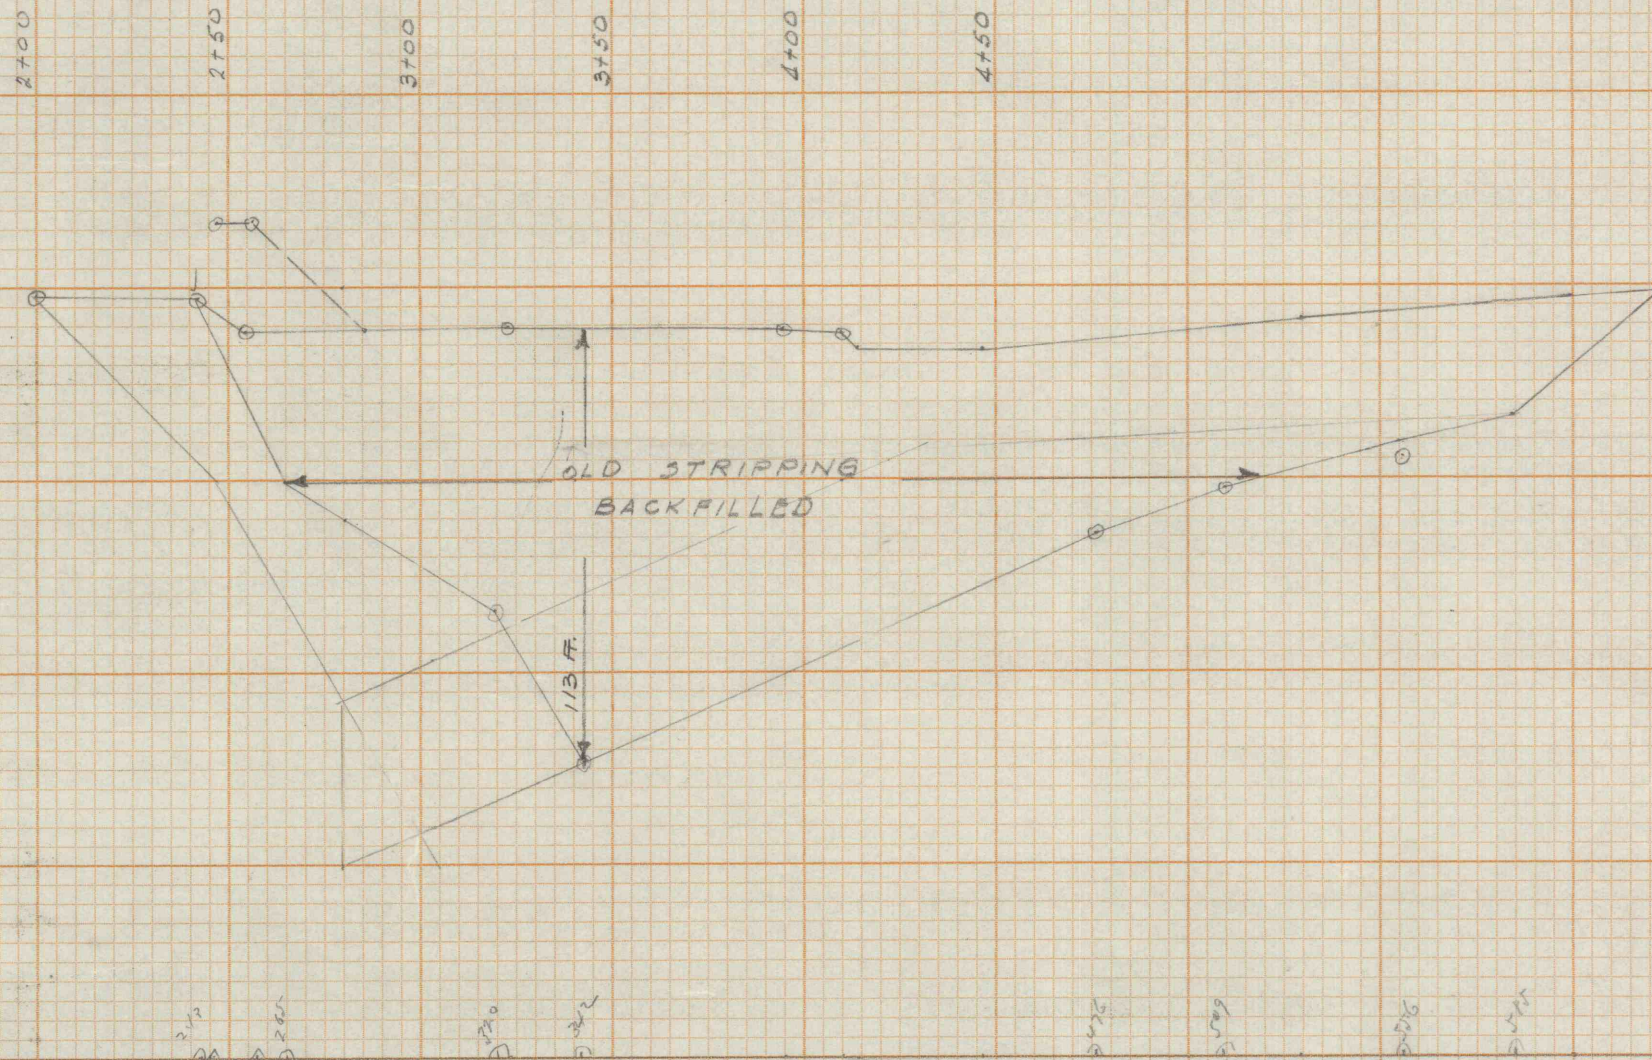

1" = 50'