PACKER

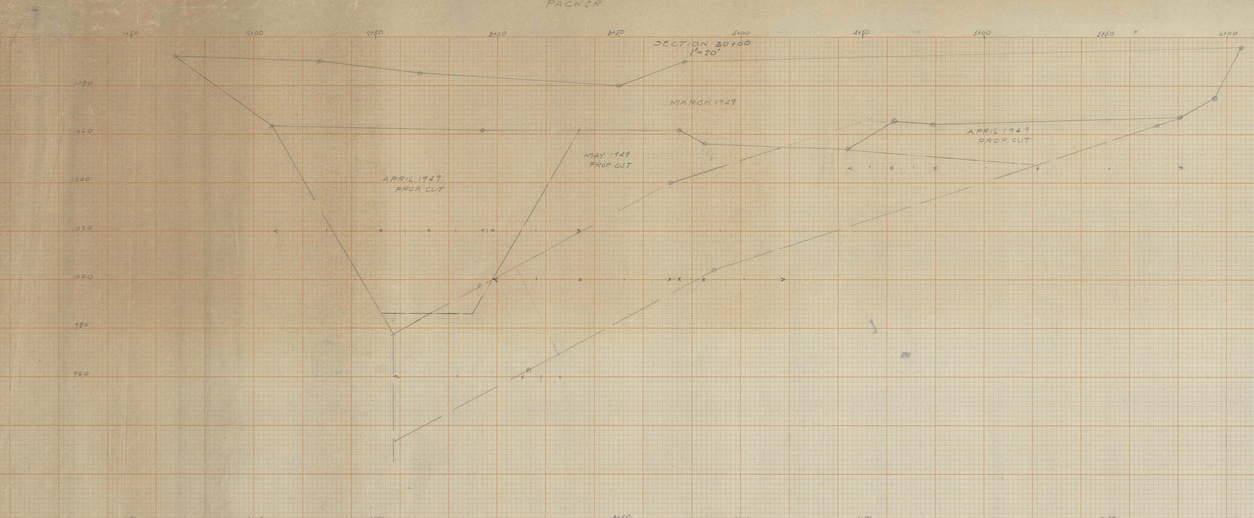
SECTION 30+00
1"=20'
MARCH 1949
APRIL 1949
PROP. CUT
MAY 1949
PROP CUT
APRIL 1949
PROP CUT

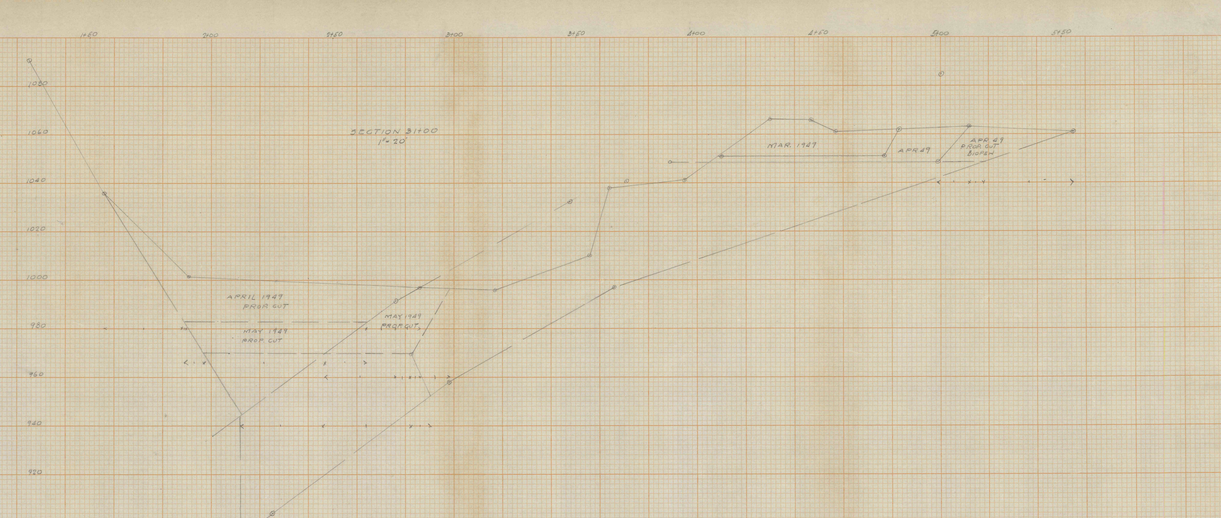
SECTION 31+00
1"=20'
MAR. 1949
APR. 49
APRIL 1949
PROP CUT
MAY 1949
PROP CUT
MAY 1949
PROP CUT
APRIL 1949
PROP CUT
AUGUST

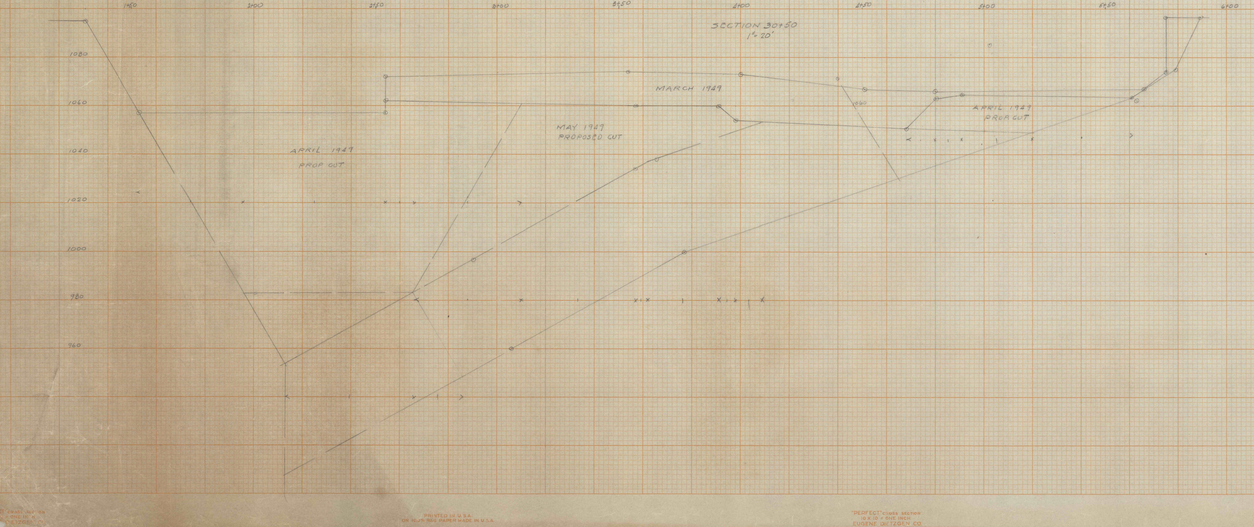
SECTION 30+50
1"=20'
MARCH 1949
APRIL 1949
PROP CUT
MAY 1949
PROPOSED CUT
APRIL 1949
PROP CUT