


13+00

N

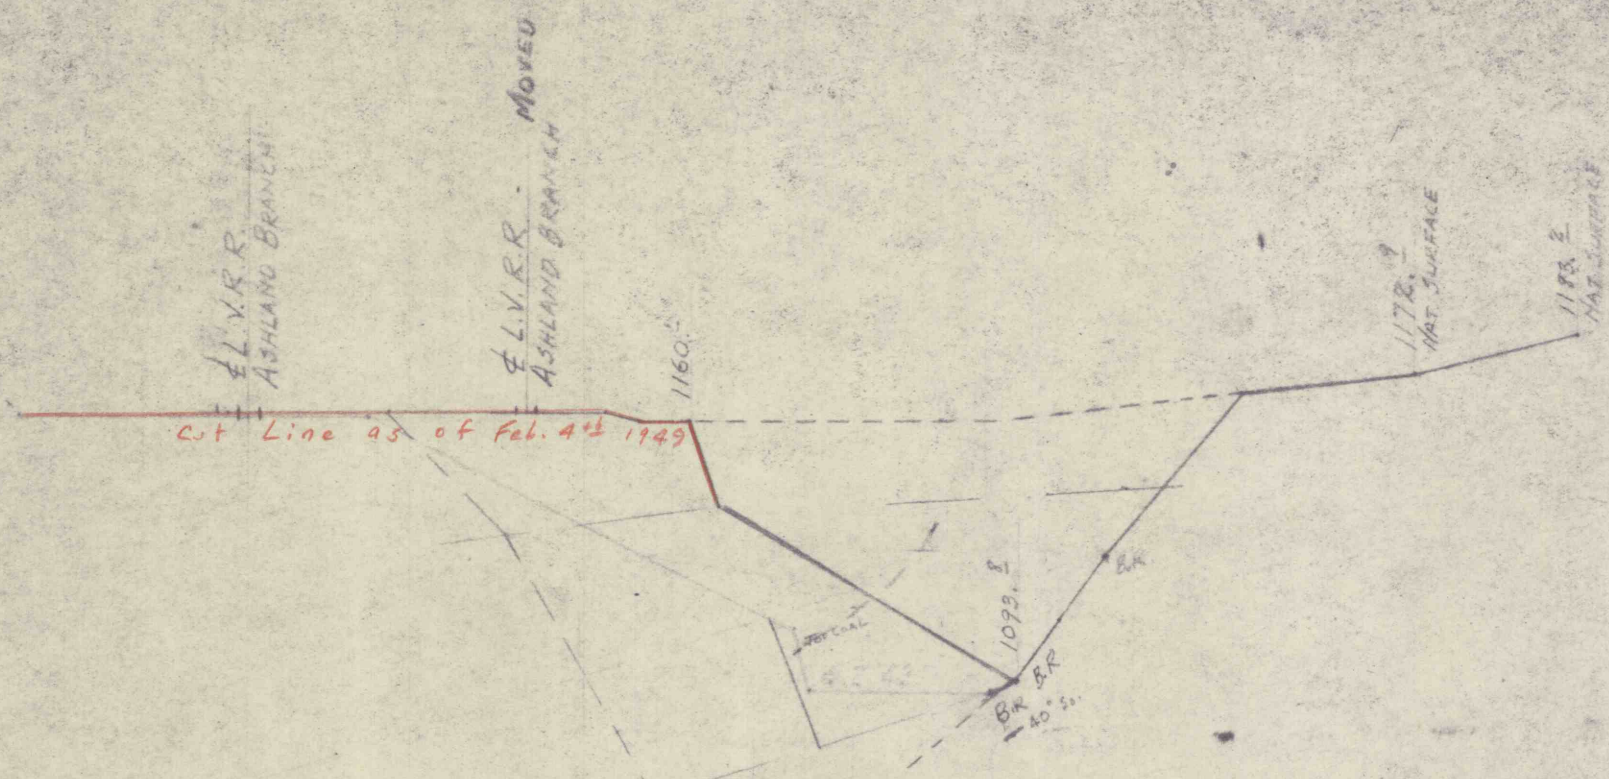

993°
MAMM 1st LEVEL

1000.00

13+00 - 1"=50' SEPT 5, 1942
1450' EAST OF PACKER 4 GUNBOAT SLOPE