


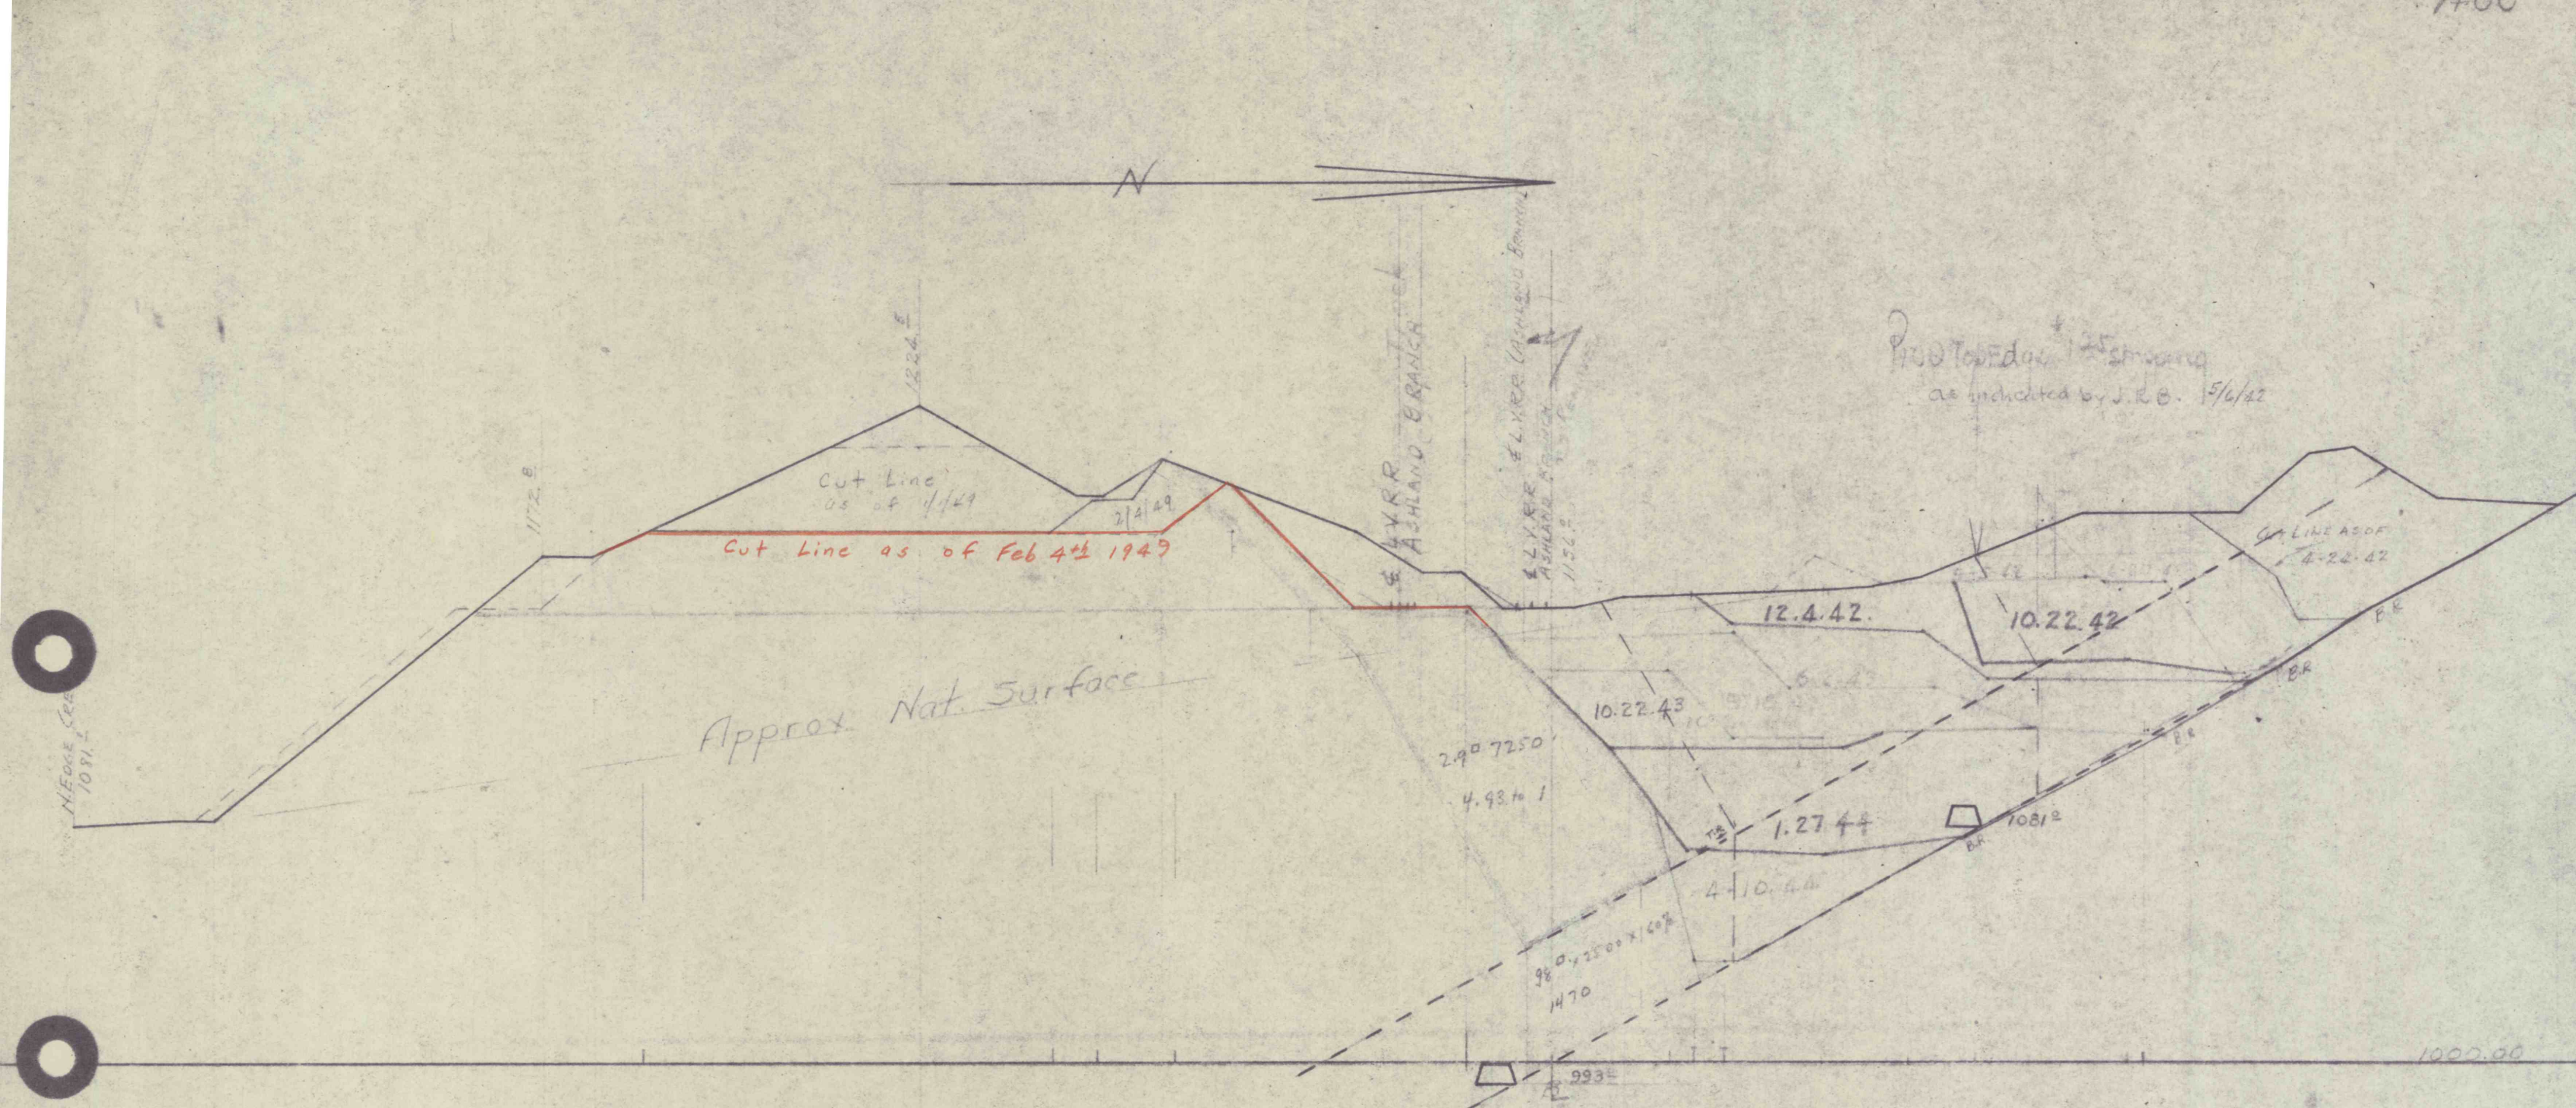

Profile as indicated by J.E.B. 5/6/42

12.4.42.

10.22.42

Approx. Nat. Surface

2.90 7250
4.93 to 1

10.22.43

1.27.44

1081.2

4.10.44

9% 0.2500 x 160%
1470

SECTION 7 + 00 EAST

850 Feet East of Packer #4 Gunboat Slope

Scale 50' = 1" - May 12, 1942 - Engr. Dept. L.C.Co.

7+00

1" = 50'