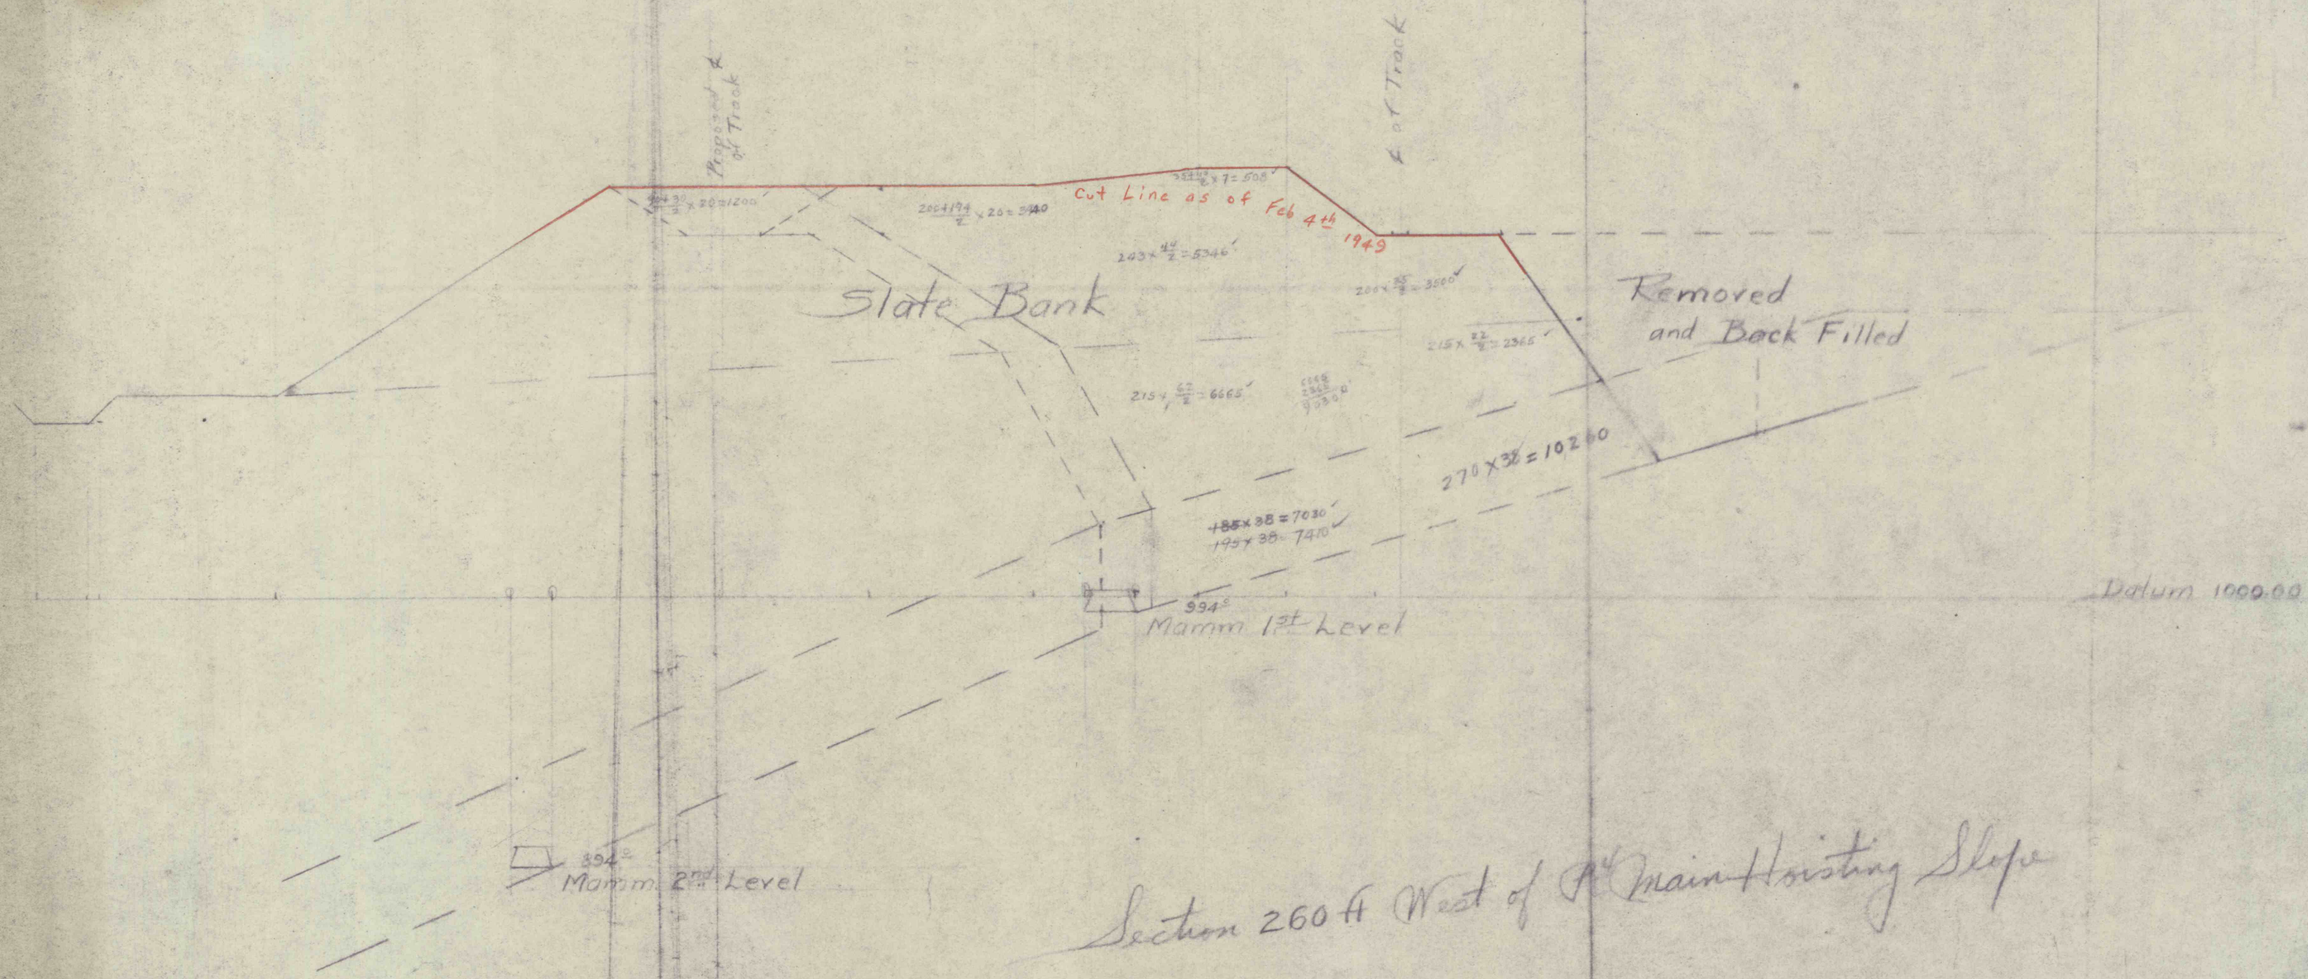

Section 260 ft West of N. Main Hoisting Slope

Scale 1" = 50'

Dec. 19th 1947

