


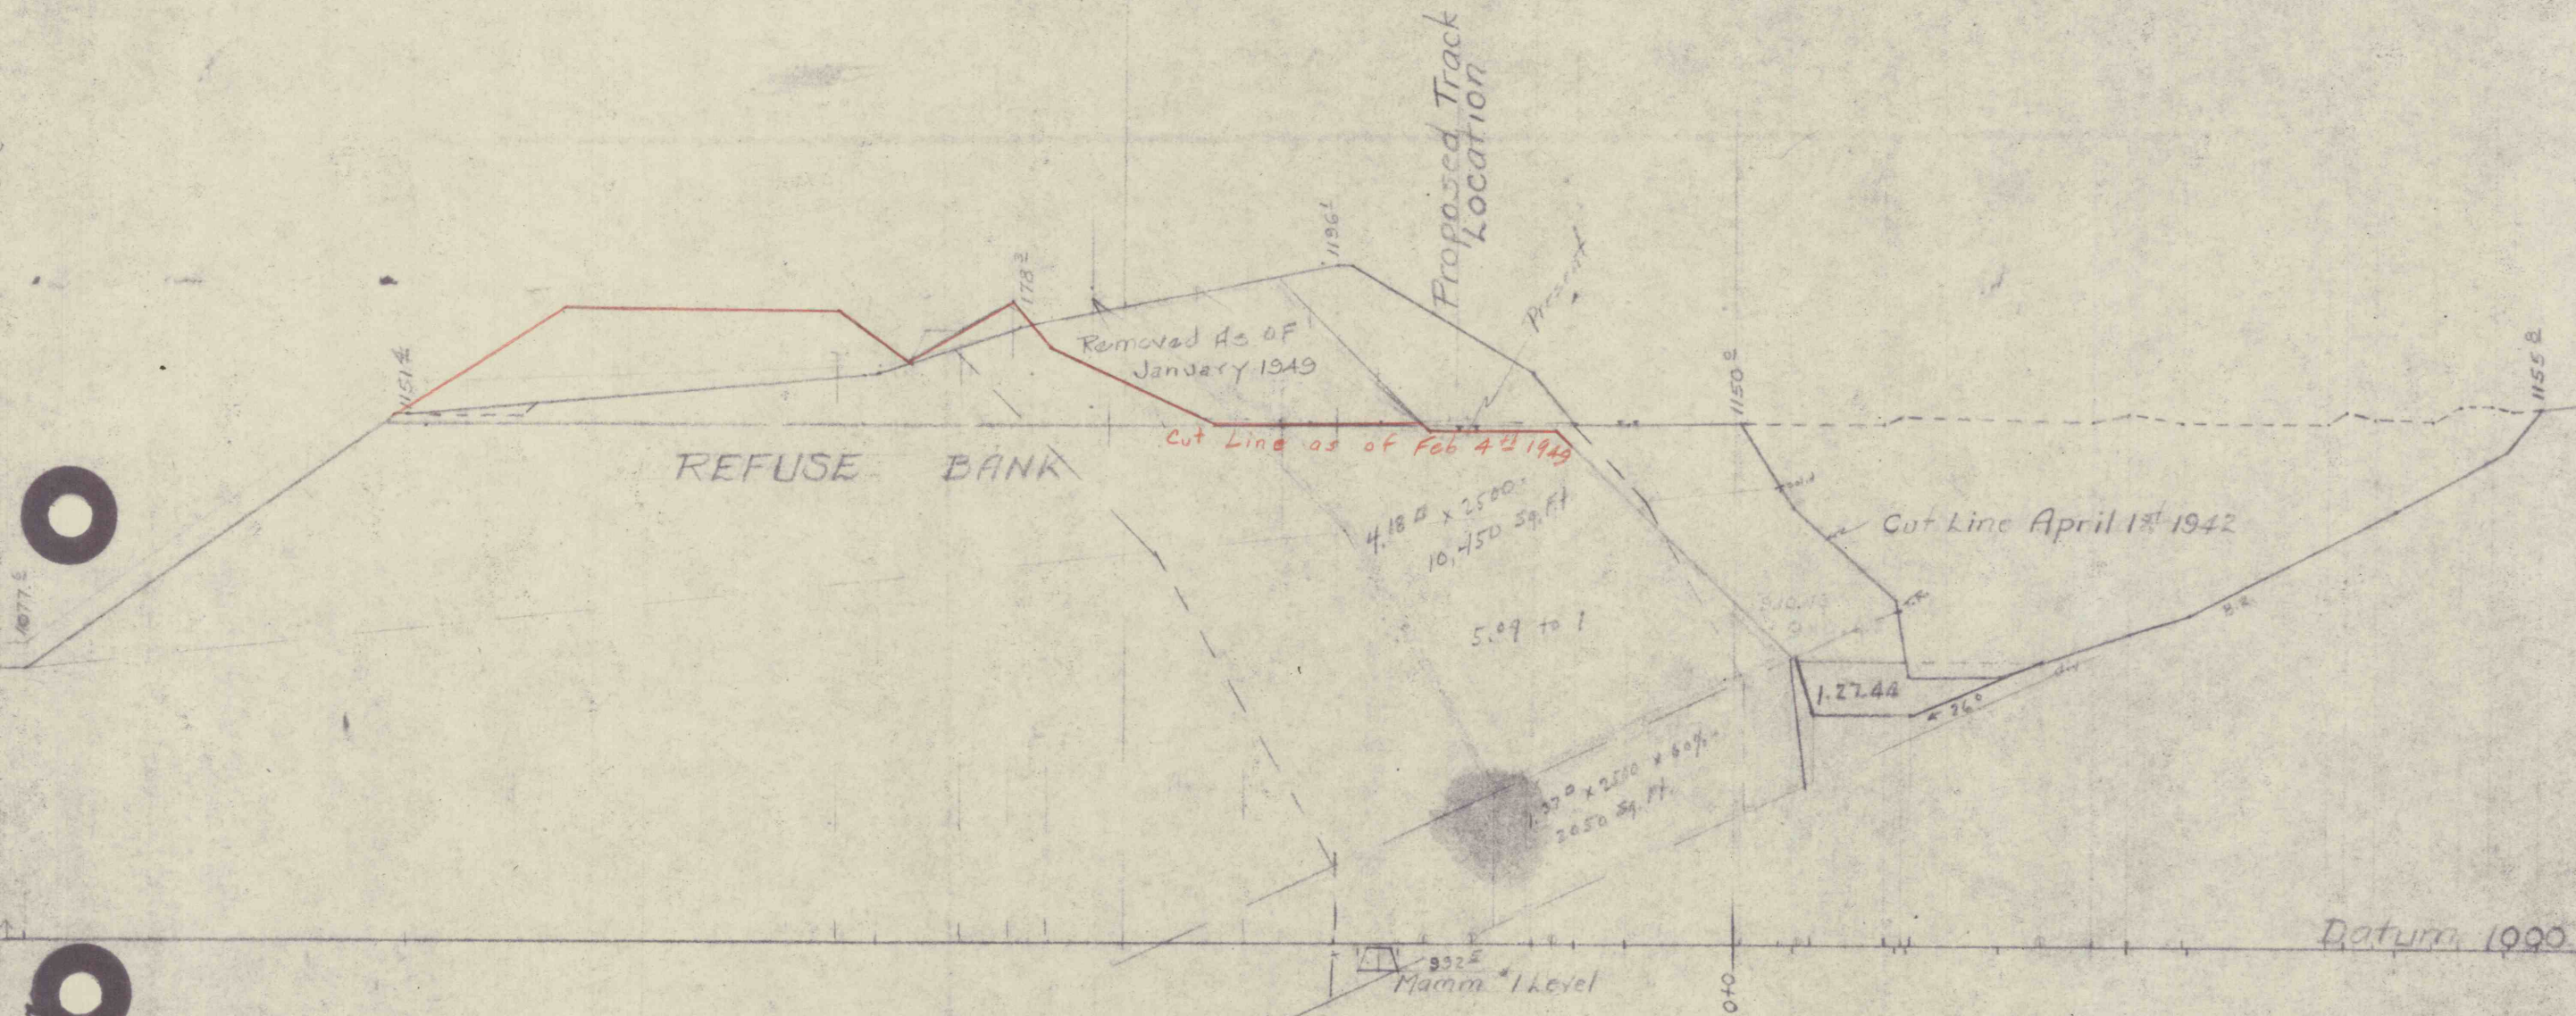

SECTION 2+00 EAST

350 Feet East of Packer #4 Gunboat Slope

Scale 50' = 1" - April 7, 1942 - Engr. Dept. L.C.Co.