


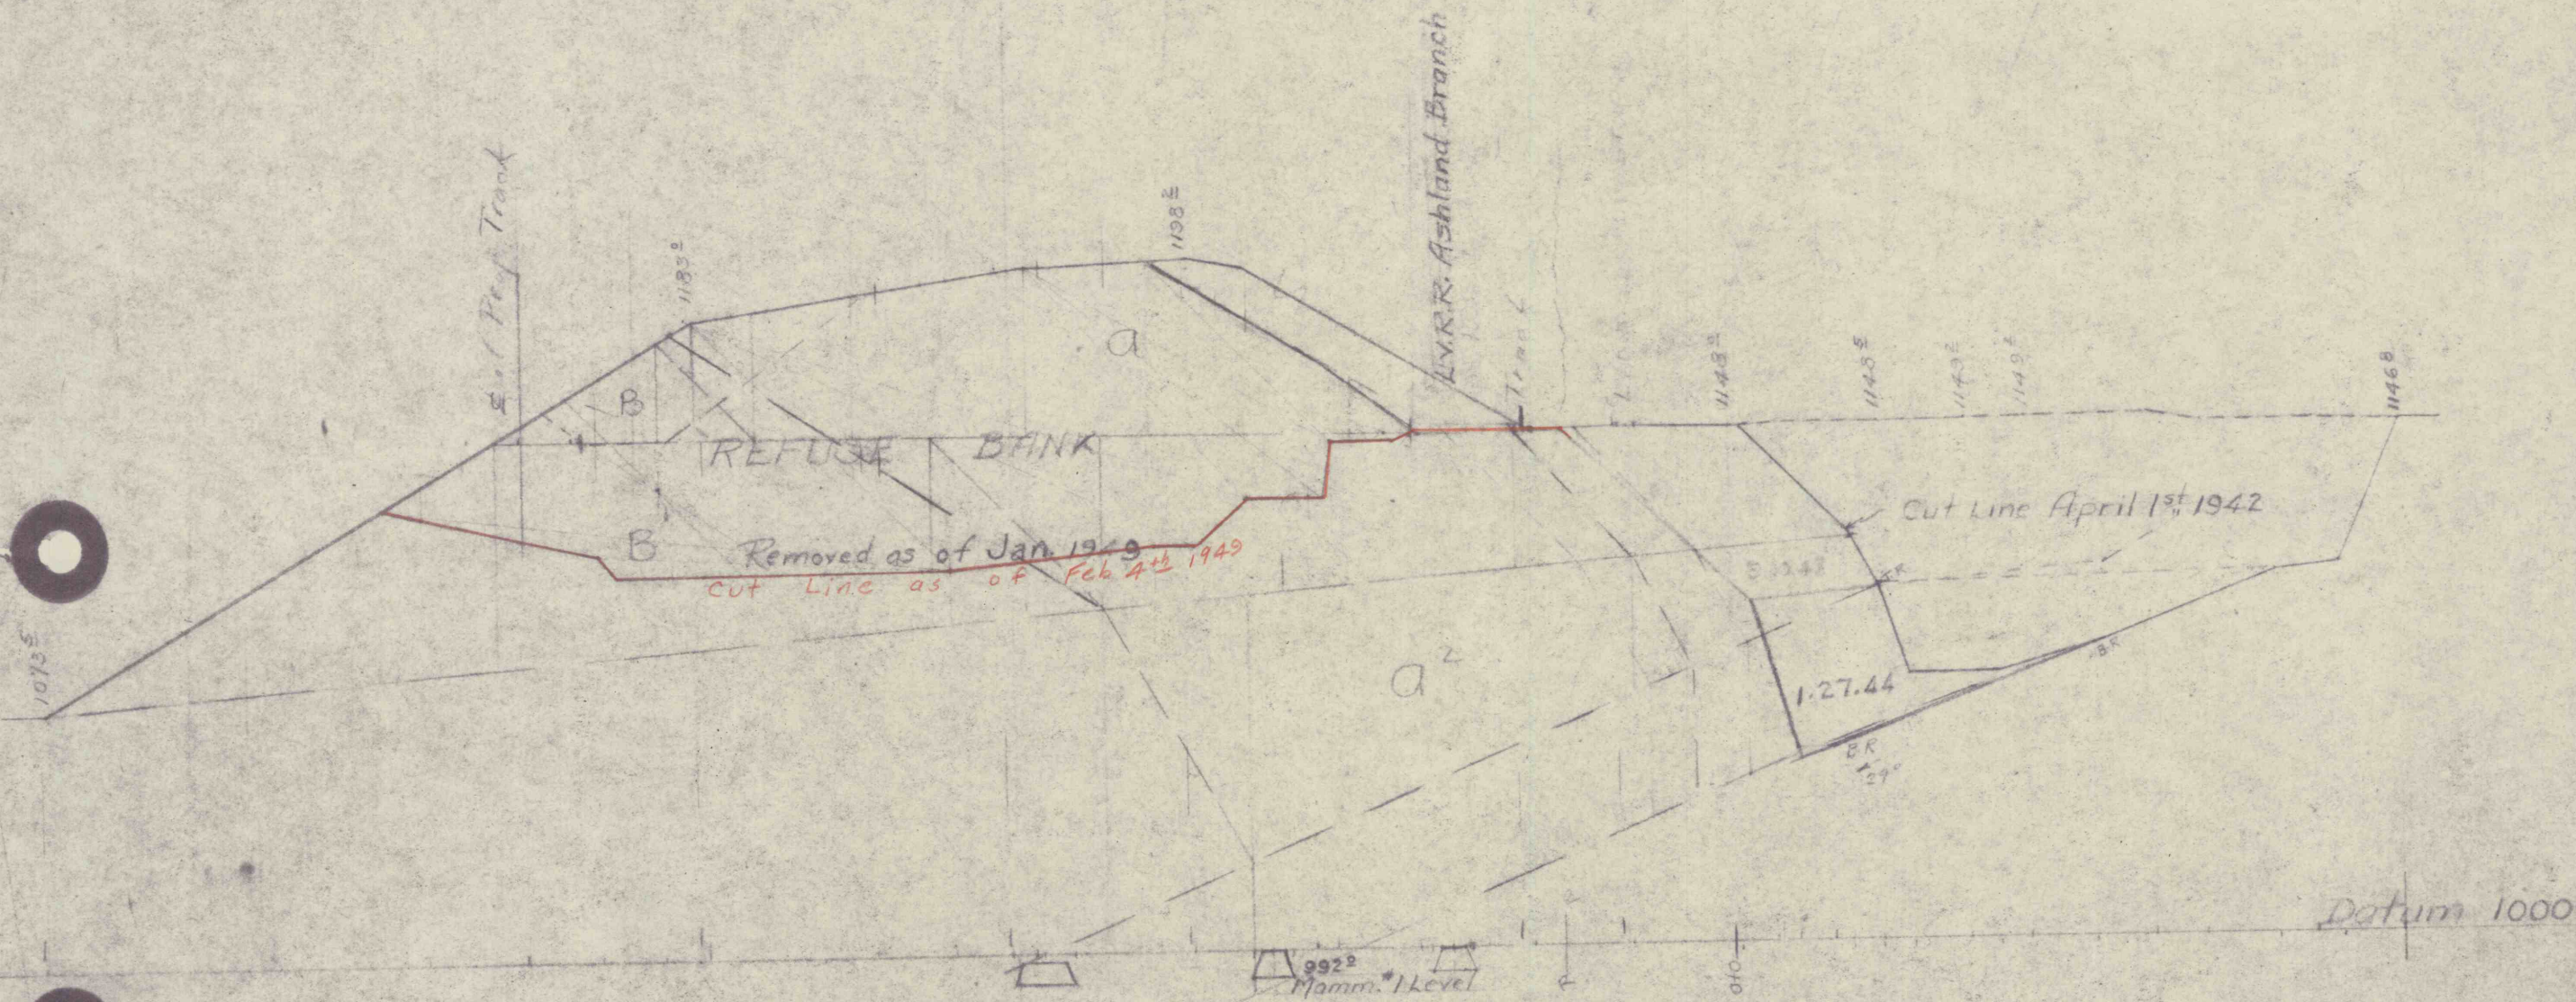

SECTION 0+00 EAST
130 Feet East of Packer #4 Gunboat Slope
Scale 50' = 1" - April 7, 1942 - Engr. Dept. L.C.Co.