


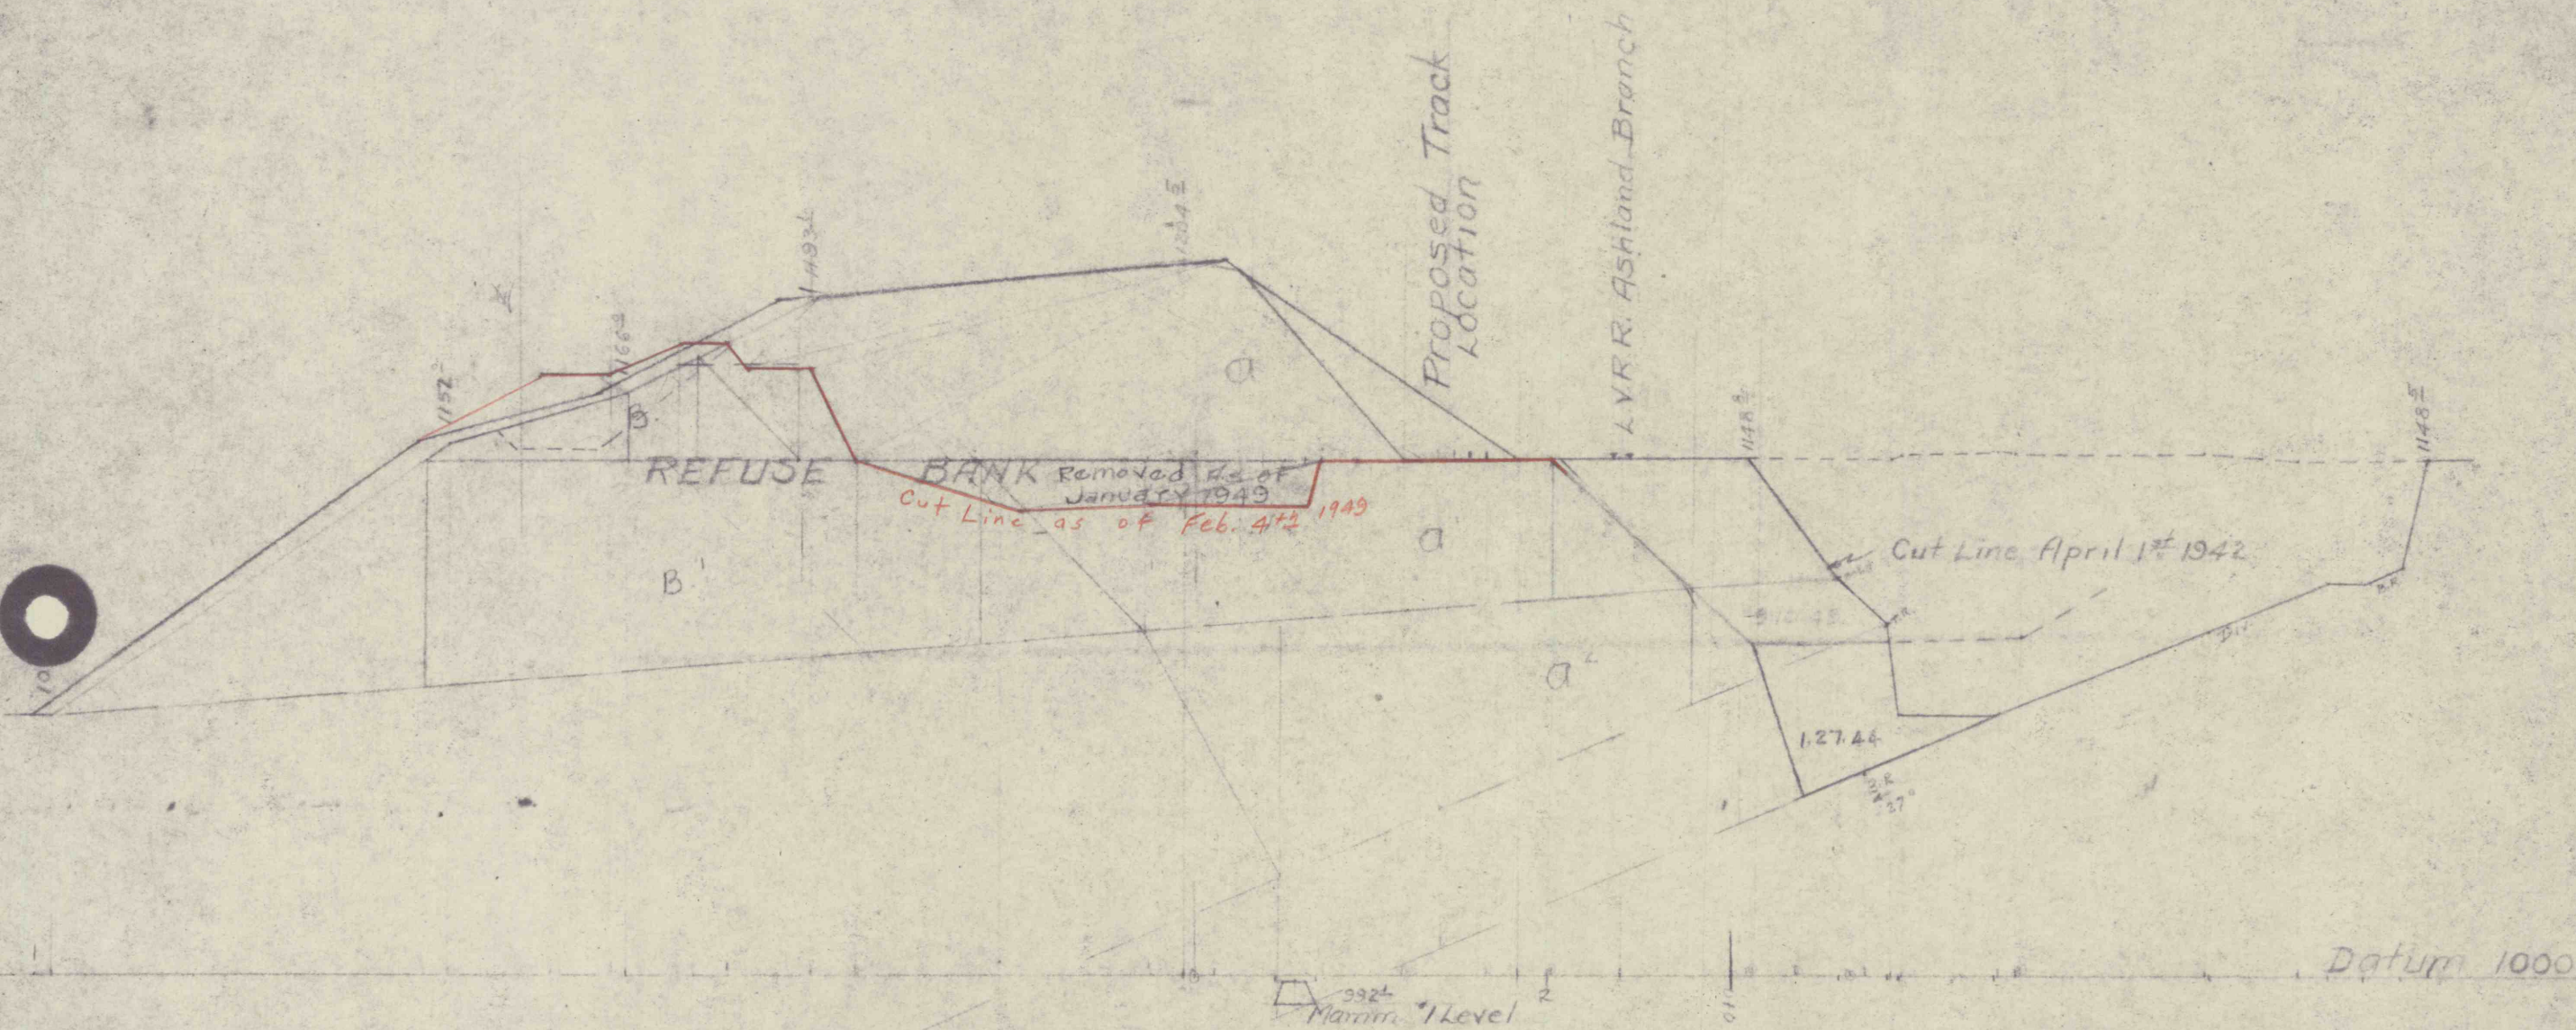

SECTION 1+00 EAST

250 Feet East of Packer #4 Gunboat Slope

Scale 50' = 1" - April 7, 1942 - Engr. Dept. L. C. Co.

8945
Mamm. 2 level