


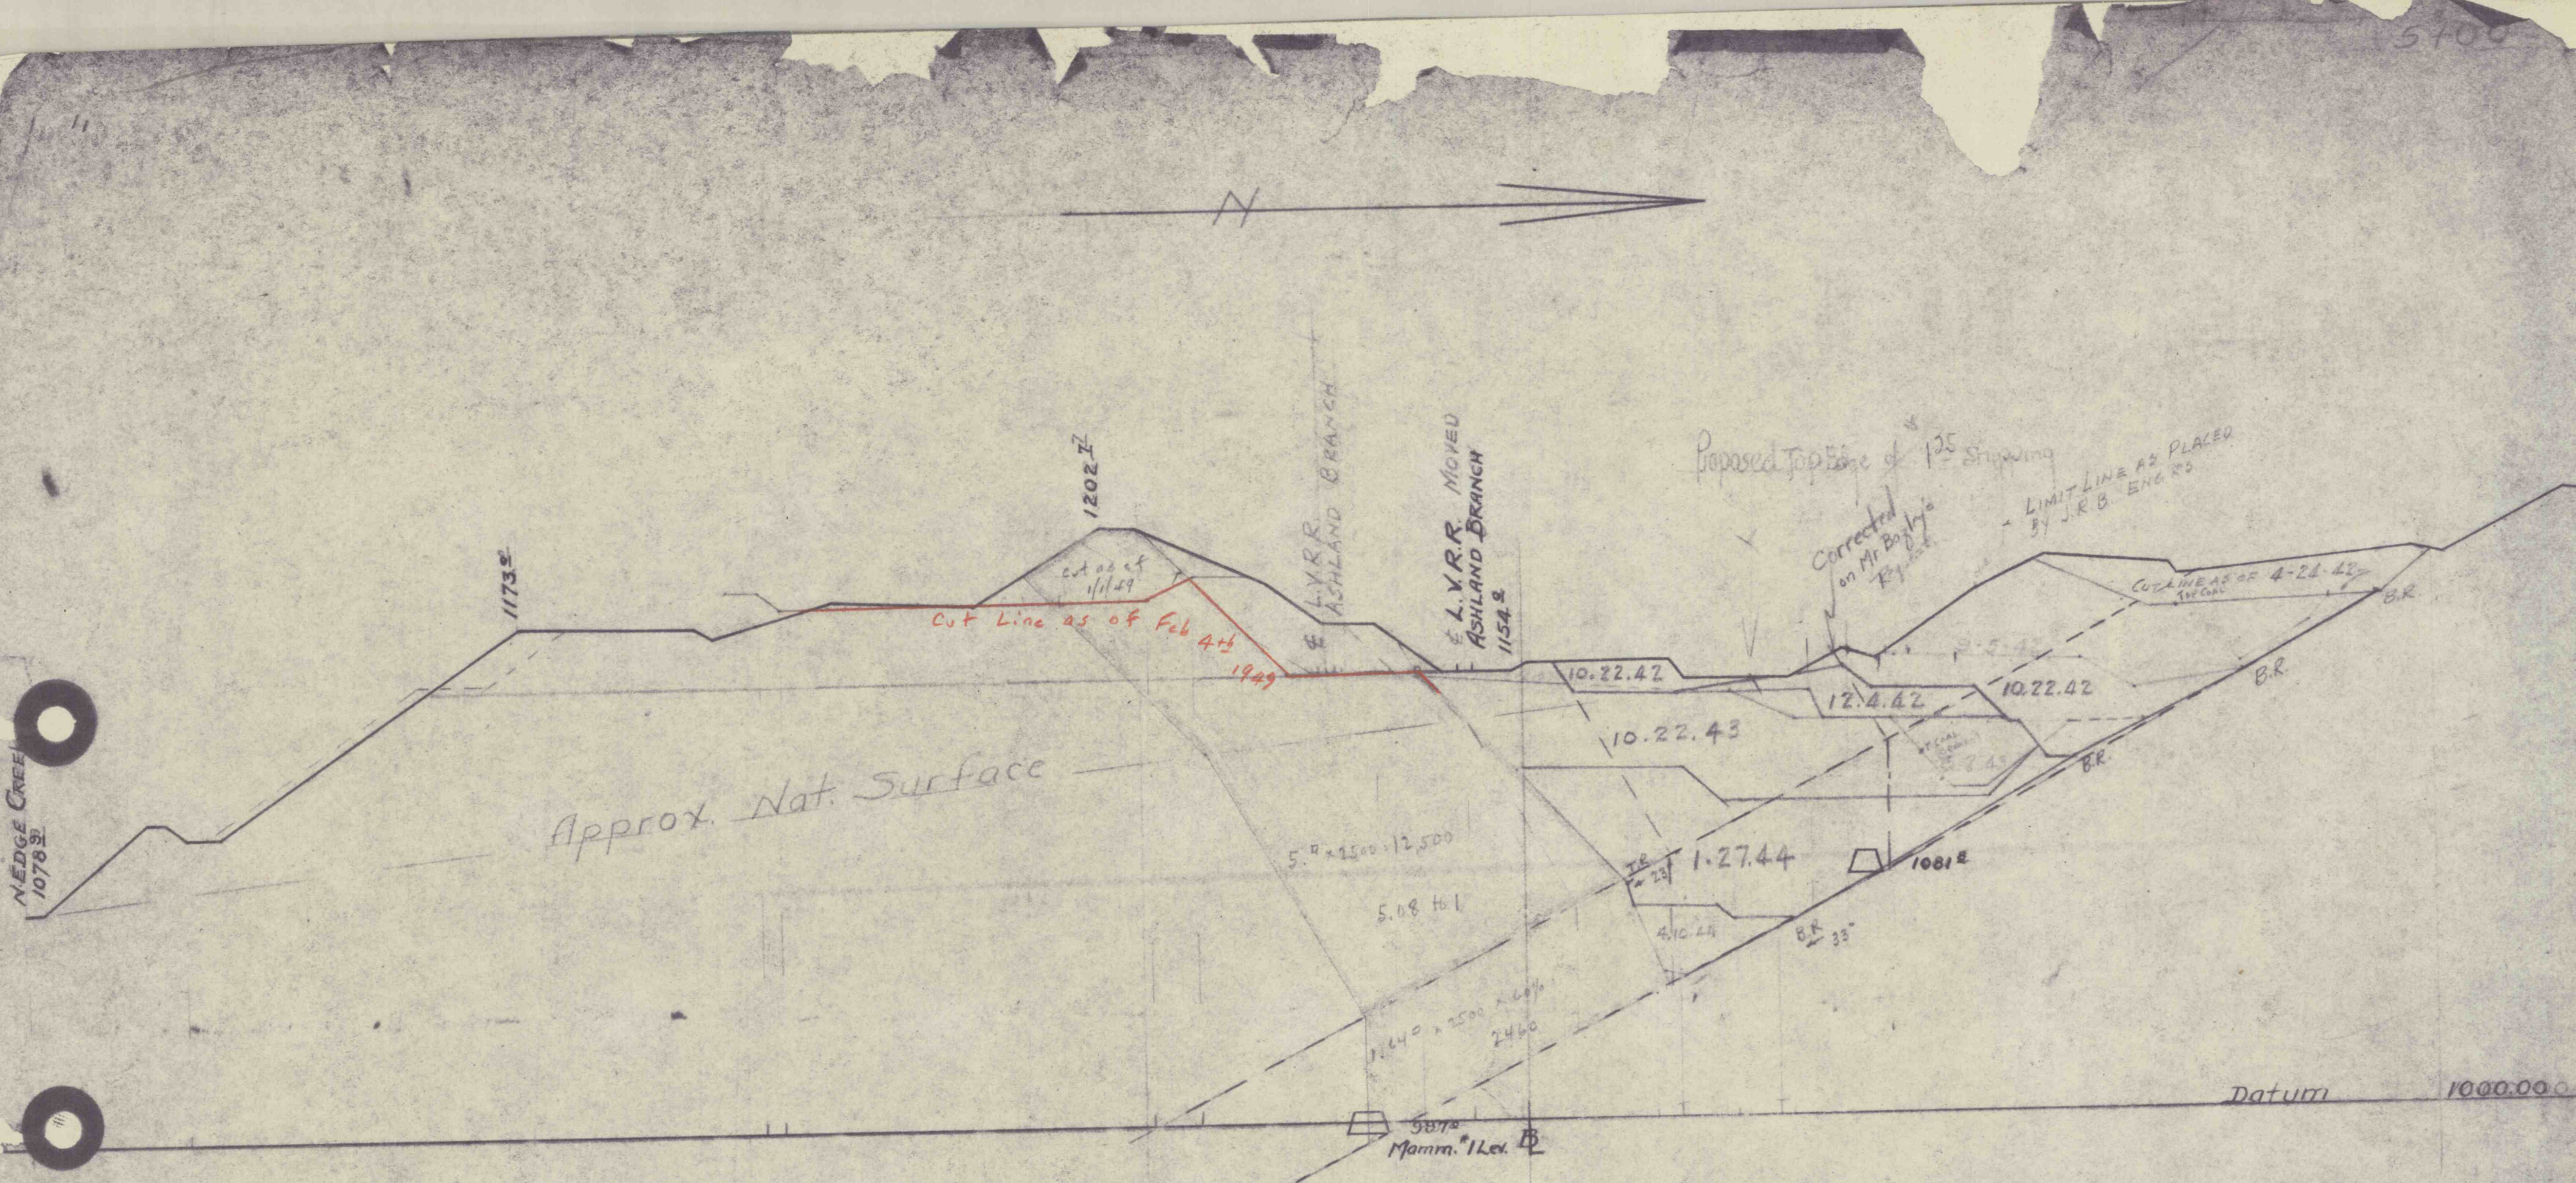

SECTION 5+00 EAST
650 Feet East of Packer #4 Gunboat Slope
Scale 50' = 1" - May 12, 1942 - Eng. Dept. L.C.Co.