


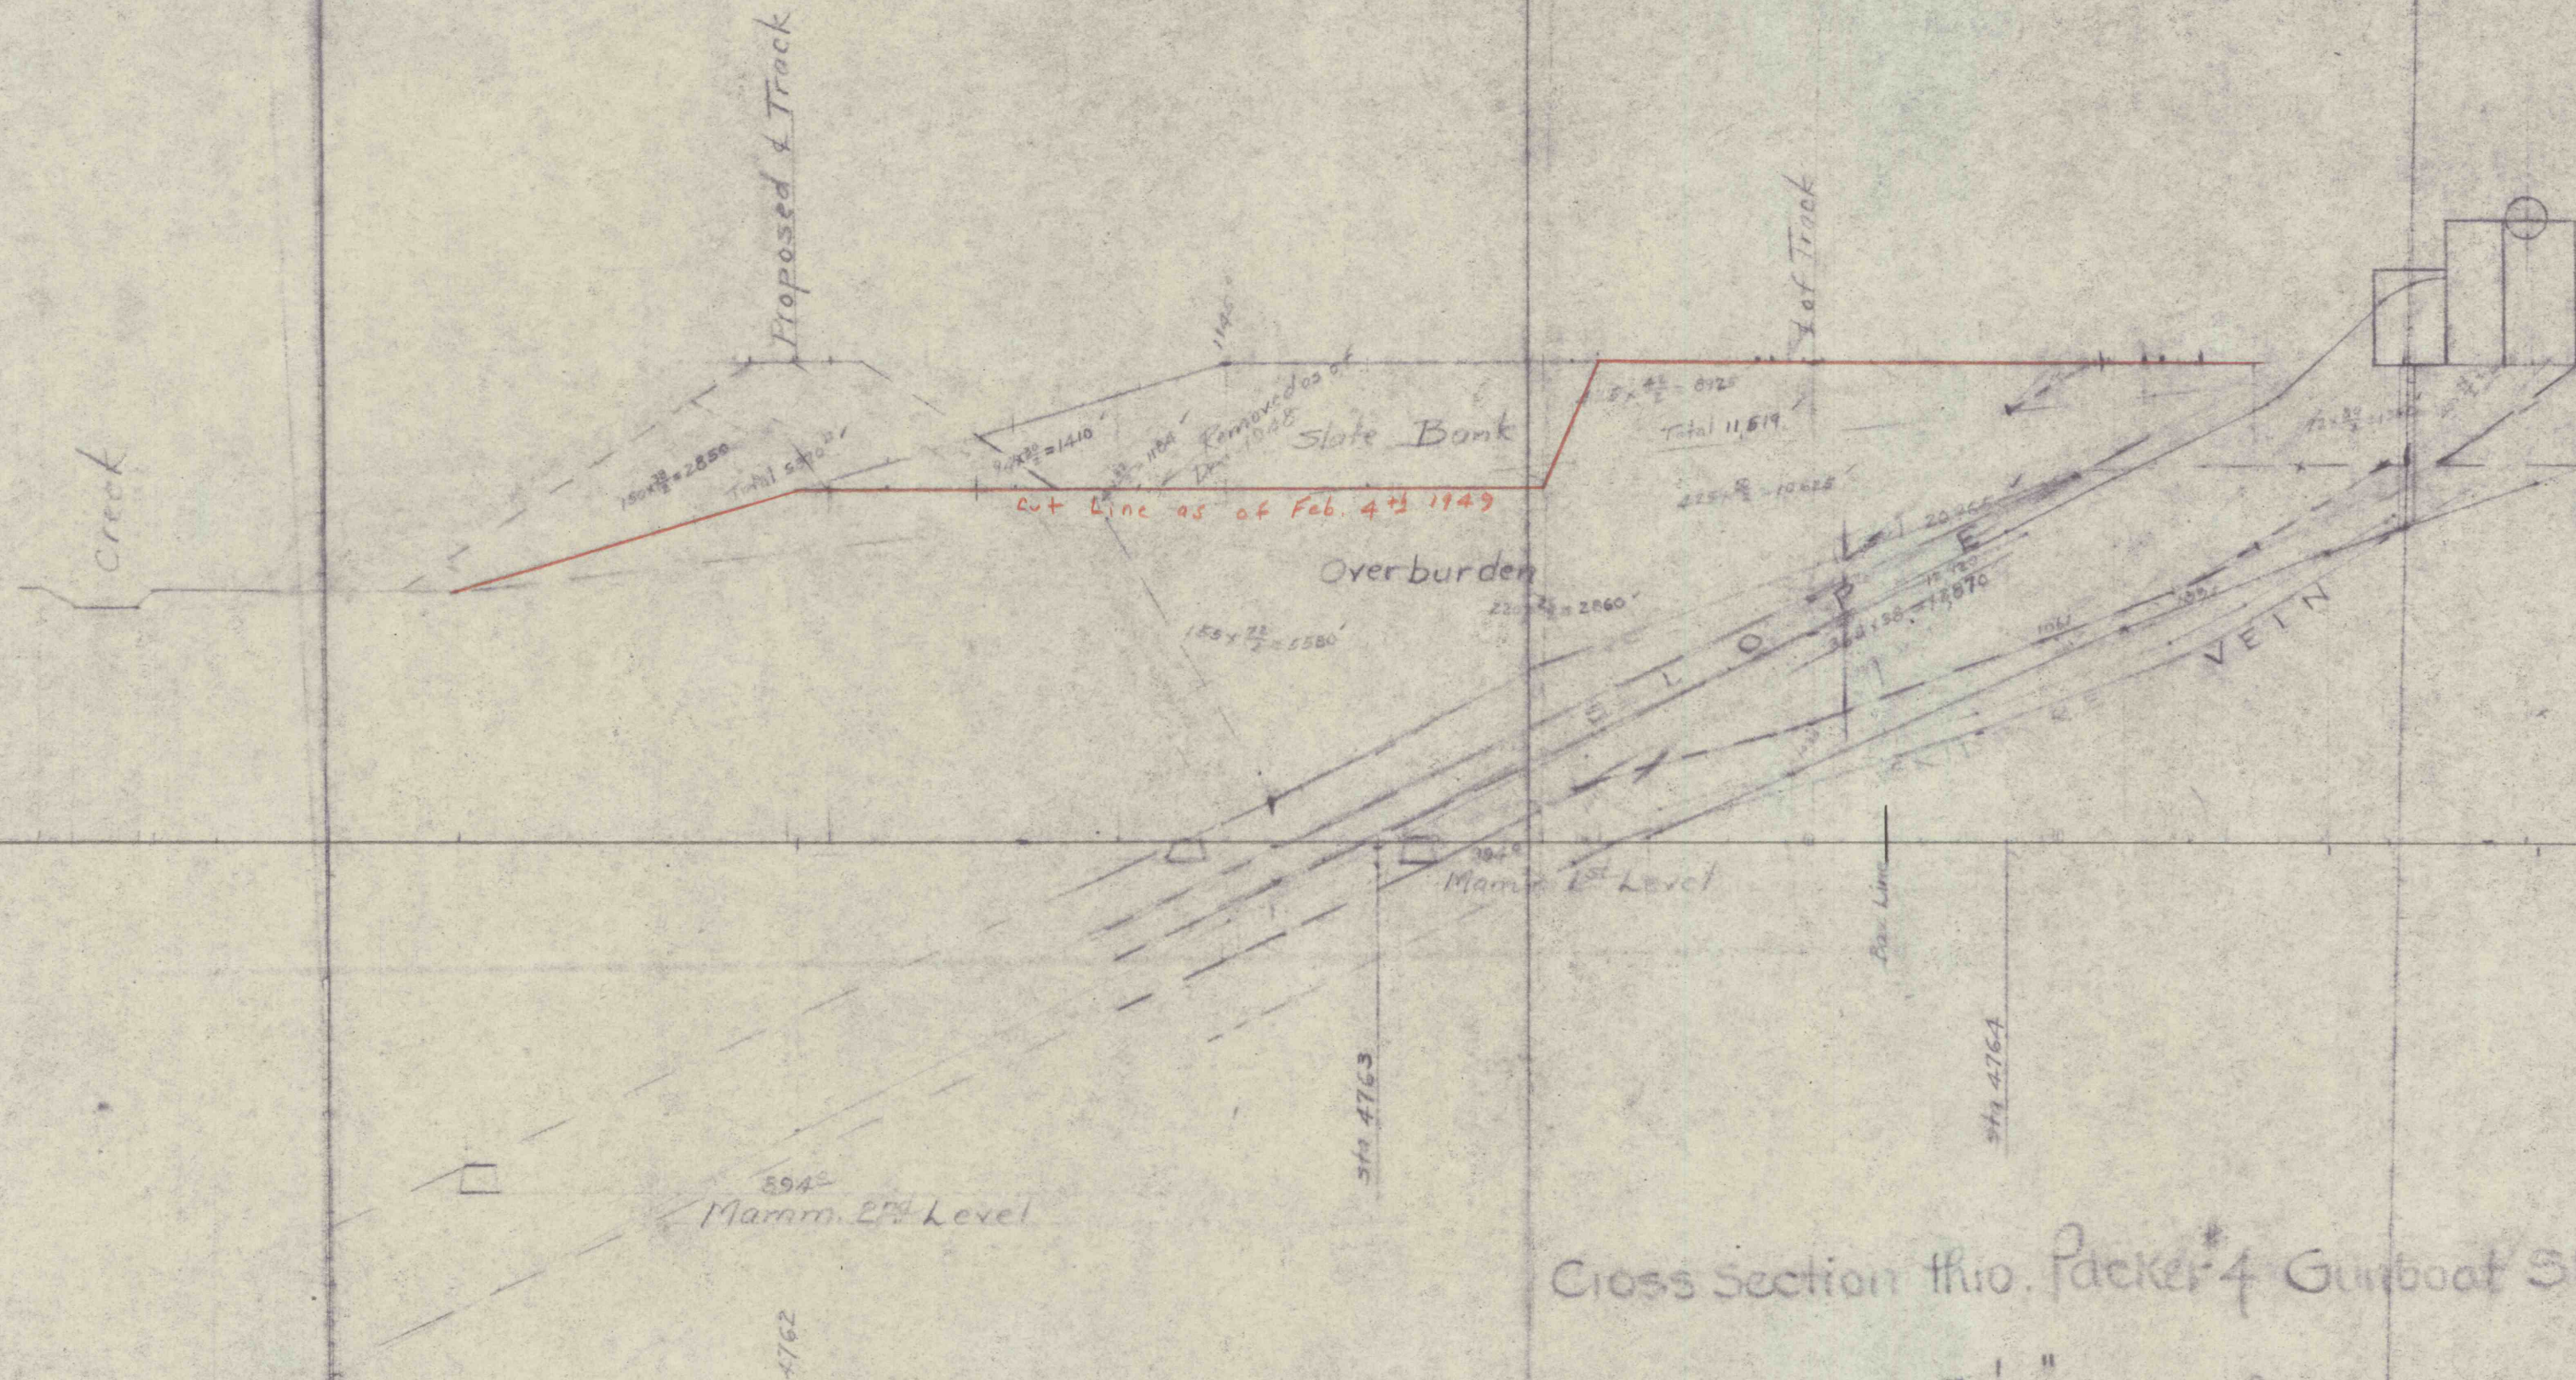

Cross Section thro. Packer #4 Gunboat Slope

Scale 50' = 1" — Dec. 18, 1947

Scale 1" = 50'

Dec. 18th 1947

1430W

Section 1430W