


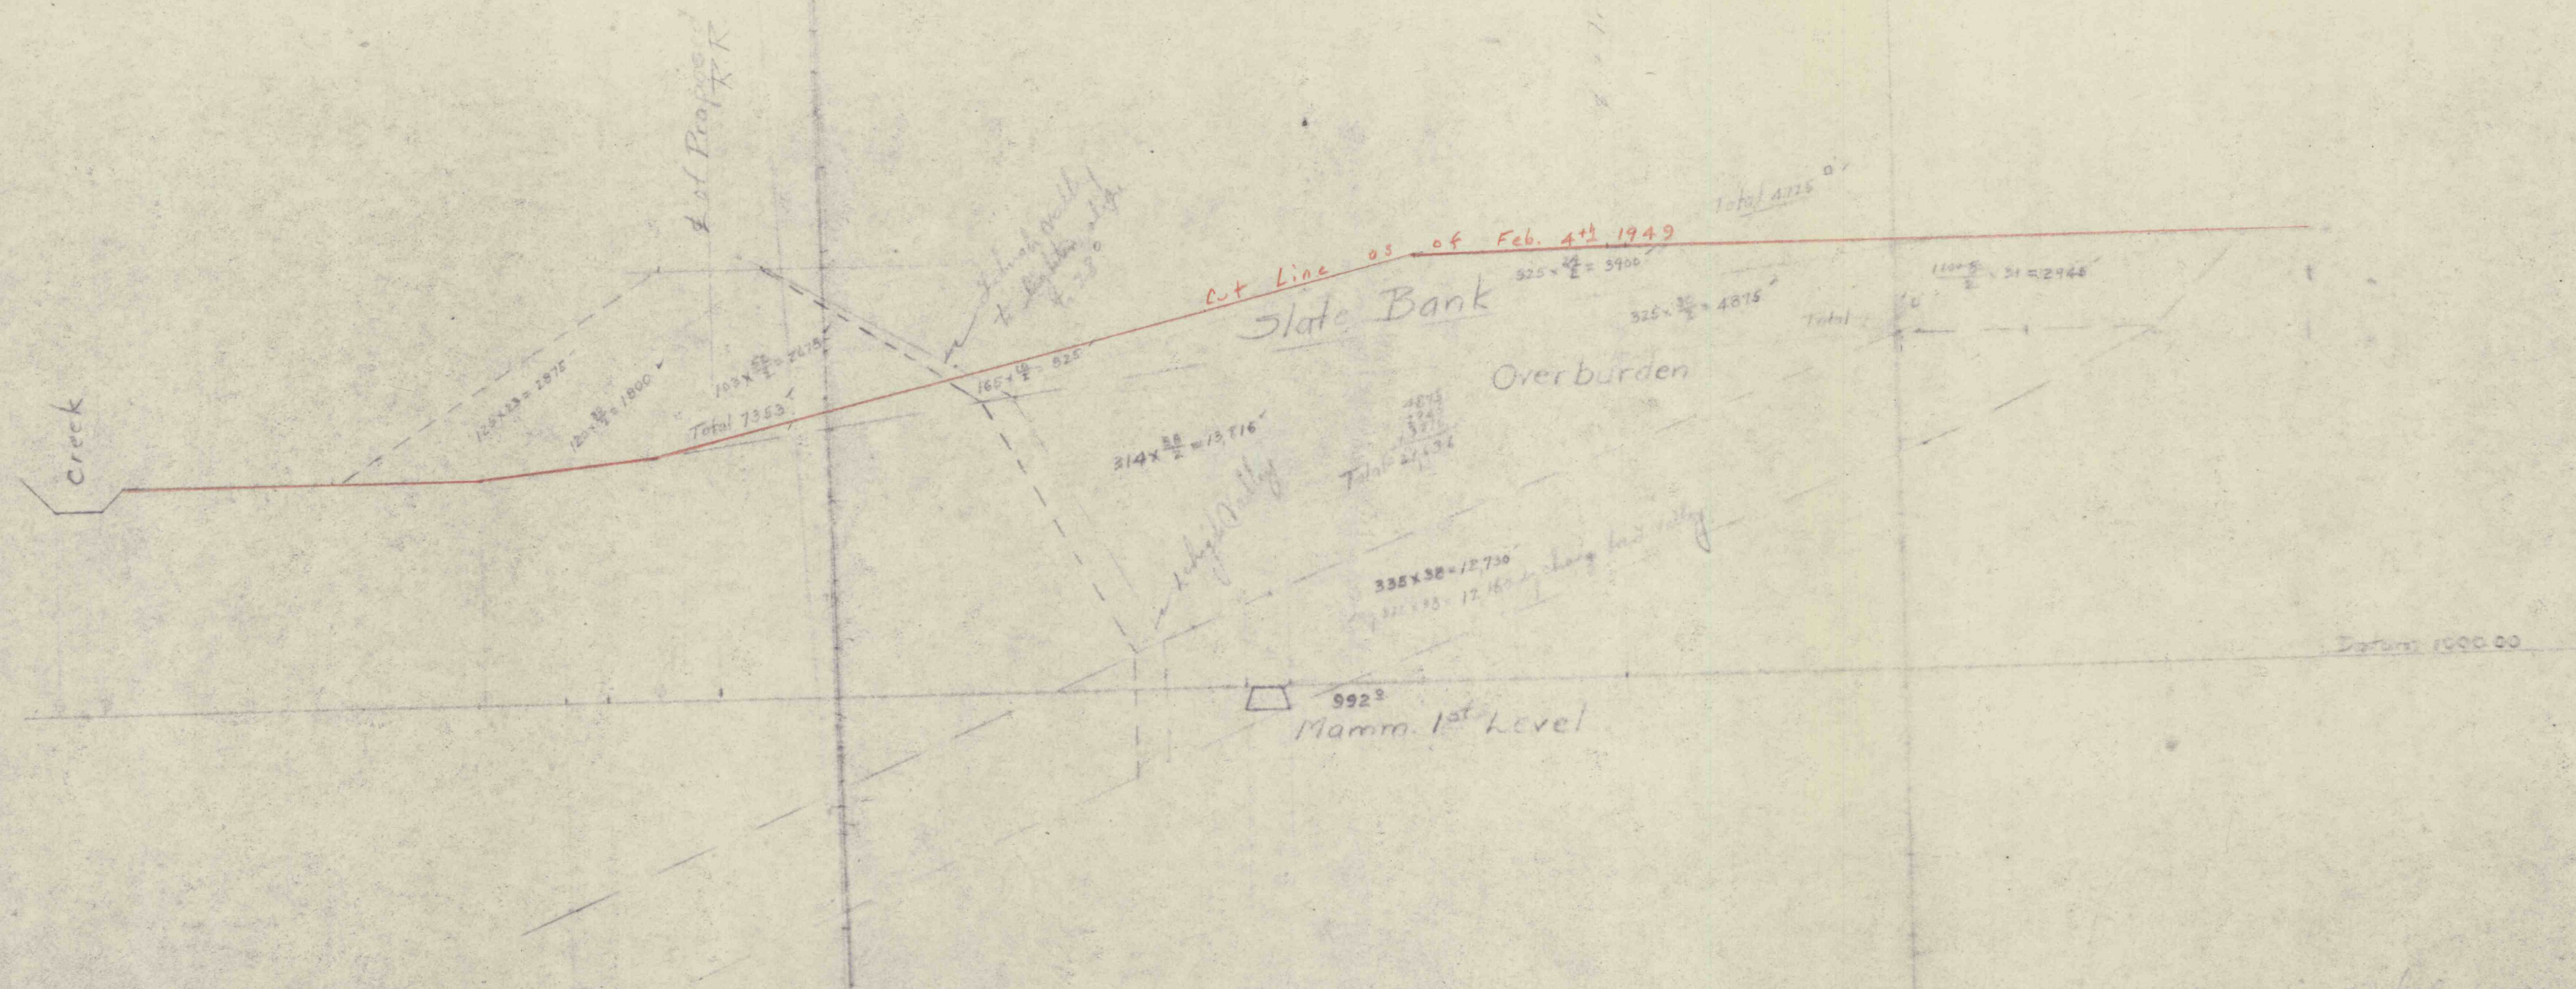

Section 150 ft west of Pth Main Hoisting Slope

Scale 1" = 50'

Dec. 18th 1947

2180W

m Sec 2180W