


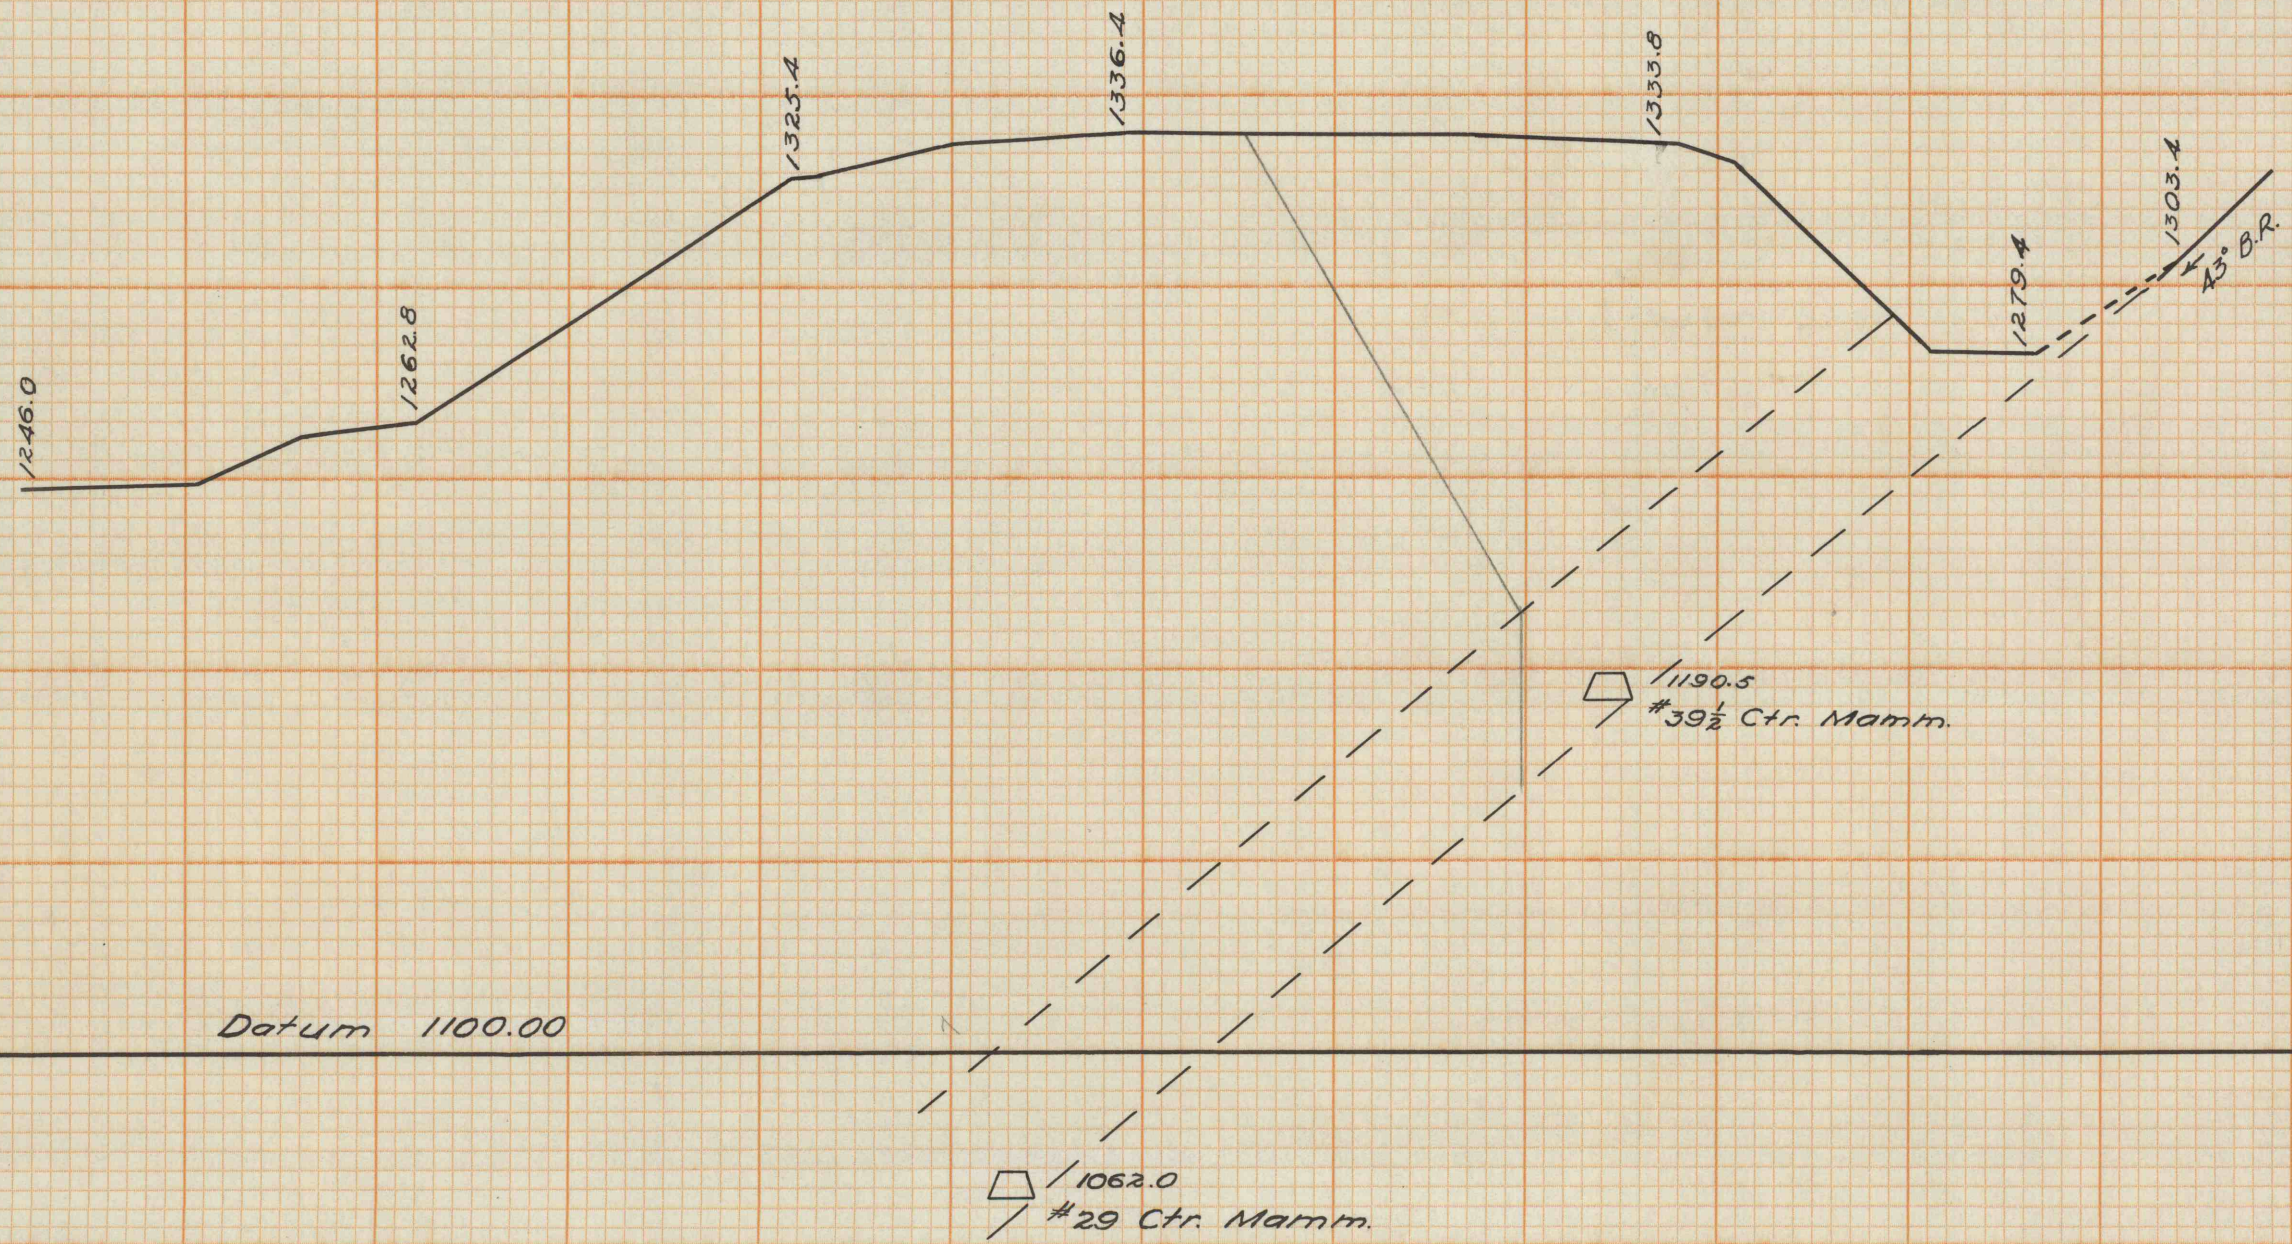

J. ROBERT BAZLEY, Inc.			
POTTSVILLE, PENNA.			
PACKER No 3			
WEST OF 7 FT. SL.			
SEC. 15+00			
DATE	SCALE	BY	
6-2-44	50' = 1"		