


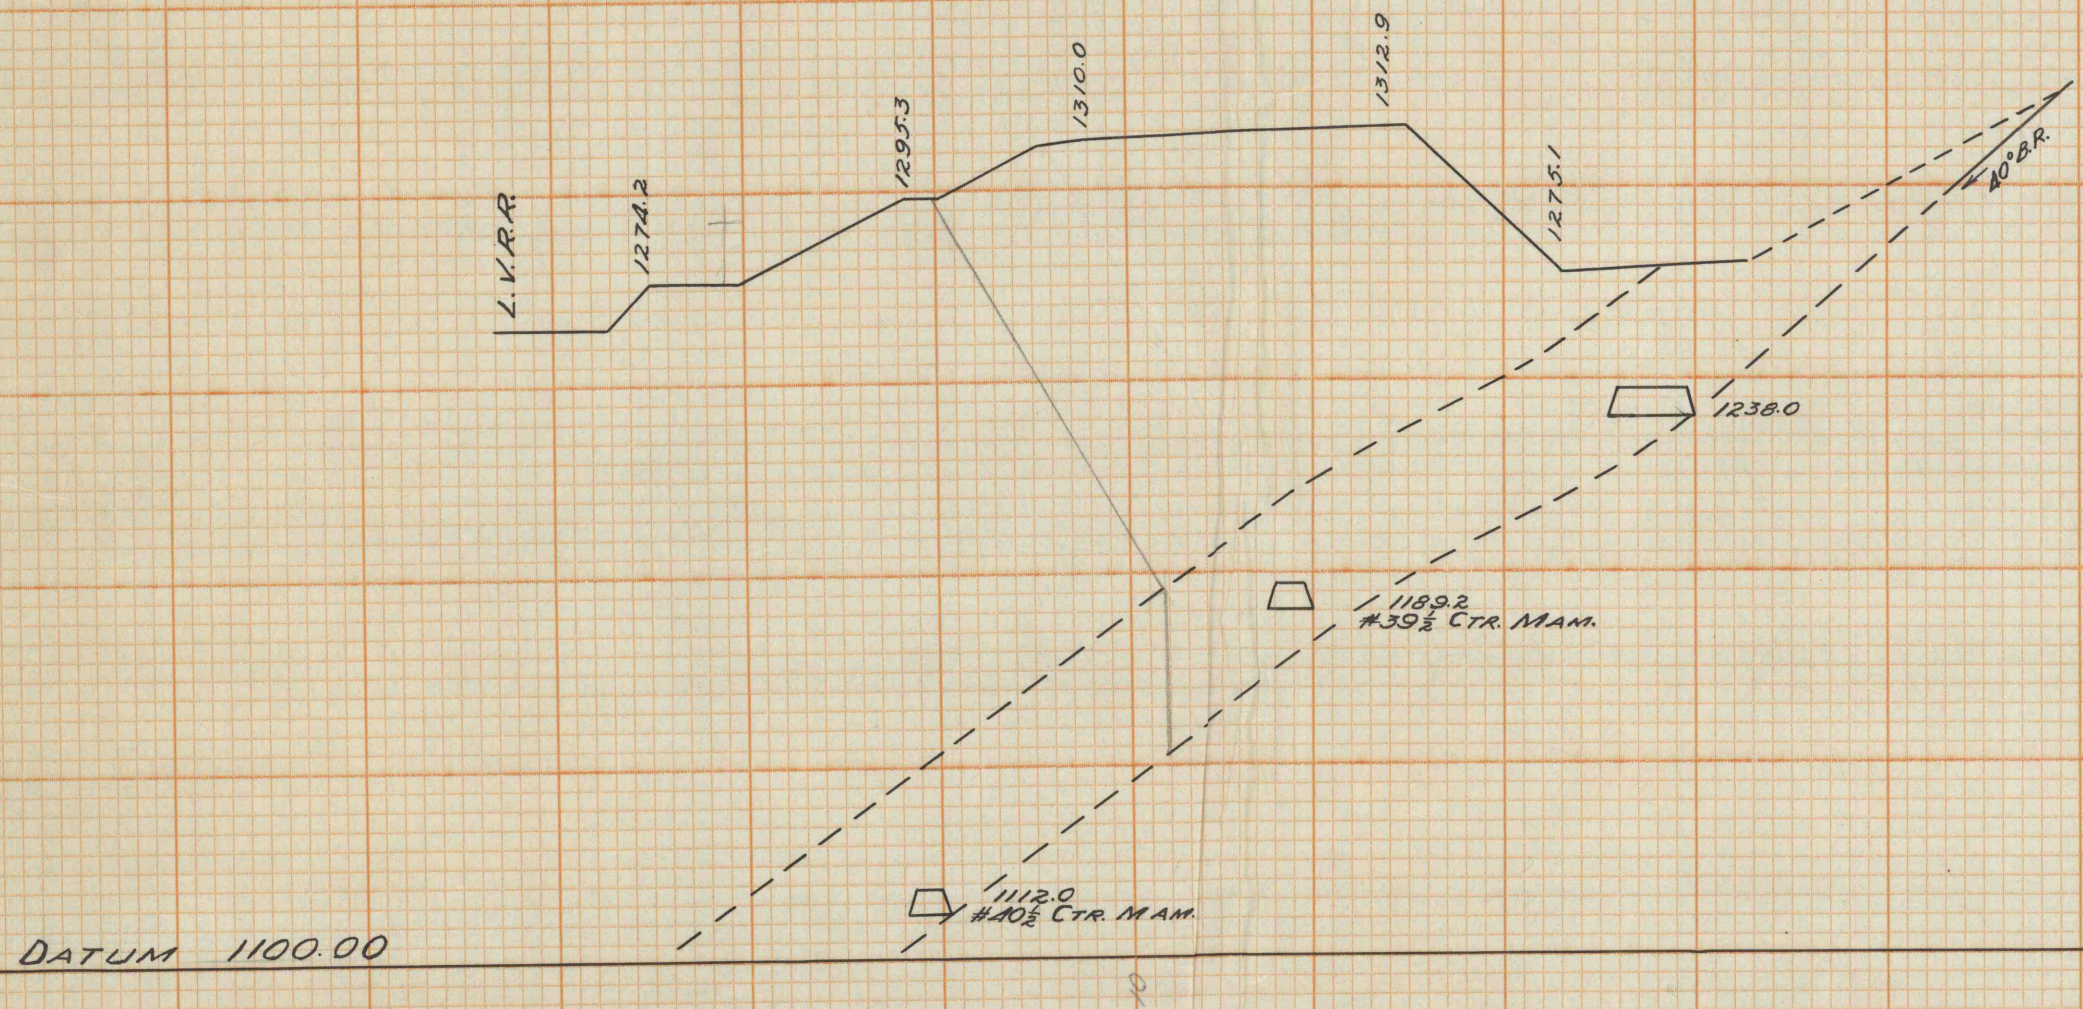

J. ROBERT BAZLEY, Inc.
POTTSVILLE, PENNA.
PACKER N^o 3
WEST OF 7 FT. SL.
SEC. 21+00
DATE 6-21-44 SCALE 50' = 1" BY