


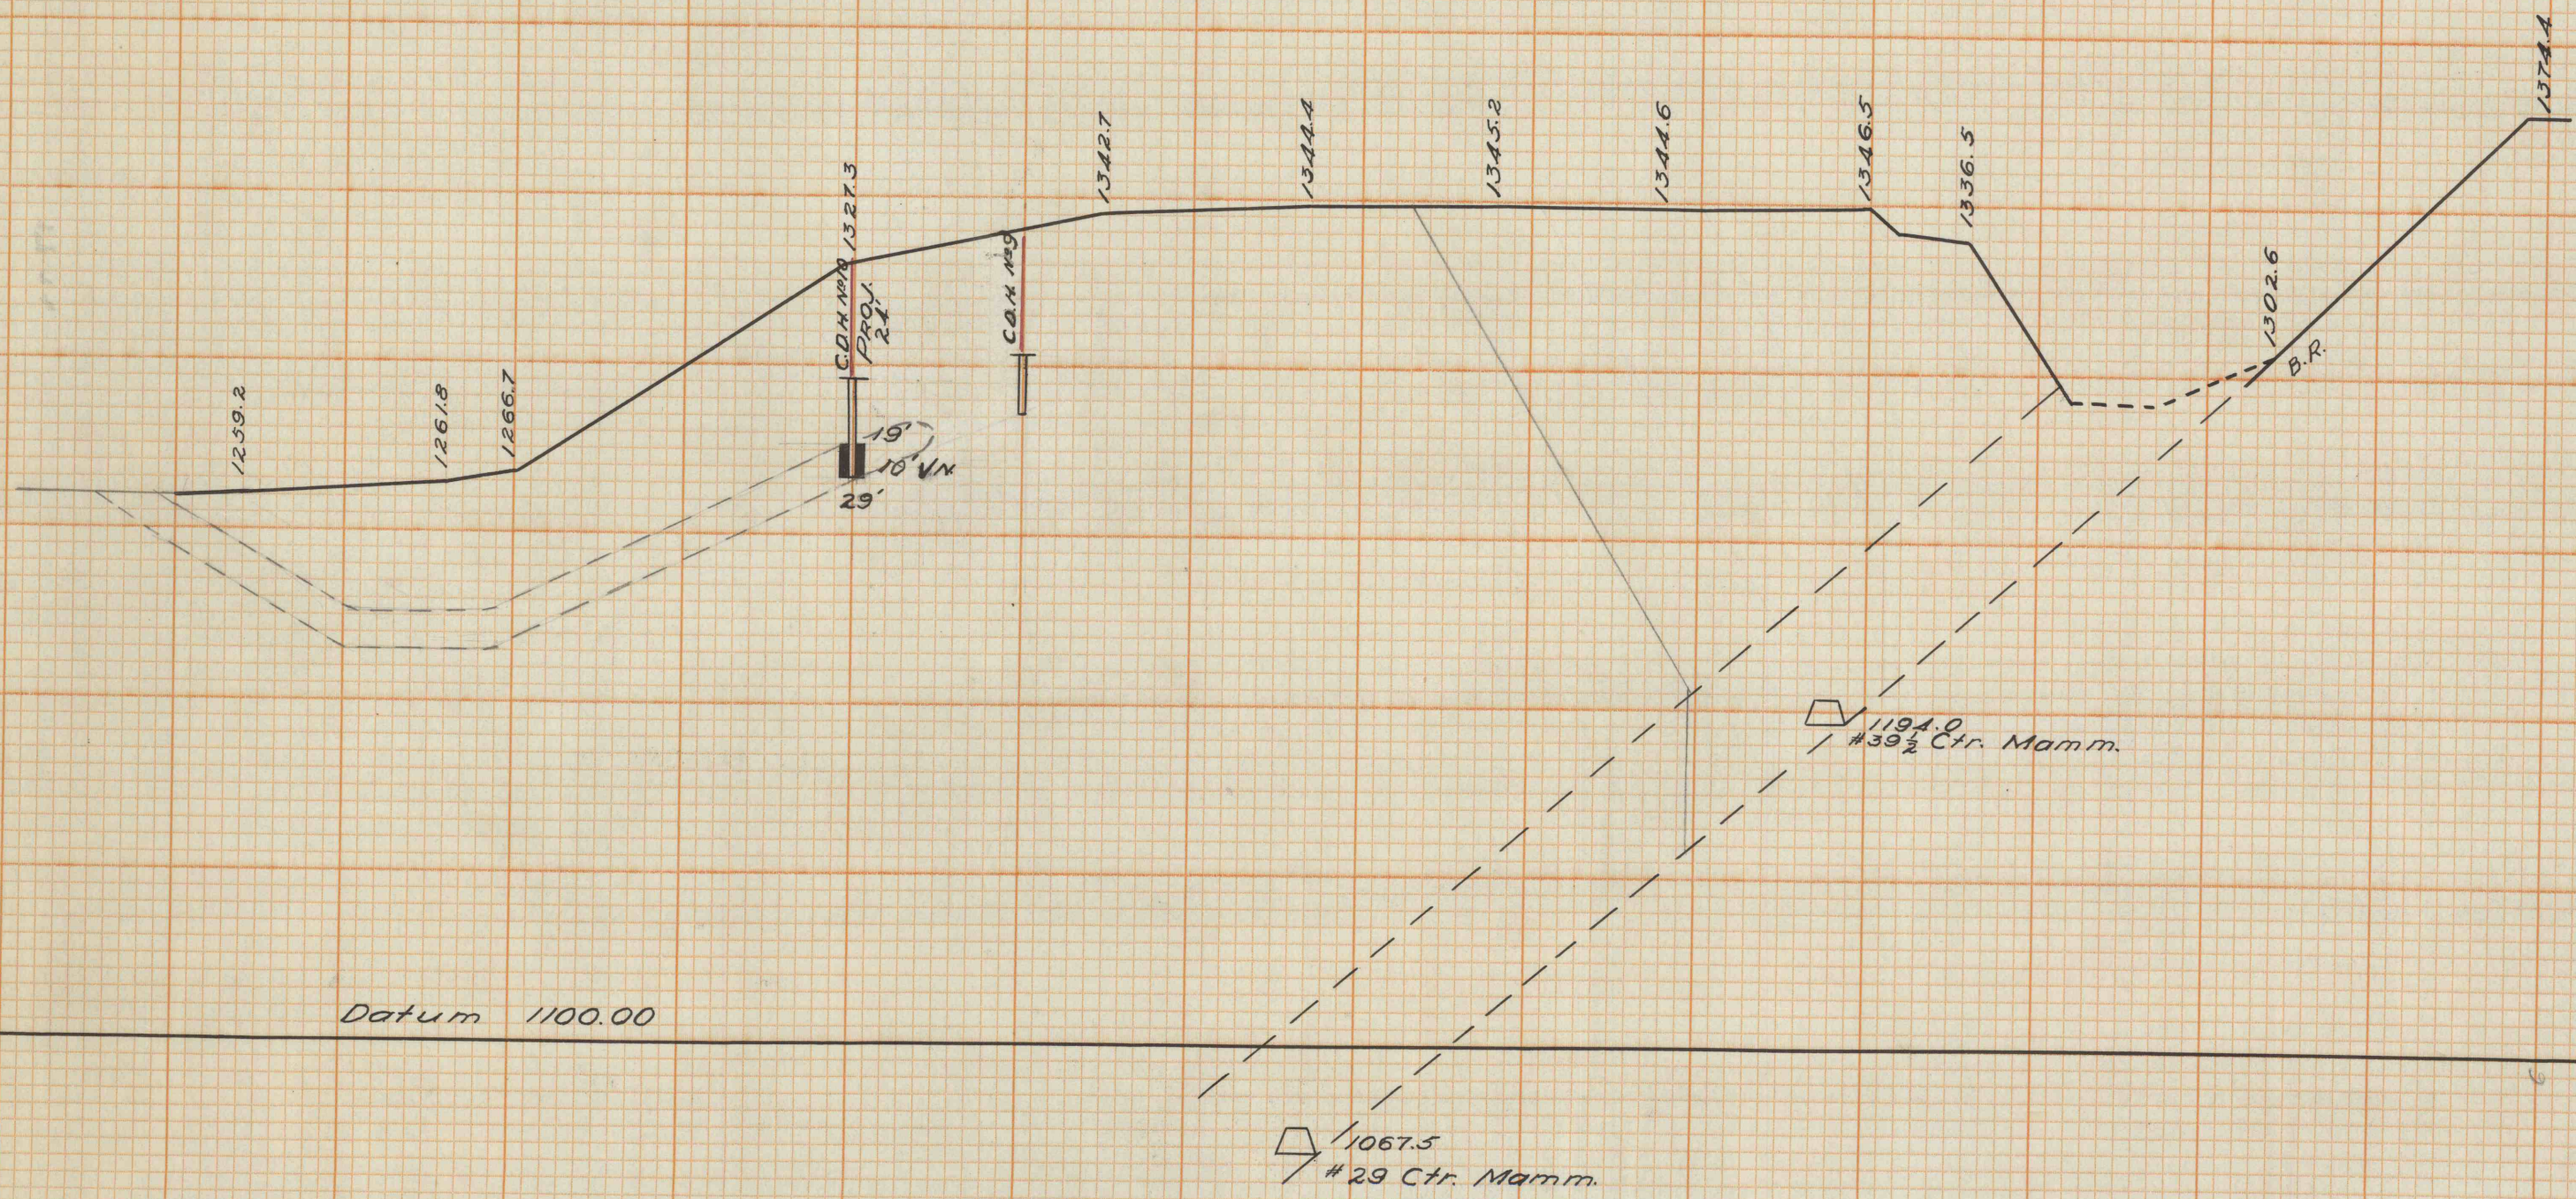

Datum 1100.00

|                        |        |    |  |
|------------------------|--------|----|--|
| J. ROBERT BAZLEY, Inc. |        |    |  |
| POTTSVILLE, PENNA.     |        |    |  |
| PACKER No. 3           |        |    |  |
| WEST OF 7 FT. SL.      |        |    |  |
| SEC. 13+00             |        |    |  |
| DATE                   | SCALE  | BY |  |
| 6-21-44                | 50'=1" |    |  |